

MARYLAND DEPARTMENT OF THE ENVIRONMENT, WATER MANAGEMENT ADMINISTRATION
 2500 BROENING HIGHWAY, BALTIMORE, MARYLAND 21224, (410) 631-3784

 WATER WELL ABANDONMENT-SEALING REPORT FORM

SUBMIT COPIES OF COMPLETED FORM TO:

- * COUNTY ENVIRONMENT AGENCY (contact MDE, WMA if address needed)
- * WELL OWNER
- * MDE, WATER MANAGEMENT ADMINISTRATION, WELL PROGRAM

DATE WELL ABANDONED: July 22 2005 (month/day/year)

OK
 9/15/10sc

* PERMIT NUMBER OF ABANDONED WELL (if any) WA - -

* PERMIT NUMBER OF REPLACEMENT WELL WA - -


* PERSON ABANDONING WELL: Ray E. Wayne

WELL DRILLERS LICENSE NUMBER: 117

* OWNER'S NAME: Trinity Builders

CIRCLE: MWD/MSD/MGD

* WELL LOCATION:
 COUNTY: Howard
 NEAREST TOWN: Ellicott City
 TAX MAP _____ BLOCK _____ PARCEL _____
 SUBDIVISION: NA
 SECTION: NA LOT: NA
 NEAREST ROAD: 4028 Owen Look Dr.

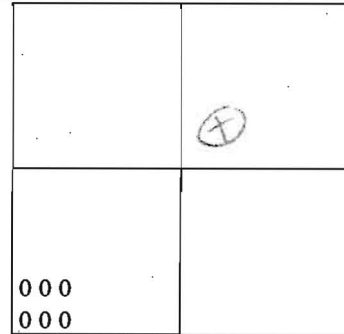

SHOW WELL LOCATION BY X WITHIN BOX

MARYLAND GRID COORDINATES

BOX NUMBER
 E 520
 N 850

* TYPE OF WELL BEING ABANDONED:

- DRILLED
- BORED/AUGURED
- OTHER (specify) _____
- JETTED
- HAND DUG

* USE CODE:

- DOMESTIC
- IRRIGATION
- TEST/OBSERVATION
- MUNICIPAL/PUBLIC
- INDUSTRIAL

* TYPE OF CASING:

- STEEL
- CONCRETE
- PLASTIC
- OTHER (specify) _____

* SIZE OF CASING: 6" INCHES IN DIAMETER

* DEPTH OF WELL: 65 FEET DEEP

* WAS ANY CASING REMOVED? YES NO
 if yes, length removed, in feet: _____

* WAS CASING RIPPED OR PERFORATED? YES NO

LOG OF SEALING MATERIAL

MATERIAL	FEET	
	FROM	TO
<u>Cement</u>	<u>65</u>	<u>0</u>

MARYLAND DEPARTMENT OF THE ENVIRONMENT, WATER MANAGEMENT ADMINISTRATION
 2500 BROENING HIGHWAY, BALTIMORE, MARYLAND 21224, (410) 631-3784

 WATER WELL ABANDONMENT-SEALING REPORT FORM

SUBMIT COPIES OF COMPLETED FORM TO:

- * COUNTY ENVIRONMENT AGENCY (contact MDE, WMA if address needed)
- * WELL OWNER
- * MDE, WATER MANAGEMENT ADMINISTRATION, WELL PROGRAM

OK
 9/15/16 SC

DATE WELL ABANDONED: July 22 2005 (month/day/year)

* PERMIT NUMBER OF ABANDONED WELL (if any) WA - -

* PERMIT NUMBER OF REPLACEMENT WELL WA - -

* PERSON ABANDONING WELL: Ralph E. Mayne

WELL DRILLERS LICENSE NUMBER: 117

CIRCLE: MWD/MSD/MGD

* OWNER'S NAME: Timothy B. Lewis

* WELL LOCATION:
 COUNTY: Howard
 NEAREST TOWN: Ellicott City
 TAX MAP _____ BLOCK _____ PARCEL _____
 SUBDIVISION: N/A
 SECTION: NA LOT: NA
 NEAREST ROAD: 4028 Waterloo Dr.

	X
0 0 0	
0 0 0	

SHOW WELL LOCATION
 BY X WITHIN BOX

MARYLAND GRID COORDINATES

BOX NUMBER
 E 520
 N 850

* TYPE OF WELL BEING ABANDONED:

- DRILLED
- BORED/AUGURED
- OTHER (specify) _____
- JETTED
- HAND DUG

* USE CODE:

- DOMESTIC
- IRRIGATION
- TEST/OBSERVATION
- MUNICIPAL/PUBLIC
- INDUSTRIAL

* TYPE OF CASING:

- STEEL
- CONCRETE
- PLASTIC
- OTHER (specify) _____

* SIZE OF CASING: 6" INCHES IN DIAMETER

* DEPTH OF WELL: 130 FEET DEEP

* WAS ANY CASING REMOVED? YES NO
 if yes, length removed, in feet: _____

* WAS CASING RIPPED OR PERFORATED? YES NO

LOG OF SEALING MATERIAL

MATERIAL	FEET	
	FROM	TO
<u>Cement</u>	<u>130</u>	<u>0</u>