

\*\*\*\*\*  
 WATER WELL ABANDONMENT-SEALING REPORT FORM  
 \*\*\*\*\*

SUBMIT COPIES OF COMPLETED FORM TO:

- \* COUNTY ENVIRONMENT AGENCY (contact MDE, WMA if address needed)
- \* WELL OWNER
- \* MDE, WATER MANAGEMENT ADMINISTRATION, WELL PROGRAM

DATE WELL ABANDONED: 09/02/11 (month/day/year)

OK  
 9/12/11 30

\* PERMIT NUMBER OF ABANDONED WELL (if any) \_\_\_\_\_

\* PERMIT NUMBER OF REPLACEMENT WELL \_\_\_\_\_

\* PERSON ABANDONING WELL: Marshal Annette


WELL DRILLERS LICENSE NUMBER: 106

CIRCLE: MWD/MSD/MGD

\* OWNER'S NAME: Margaret M'Allister

SITE LOCATION MAP

\* WELL LOCATION:  
 COUNTY: Howard  
 NEAREST TOWN: Laurel  
 TAX MAP 0047 BLOCK 0021 PARCEL 0556  
 SUBDIVISION: \_\_\_\_\_  
 SECTION: \_\_\_\_\_ LOT: \_\_\_\_\_  
 NEAREST ROAD: 9267 All Saints Road

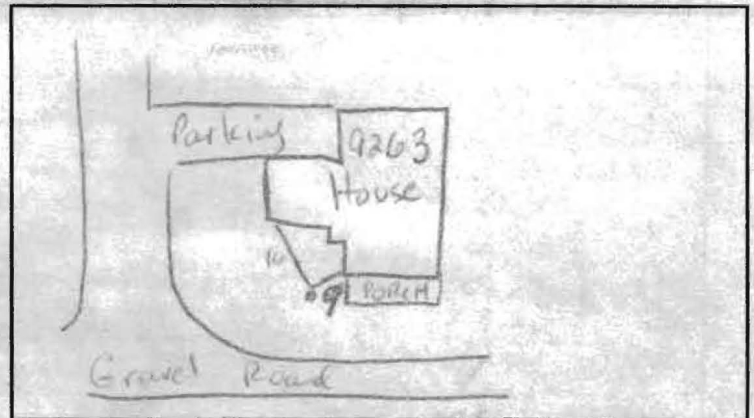

\* TYPE OF WELL BEING ABANDONED:

- \_\_\_\_\_ DRILLED \_\_\_\_\_ JETTED
- \_\_\_\_\_ BORED/AUGERED  HAND DUG
- \_\_\_\_\_ OTHER (specify) \_\_\_\_\_

\* USE CODE:

- DOMESTIC \_\_\_\_\_ MUNICIPAL/PUBLIC
- \_\_\_\_\_ IRRIGATION \_\_\_\_\_ INDUSTRIAL
- \_\_\_\_\_ TEST/OBSERVATION \_\_\_\_\_ GEOTHERMAL

\* TYPE OF CASING:

- \_\_\_\_\_ STEEL \_\_\_\_\_ PLASTIC
- CONCRETE  OTHER (specify) staked stone

\* SIZE OF CASING: 24 INCHES IN DIAMETER

\* DEPTH OF WELL: 9 FEET DEEP

\* WAS ANY CASING REMOVED?  YES \_\_\_\_\_ NO  
 if yes, length removed, in feet: \_\_\_\_\_

\* WAS CASING RIPPED OR PERFORATED?  YES \_\_\_\_\_ NO

LOG OF SEALING MATERIAL

MATERIAL	FEET	
	FROM	TO
Clean fill	9	5
Portland Cement	5	2
Clean fill	2	0
VOLUME OF MATERIAL USED		
5 ton clean fill 3 bags portland cement		

SIGNATURE-MASTER WELL DRILLER OR SUPERVISING SANITARIAN \_\_\_\_\_

LICENSE # 106

MWD/MSD/MGD  
 CIRCLE ONE

DATE 09/02/11