



Building Permit Application
 Howard County Maryland
 Department of Inspections, Licenses and Permits
 3430 Court House Drive
 Permits: 410-313-2455
 www.howardcountymd.gov

Date Received: 1/18/17
 Permit No.: B17000173

Building Address: 1201 Pindell School Rd
 City: Fulton State: MD Zip Code: 20759
 Suite/Apt. #: _____ SDP/WP/BA #: _____
 Census Tract: _____ Subdivision: _____
 Section: _____ Area: _____ Lot: _____
 Tax Map: _____ Parcel: _____ Grid: _____
 Zoning: _____ Map Coordinates: _____ Lot Size: _____

Property Owner's Name: Cindy Cooper
 Address: 1201 Pindell School Rd
 City: Fulton State: MD Zip Code: 20759
 Phone: 301-524-8270 Fax: _____
 Email: Ccooper11@yahoo.com

Existing Use: ✓
 Proposed Use: Heat, water, dryer, range
 Estimated Construction Cost: \$ 2,250.00
 Description of Work: install (1) 1,000 gallon above ground tank and hook up to stub. (propane)
 Occupant/Tenant Name: _____
 Was tenant space previously occupied? Yes No
 Contact Name: Brad Rohrer
 Address: 6708 Old National Pike
 City: Boonsboro State: MD Zip Code: 21713
 Phone: 301-432-6611 Fax: _____
 Email: BRohrer@thompsongas.com

Applicant's Name & Mailing Address, (if other than stated herein)
 Applicant's Name: Thompson Gas
 Address: 6708 Old National Pike
 City: Boonsboro State: MD Zip Code: 21713
 Phone: 301-432-6611 Fax: _____
 Email: BRohrer@thompsongas.com

Contractor Company: Thompson Gas
 Contact Person: Brad Rohrer
 Address: 6708 Old National Pike
 City: Boonsboro State: MD Zip Code: 21713
 License No.: GAS09104-60003
 Phone: 301-432-6611 Fax: _____
 Email: BRohrer@thompsongas.com

Engineer/Architect Company: _____
 Responsible Design Prof.: _____
 Address: _____
 City: _____ State: _____ Zip Code: _____
 Phone: _____ Fax: _____
 Email: _____

Commercial Building Characteristics	Residential Building Characteristics	
Height:	<input checked="" type="checkbox"/> SF Dwelling <input type="checkbox"/> SF Townhouse	
No. of stories:	Depth	Width
Gross area, sq. ft./floor:	1 st floor:	
	2 nd floor:	
Area of construction (sq. ft.):	Basement:	
	<input type="checkbox"/> Finished Basement	
Use group:	<input type="checkbox"/> Unfinished Basement	
	<input type="checkbox"/> Crawl Space	
Construction type:	<input type="checkbox"/> Slab on Grade	
<input type="checkbox"/> Reinforced Concrete	No. of Bedrooms:	
<input type="checkbox"/> Structural Steel	Multi-family Dwelling	
<input type="checkbox"/> Masonry	No. of efficiency units:	
<input type="checkbox"/> Wood Frame	No. of 1 BR units:	
<input type="checkbox"/> State Certified Modular	No. of 2 BR units:	
	No. of 3 BR units:	
	Other Structure:	
	Dimensions:	
<input checked="" type="checkbox"/> Roadside Tree Project Permit	Footings:	
<input type="checkbox"/> Yes <input checked="" type="checkbox"/> No	Roof:	
Roadside Tree Project Permit #:	<input type="checkbox"/> State Certified Modular	
	<input type="checkbox"/> Manufactured Home	

Utilities		
Electric:	<input type="checkbox"/> Yes <input type="checkbox"/> No	
Gas:	<input checked="" type="checkbox"/> Yes <input type="checkbox"/> No	LP
Water Supply		
<input type="checkbox"/> Public		
<input checked="" type="checkbox"/> Private		
Sewage Disposal		
<input type="checkbox"/> Public		
<input checked="" type="checkbox"/> Private		
Heating System		
<input type="checkbox"/> Electric <input type="checkbox"/> Oil		
<input type="checkbox"/> Natural Gas <input checked="" type="checkbox"/> Propane Gas		
<input type="checkbox"/> Other:		
Sprinkler System:		
<input type="checkbox"/> Yes <input type="checkbox"/> No		
Grading Permit Number:		
Building Shell Permit Number:		

THE UNDERSIGNED HEREBY CERTIFIES AND AGREES AS FOLLOWS: (1) THAT HE/SHE IS AUTHORIZED TO MAKE THIS APPLICATION; (2) THAT THE INFORMATION IS CORRECT; (3) THAT HE/SHE WILL COMPLY WITH ALL REGULATIONS OF HOWARD COUNTY WHICH ARE APPLICABLE THEREIN; (4) THAT HE/SHE WILL PERFORM NO WORK ON THE ABOVE REFERENCED PROPERTY NOT SPECIFICALLY DESCRIBED IN THIS APPLICATION; (5) THAT HE/SHE GRANTS COUNTY OFFICIALS THE RIGHT TO ENTER ONTO THIS PROPERTY FOR THE PURPOSE OF INSPECTING THE WORK PERMITTED AND POSTING NOTICES.

Applicant's Signature: [Signature]
 Email Address: BRohrer@thompsongas.com

Print Name: J. Randall Thompson
 Date: 1/18/17

RECEIVED

JAN 18 2017

LICENSES & PERMITS DIVISION

Email Address: _____
 Title/Company: _____

Checks Payable to: DIRECTOR OF FINANCE OF HOWARD COUNTY
 PLEASE WRITE NEATLY & LEGIBLY
 -FOR OFFICE USE ONLY-

AGENCY	DATE	SIGNATURE OF APPROVAL
State Highways		
Building Officials		
PSZA (Zoning)		
PSZA (Engineering)		
Health	<u>1/20/17</u>	<u>[Signature]</u>

Is Sediment Control approval required for issuance? Yes No
 CONTINGENCY CONSTRUCTION START

DPZ SETBACK INFORMATION	
Front:	
Rear:	
Side:	
Side St.:	
All minimum setbacks met?	<input type="checkbox"/> Yes <input type="checkbox"/> No
Is Entrance Permit Required?	<input type="checkbox"/> Yes <input type="checkbox"/> No
Historic District?	<input type="checkbox"/> Yes <input type="checkbox"/> No
Lot Coverage for New Town Zone:	
SDP/Red-line approval date:	

Filing Fee	\$ -
Permit Fee	\$ 100.00
Tech Fee	\$ 10.00
Excise Tax	\$
PSFS	\$
Guaranty Fund	\$
Add'l per Fee	\$
Total Fees	\$ 110.00
Sub- Total Paid	\$
Balance Due	\$
Check	# <u>100868</u>

HOWARD COUNTY
MARYLAND


APPROVED

WALK-THRU BUILDING PERMIT

BP# B17000173 A#

APP. SAN Robert Freeman DATE: 1/20/1

DESC. OF WORK:
Above Ground Propane Tank

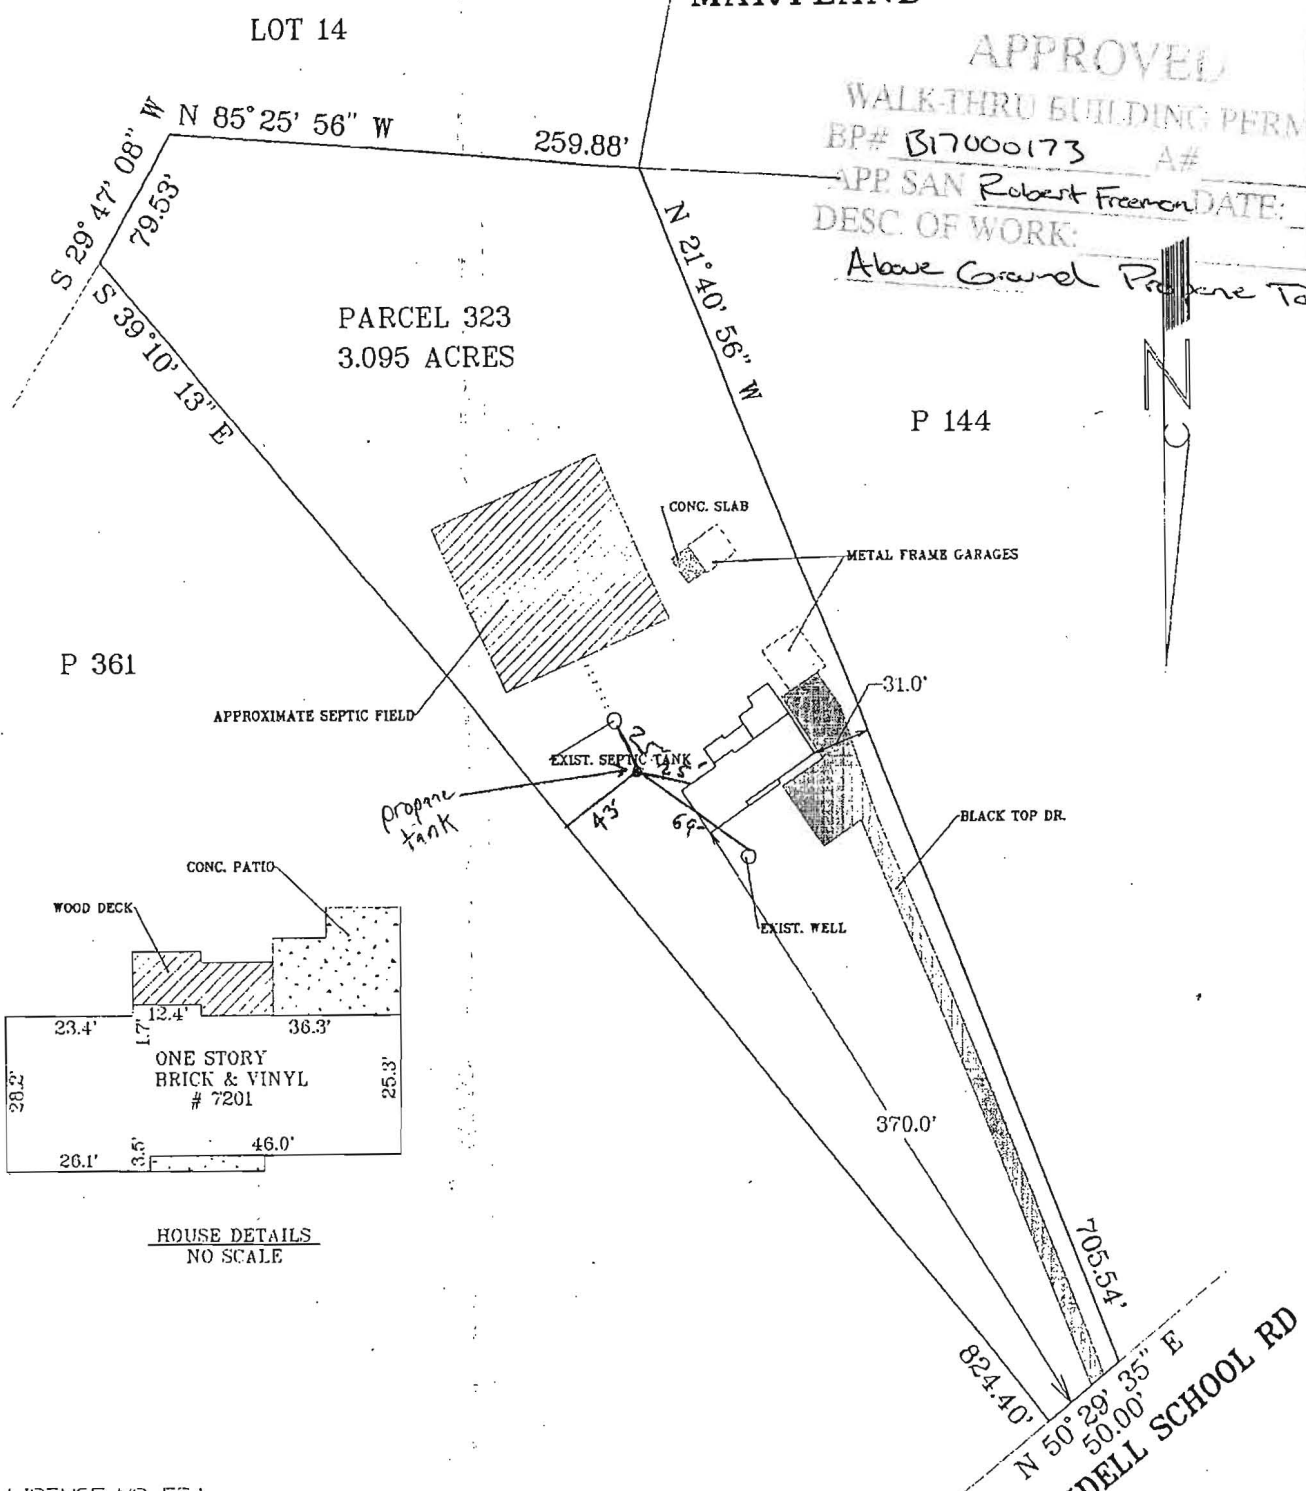

HOUSE DETAILS
NO SCALE


NOTE: LICENSE NO. 574
EXPIRATION DATE 03/21/17

HOUSE LOCATION DRAWING

PINDELL SCHOOL RD

SURVEYOR'S CERTIFICATION

I HEREBY CERTIFY THAT THE PROPERTY DELINEATED HEREON IS IN ACCORDANCE WITH THE PLAT OF SUBDIVISION AND DEED OF RECORD AND THAT THE IMPROVEMENTS SHOWN WERE LOCATED BY ACCEPTED FIELD PRACTICES. THIS HOUSE LOCATION SURVEY IS NOT FOR THE DETERMINING PROPERTY LINES, AND NO TITLE REPORT WAS FURNISHED TO THIS SURVEYOR, AND LOT CORNERS HAVE NOT BEEN SET BY THIS SURVEY.

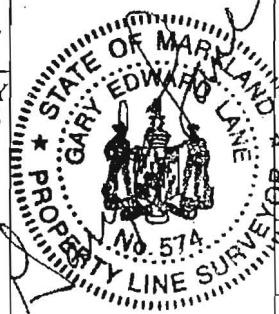

MARYLAND LAND SURVEYING
CONSULTING LAND SURVEYORS AND PLANNERS
9890 LYON AVENUE
LAUREL, MARYLAND 20723
(301) 206-2258

SCALE 1" = 100'	DWG. BY G.E.L.	CASE No.
LIBER 17337	ELECTION DISTRICT 05	COUNTY HOWARD
FOLIO 287		DATE 01/16/17