

\*\*\*\*\*  
WATER WELL ABANDONMENT-SEALING REPORT FORM  
\*\*\*\*\*

SUBMIT COPIES OF COMPLETED FORM TO:

- \* COUNTY ENVIRONMENTAL AGENCY (contact MDE, WMA if address needed)
- \* WELL OWNER
- \* MDE, WATER MANAGEMENT ADMINISTRATION, WELL PROGRAM

OK  
7/29/16 SC

DATE WELL ABANDONED: 7-12-2016 (month/day/year)

\* PERMIT NUMBER OF ABANDONED WELL (if any) None

\* PERMIT NUMBER OF REPLACEMENT WELL: None


\* PERSON ABANDONING WELL: Joseph & Mayne WELL DRILLER'S LICENSE NUMBER: MSD 024

CIRCLE: MWD / MSD / MGD

\* OWNER'S NAME: John + Susan Mc Tague

SITE LOCATION MAP

\* WELL LOCATION:  
COUNTY: Howard  
NEAREST TOWN: Sykesville Md 21784  
TAX MAP \_\_\_\_\_ BLOCK \_\_\_\_\_ PARCEL \_\_\_\_\_  
SUBDIVISION: \_\_\_\_\_  
SECTION: \_\_\_\_\_ LOT: \_\_\_\_\_  
STREET ADDRESS: 12621 Howard Lodge Drive

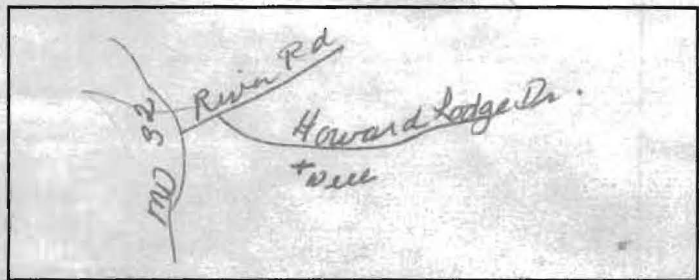

LATITUDE 3 9 . 33 7 8 7 \_

LONGITUDE 7 6 . 9 5 0 2 5 \_

LOG OF SEALING MATERIAL

MATERIAL	FEET	
	FROM	TO
<u>Gravel + Cement</u>	<u>0</u>	<u>44</u>
VOLUME OF MATERIAL USED		

\* TYPE OF WELL BEING ABANDONED:  
 DRILLED \_\_\_\_\_ JETTED \_\_\_\_\_  
 BORED \_\_\_\_\_ HAND DUG \_\_\_\_\_  
 OTHER (specify) \_\_\_\_\_

\* USE CODE:  
 DOMESTIC \_\_\_\_\_ MUNICIPAL/PUBLIC \_\_\_\_\_  
 IRRIGATION \_\_\_\_\_ INDUSTRIAL \_\_\_\_\_  
 TEST/OBSERVATION \_\_\_\_\_ GEOTHERMAL \_\_\_\_\_

\* TYPE OF CASING:  
 STEEL \_\_\_\_\_ PLASTIC \_\_\_\_\_  
 CONCRETE \_\_\_\_\_ OTHER (specify) \_\_\_\_\_

SIZE OF CASING: 6 3/8 INCHES IN DIAMETER

DEPTH OF WELL: 44 FEET DEEP

WAS ANY CASING REMOVED?  YES \_\_\_\_\_ NO  
If yes, length removed, in feet: 1

WAS CASING RIPPED OR PERFORATED? \_\_\_\_\_ YES  NO

SIGNATURE-MASTER WELL DRILLER OR SUPERVISING SANITARIAN Joseph & Mayne LICENSE# MSD 024 CIRCLE ONE MWD / MSD / MGS DATE 7-12-16

COUNTY

Pursuant to § 10-624 of the State Govt. Article of the Maryland Code, personal info requested on this form is used in processing this form pursuant to COMAR 26.04.04. Failure to provide the info may result in this form not being processed. You have the right to inspect, amend, or correct this form. The Maryland Department of the Environment is subject to the Maryland Public Information Act. This form may be made available on the Internet via MDE's website and is subject to inspection or copying, in whole or in part, by the public and other governmental agencies, if not protected by federal or State Law.

MARYLAND DEPARTMENT OF THE ENVIRONMENT, WATER MANAGEMENT ADMINISTRATION  
1800 Washington Blvd., Baltimore, Maryland 21230 (410) 537-3784

\*\*\*\*\*  
WATER WELL ABANDONMENT-SEALING REPORT FORM  
\*\*\*\*\*

SUBMIT COPIES OF COMPLETED FORM TO:

- \* COUNTY ENVIRONMENTAL AGENCY (contact MDE, WMA if address needed)
- \* WELL OWNER
- \* MDE, WATER MANAGEMENT ADMINISTRATION, WELL PROGRAM

OK  
8/24/16 sc

DATE WELL ABANDONED: 7-12-2016 (month/day/year)

\* PERMIT NUMBER OF ABANDONED WELL (if any) NONE


\* PERMIT NUMBER OF REPLACEMENT WELL: NONE

\* PERSON ABANDONING WELL: Joseph L. Mayne WELL DRILLER'S LICENSE NUMBER: MSD024

\* OWNER'S NAME: John + Susan Mc Tague CIRCLE: MWD / MSD / MGD

\* WELL LOCATION:  
COUNTY: Howard  
NEAREST TOWN: Sykesville Md 21784  
TAX MAP \_\_\_\_\_ BLOCK \_\_\_\_\_ PARCEL \_\_\_\_\_  
SUBDIVISION: \_\_\_\_\_  
SECTION: \_\_\_\_\_ LOT: \_\_\_\_\_  
STREET ADDRESS: 12621 Howard Lodge Drive

SITE LOCATION MAP

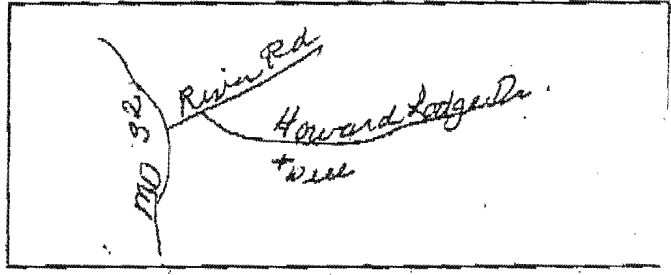

LATITUDE 39.33787  
LONGITUDE 76.95025

LOG OF SEALING MATERIAL

MATERIAL	FEET	
	FROM	TO
<u>Gravel + Cement</u>	<u>0</u>	<u>4 1/2</u>
VOLUME OF MATERIAL USED		

\* TYPE OF WELL BEING ABANDONED:  
 DRILLED \_\_\_\_\_ JETTED \_\_\_\_\_  
 BORED \_\_\_\_\_ HAND DUG \_\_\_\_\_  
\_\_\_\_\_ OTHER (specify) \_\_\_\_\_

\* USE CODE:  
 DOMESTIC \_\_\_\_\_ MUNICIPAL/PUBLIC \_\_\_\_\_  
 IRRIGATION \_\_\_\_\_ INDUSTRIAL \_\_\_\_\_  
 TEST/OBSERVATION \_\_\_\_\_ GEOTHERMAL \_\_\_\_\_

\* TYPE OF CASING:  
 STEEL \_\_\_\_\_ PLASTIC \_\_\_\_\_  
 CONCRETE \_\_\_\_\_ OTHER (specify) \_\_\_\_\_

SIZE OF CASING: 6 3/8 INCHES IN DIAMETER

DEPTH OF WELL: 44 FEET DEEP

WAS ANY CASING REMOVED?  YES \_\_\_\_\_ NO  
If yes, length removed, in feet: 1

WAS CASING RIPPED OR PERFORATED? \_\_\_\_\_ YES  NO

SIGNATURE-MASTER WELL DRILLER OR SUPERVISING SANITARIAN Joseph L. Mayne LICENSE# MSD 024

MWD / MSD / MGS CIRCLE ONE DATE 7-12-16 \*

Pursuant to § 10-624 of the State Govt. Article of the Maryland Code, personal info requested on this form is used in processing this form pursuant to COMAR 26.04.04. Failure to provide the info may result in this form not being processed. You have the right to inspect, amend, or correct this form. The Maryland Department of the Environment is subject to the Maryland Public Information Act. This form may be made available on the Internet via MDE's website and is subject to inspection or copying, in whole or in part, by the public and other governmental agencies, if not protected by federal or State Law.