

PERCOLATION CERTIFICATION PLAN
7539 FLAMEWOOD DRIVE
CLARKSVILLE, MD 21029

The purpose of this Percolation Certification Plan is to install a 20'x40' inground swimming pool at 7539 Flamewood Drive, Clarksville, Md. 21029. In order to install the pool, it will require relocating 3850 Square Feet of Septic Reserve Area on this property.

This Lot, recorded after 1972, designates a private sewage disposal area of at least 10,000 sqft. as required by the Maryland Department of Environment for individual sewage disposal. Improvements of any nature in this area are restricted. This sewage disposal area shall become null and void upon connection to a public sewerage system. The County Health Officer shall have authority to grant adjustments to the private sewage easement Recordation of a revised sewage easement shall not be necessary.

"I certify that the information shown herein is based on field work performed by me or under direct supervision, and is correct, to the best of my knowledge and belief"

Approved For Private Water and Private Sewerage Systems


B. Wilson for Maria Roszman 11/16/2016
 Health Officer, Howard County Health Dept. 20 Date

APPROVED

WALK-THRU BUILDING PERMIT

BP# _____ A# _____
 APP. SAN H. Oswald DATE: 11/17/16
 DESC. OF WORK: 23'9" x 41'11"
inground swimming pool

- * Any changes to a private sewage easement shall require a revised percolation certification plan.
- * The topography of this plat is taken from Howard Co Planning & Zoning Topography map and is verified to accurately represent the relative changes.
- * All wells and septic systems located within 100' of the property boundaries and 200' down gradient of any wells and/or septic systems have been shown.

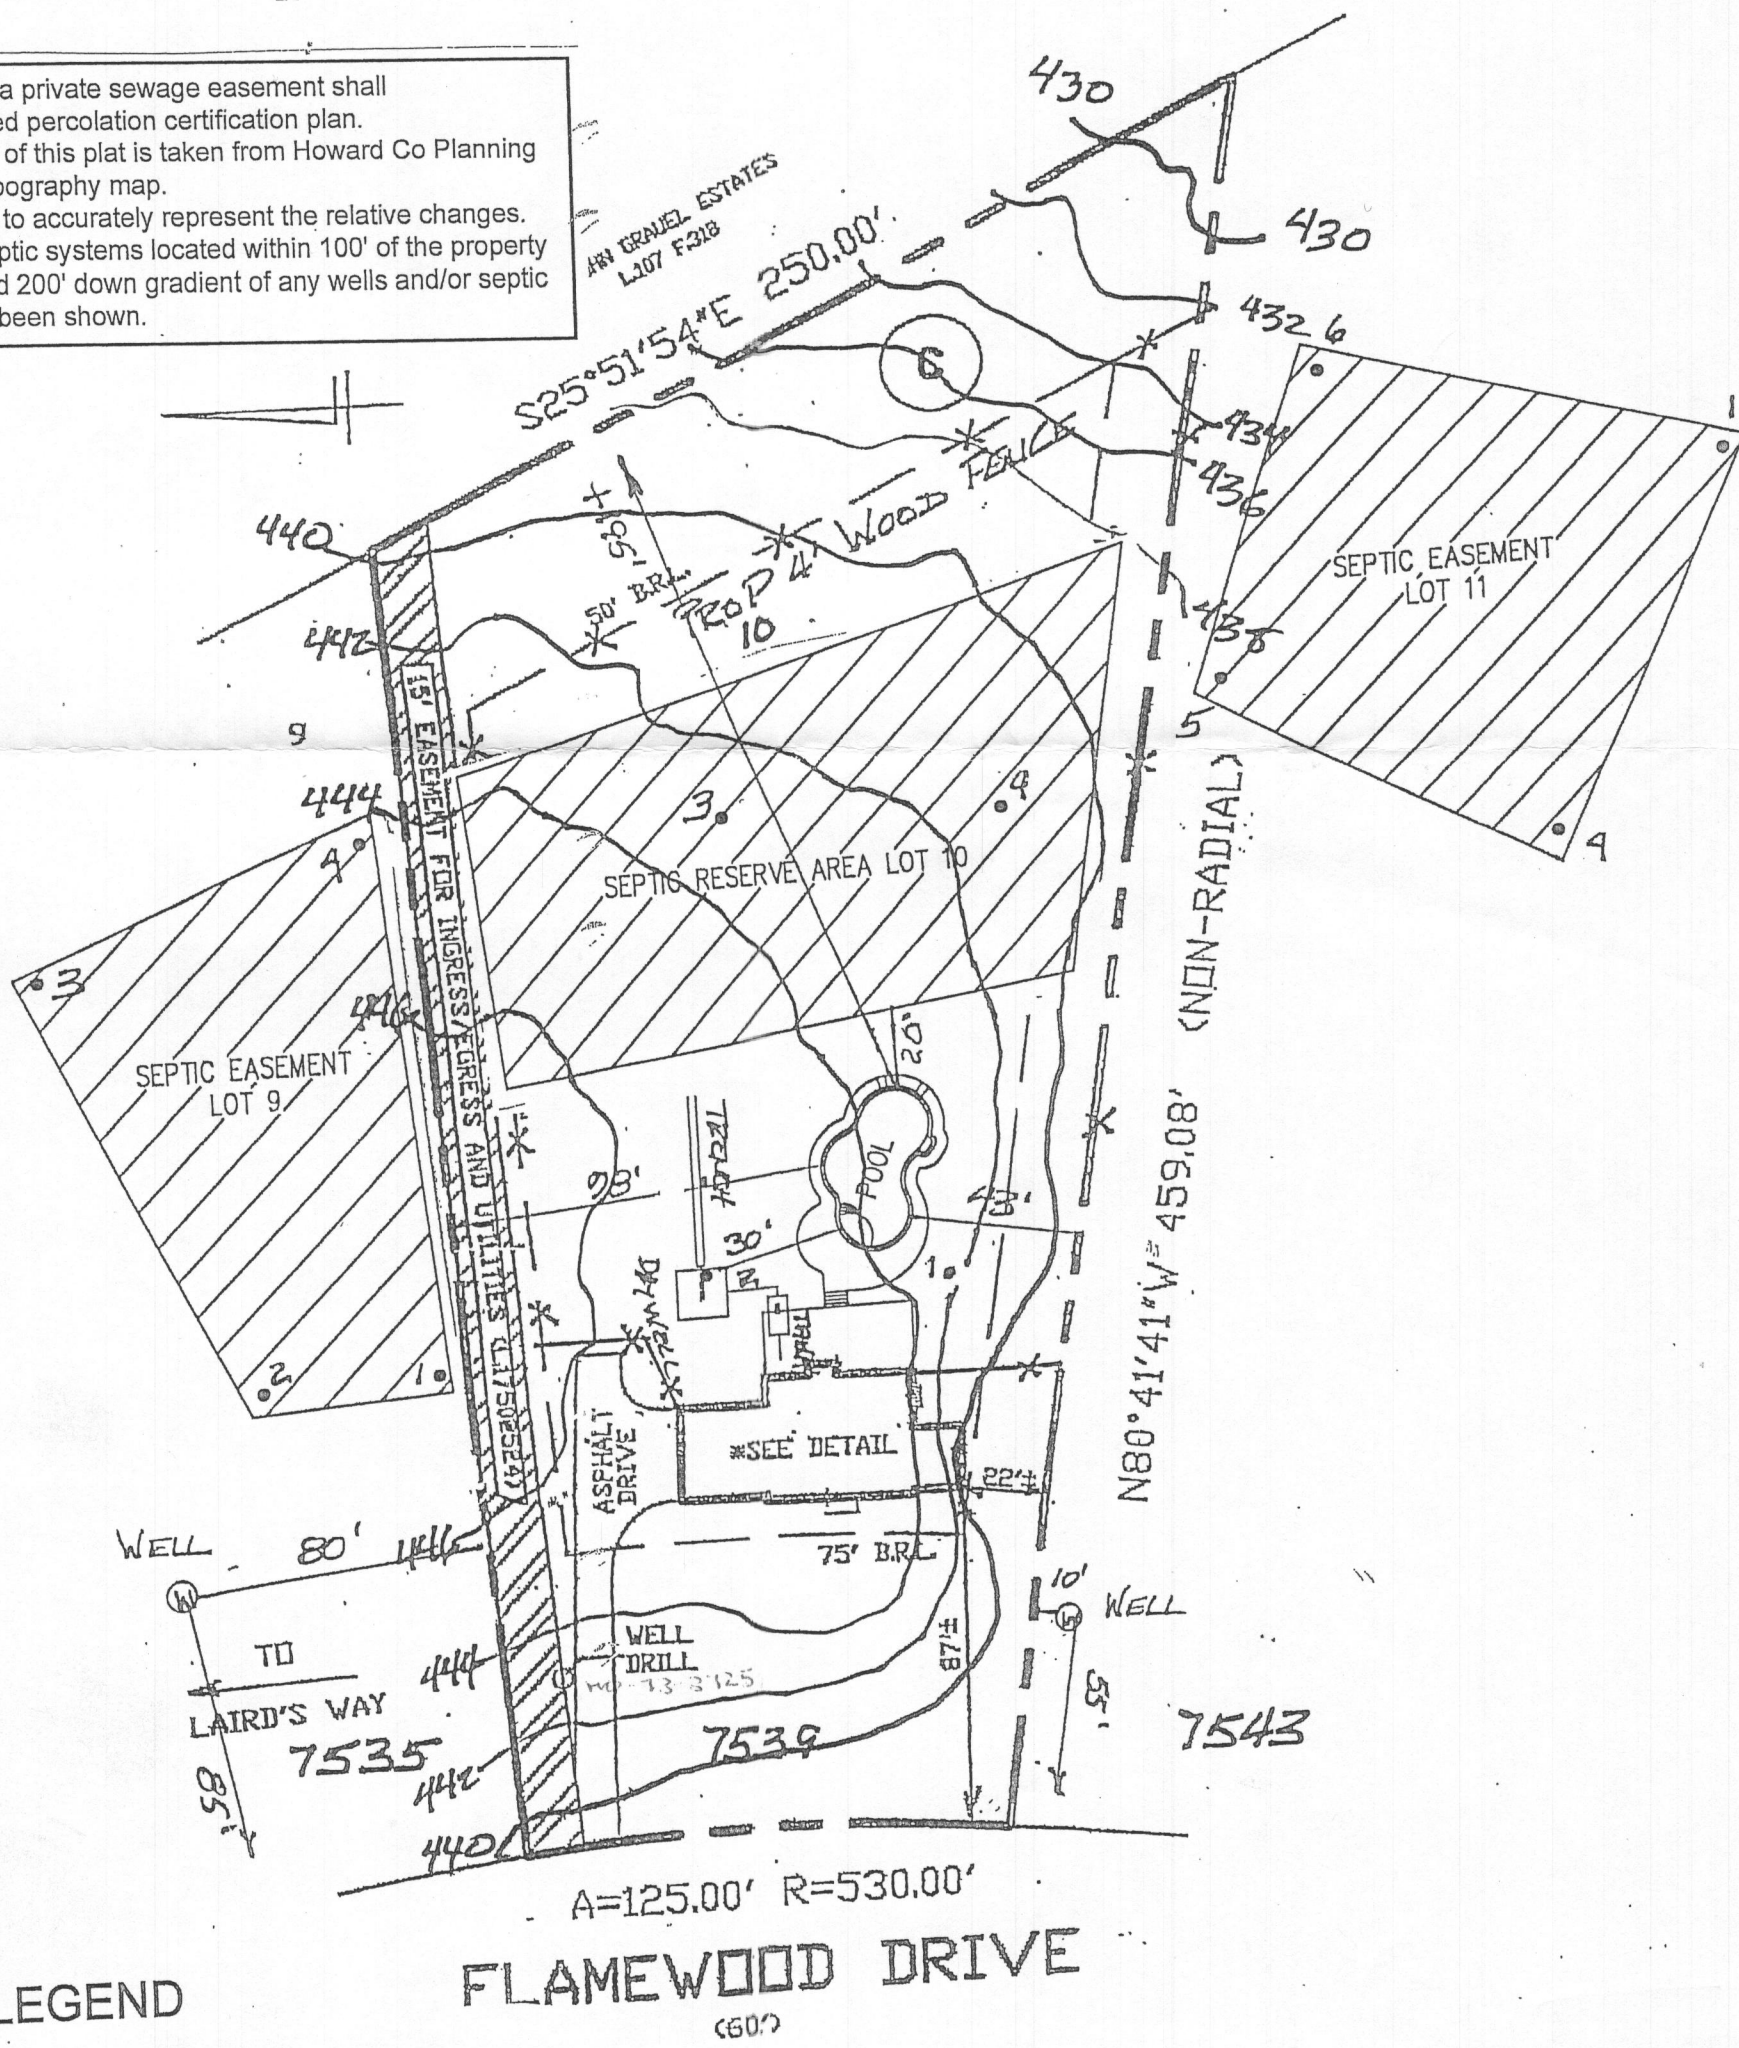

LEGEND

- PASSED PERC LOCATIONS
- WELL LOCATIONS
- SEPIC DISPOSAL AREA

SCALE: 1" = 50'