
 WATER WELL ABANDONMENT-SEALING REPORT FORM

SUBMIT COPIES OF COMPLETED FORM TO:


- * COUNTY ENVIRONMENT AGENCY (contact MDE, WMA if address needed)
- * WELL OWNER
- * MDE, WATER MANAGEMENT ADMINISTRATION, WELL PROGRAM

DATE WELL ABANDONED: 10/14/2005 (month/day/year)

* PERMIT NUMBER OF ABANDONED WELL (if any) N/A — —
 * PERMIT NUMBER OF REPLACEMENT WELL N/A — —

* PERSON ABANDONING WELL: Efrain Larchas WELL DRILLERS LICENSE NUMBER: _____
 * OWNER'S NAME: Efrain Larchas CIRCLE: MWD/MSD/MGD

* WELL LOCATION:
 COUNTY: Howard
 NEAREST TOWN: Laurel
 TAX MAP 41 BLOCK 17 PARCEL 270
 SUBDIVISION: _____
 SECTION: _____ LOT: _____
 NEAREST ROAD: 7529 Old Columbia Road
Laurel, MD 20723
 MARYLAND GRID COORDINATES
 BOX NUMBER E 833
 N 485 ←

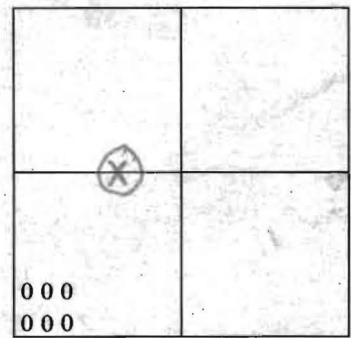

SHOW WELL LOCATION BY X WITHIN BOX

* TYPE OF WELL BEING ABANDONED:
 DRILLED JETTED
 BORED/AUGURED HAND DUG
 OTHER (specify) _____

* USE CODE:
 DOMESTIC MUNICIPAL/PUBLIC
 IRRIGATION INDUSTRIAL
 TEST/OBSERVATION

* TYPE OF CASING:
 STEEL PLASTIC
 CONCRETE OTHER (specify) _____

* SIZE OF CASING: 3.5 ^{feet} INCHES IN DIAMETER

* DEPTH OF WELL: 37 FEET DEEP

* WAS ANY CASING REMOVED? YES _____ NO
 if yes, length removed, in feet: 1

* WAS CASING RIPPED OR PERFORATED? _____ YES NO

LOG OF SEALING MATERIAL

MATERIAL	FEET	
	FROM	TO
Concrete	1.5'	5'
Sand	5'	37'

SIGNATURE-MASTER WELL DRILLER OR SUPERVISING SANITARIAN Brian Baber LICENSE # 1223 MWD/MSD/MGD CIRCLE ONE 10/14/2005 DATE