

Permits: 410-313-2455
 Inspections: 410-313-1810
 Automated Line: 410-313-3800

Howard County Building/Fire Permit Application
 Department of Inspections, Licenses & Permits
 3430 Court House Drive
 Ellicott City, MD 21043

Permit Number:

Building Address: 12256 Carroll Mill RD
Ellicott City MD 21042

Suite/Apt. # _____ SDP/WP/BA #: _____

Census Tract: _____ Subdivision: Woodmark

Section: _____ Area: _____ Lot: 1

Tax Map: 22 Parcel: 174 Grid: 7

Zoning: _____ Map Coordinates: _____ Lot Size: 40,075

Existing Use: Single Family Home

Proposed Use: _____

Estimated Construction Cost: \$ 25,000

Description of Work: Replace rafter, ceiling joists, and collar ties on rear of house damaged by storm.
Replace drywall as needed due to water damage.

Occupant or Tenant: _____

Was tenant space previously occupied? Yes No

Contact Name: Daniel Hanson

Address: 12256 Carroll Mill RD

City: Ellicott City State: MD Zip Code: 21042

Phone: _____ Fax: _____

Email: _____

Property Owner's Name: Daniel Hanson

Address: 12256 Carroll Mill RD

City: Ellicott City State: MD Zip Code: 21042

Home Phone: 410-916-1469 Work Phone: _____

Applicant's Name & Mailing Address, (If other than stated herein): _____

Phone: 410-916-1469 Fax: _____

Email: _____

Contractor Company: Smith & Son's

Contact Person: Mike Smith

Address: 8131 Solley RD

City: Pasadena State: MD Zip Code: 21122

License No.: MHIC:21393

Phone: 410-360-5252 Fax: 410-360-0826

Email: smith8131@comcast.net

Engineer/Architect Company: _____

Responsible Design Prof.: _____

Address: _____

City: _____ State: _____ Zip Code: _____

Phone: _____ Fax: _____

Email: _____

BUILDING DESCRIPTION - COMMERCIAL

Building Characteristics	Utilities
Height:	<u>Water Supply</u>
No. of stories:	<input type="checkbox"/> Public
Gross area, sq. ft./floor:	<input type="checkbox"/> Private
	<u>Sewage Disposal</u>
Area of construction (sq. ft.):	<input type="checkbox"/> Public
	<input type="checkbox"/> Private
Use group:	Electric: <input type="checkbox"/> Yes <input type="checkbox"/> No
	Gas: <input type="checkbox"/> Yes <input type="checkbox"/> No
<u>Construction type:</u>	<u>Heating System</u>
<input type="checkbox"/> Reinforced Concrete	<input type="checkbox"/> Electric <input type="checkbox"/> Oil
<input type="checkbox"/> Structural Steel	<input type="checkbox"/> Natural Gas <input type="checkbox"/> Propane Gas
<input type="checkbox"/> Masonry	<u>Sprinkler System:</u>
<input type="checkbox"/> Wood Frame	<input type="checkbox"/> N/A
<input type="checkbox"/> State Certified Modular	<input type="checkbox"/> Full
<input checked="" type="checkbox"/> <u>Roadside Tree Project Permit</u>	<input type="checkbox"/> Partial
<input type="checkbox"/> Yes <input checked="" type="checkbox"/> No	<input type="checkbox"/> Other Suppression
<u>Roadside Tree Project Permit #</u>	No. of Heads:

BUILDING DESCRIPTION - RESIDENTIAL

Building Characteristics	Utilities
<input checked="" type="checkbox"/> SF Dwelling <input type="checkbox"/> SF Townhouse	<u>Water Supply</u>
<u>Depth</u> <u>Width</u>	<input type="checkbox"/> Public
1 st floor:	<input type="checkbox"/> Private
2 nd floor:	<u>Sewage Disposal</u>
Basement:	<input type="checkbox"/> Public
<input type="checkbox"/> Finished Basement	<input checked="" type="checkbox"/> Private
<input type="checkbox"/> Unfinished Basement	Electric: <input type="checkbox"/> Yes <input type="checkbox"/> No
<input type="checkbox"/> Crawl Space	Gas: <input type="checkbox"/> Yes <input type="checkbox"/> No
<input type="checkbox"/> Slab on Grade	<u>Heating System</u>
No. of Bedrooms:	<input type="checkbox"/> Electric
<u>Multi-family Dwelling</u>	<input type="checkbox"/> Oil
No. of efficiency units:	<input type="checkbox"/> Natural Gas
No. of 1 BR units:	<input type="checkbox"/> Propane Gas
No. of 2 BR units:	
No. of 3 BR units:	
Other Structure:	
Dimensions:	<input checked="" type="checkbox"/> <u>Roadside Tree Project Permit</u>
Footings:	<input type="checkbox"/> Yes <input type="checkbox"/> No
Roof:	<u>Roadside Tree Project Permit #</u>
<input type="checkbox"/> State Certified Modular	
<input type="checkbox"/> Manufactured Home	

THE UNDERSIGNED HEREBY CERTIFIES AND AGREES AS FOLLOWS: (1) THAT HE/SHE IS AUTHORIZED TO MAKE THIS APPLICATION; (2) THAT THE INFORMATION IS CORRECT; (3) THAT HE/SHE WILL COMPLY WITH ALL REGULATIONS OF HOWARD COUNTY WHICH ARE APPLICABLE THERETO; (4) THAT HE/SHE WILL PERFORM NO WORK ON THE ABOVE REFERENCED PROPERTY NOT SPECIFICALLY DESCRIBED IN THIS APPLICATION; (5) THAT HE/SHE GRANTS COUNTY OFFICIALS THE RIGHT TO ENTER ONTO THIS PROPERTY FOR THE PURPOSE OF INSPECTING THE WORK PERMITTED AND POSTING NOTICES.

[Signature]
 Applicant's Signature

aboutpermits@hotmail.com
 Email Address

 Title/Company

Barbara Schaefer
 Print Name

07/20/2016
 Date

Checks Payable to: DIRECTOR OF FINANCE OF HOWARD COUNTY
 PLEASE WRITE NEATLY & LEGIBLY
 -FOR OFFICE USE ONLY-


AGENCY	DATE	SIGNATURE OF APPROVAL
State Highways		
Building Officials		
PSZA (Zoning)		
PSZA (Engineering)		
Health	<u>7/20/16</u>	<u>[Signature]</u>
Fire Protection		

Is Sediment Control approval required for issuance? Yes No
 CONTINGENCY CONSTRUCTION START
 ONE STOP SHOP

DPZ SETBACK INFORMATION

Front:	
Rear:	
Side:	
Side St.:	
All minimum setbacks met?	<input type="checkbox"/> Yes <input type="checkbox"/> No
Is Entrance Permit Required?	<input type="checkbox"/> Yes <input type="checkbox"/> No
Historic District?	<input type="checkbox"/> Yes <input type="checkbox"/> No
Lot Coverage for New Town Zone:	
SDP/Red-line approval date:	

Filing Fee	\$
Permit Fee	\$
Tech Fee	\$
Excise Tax	\$
PSFS	\$
Guaranty Fund	\$
Add'l per Fee	\$
Total Fees	\$
Sub- Total Paid	\$
Balance Due	\$

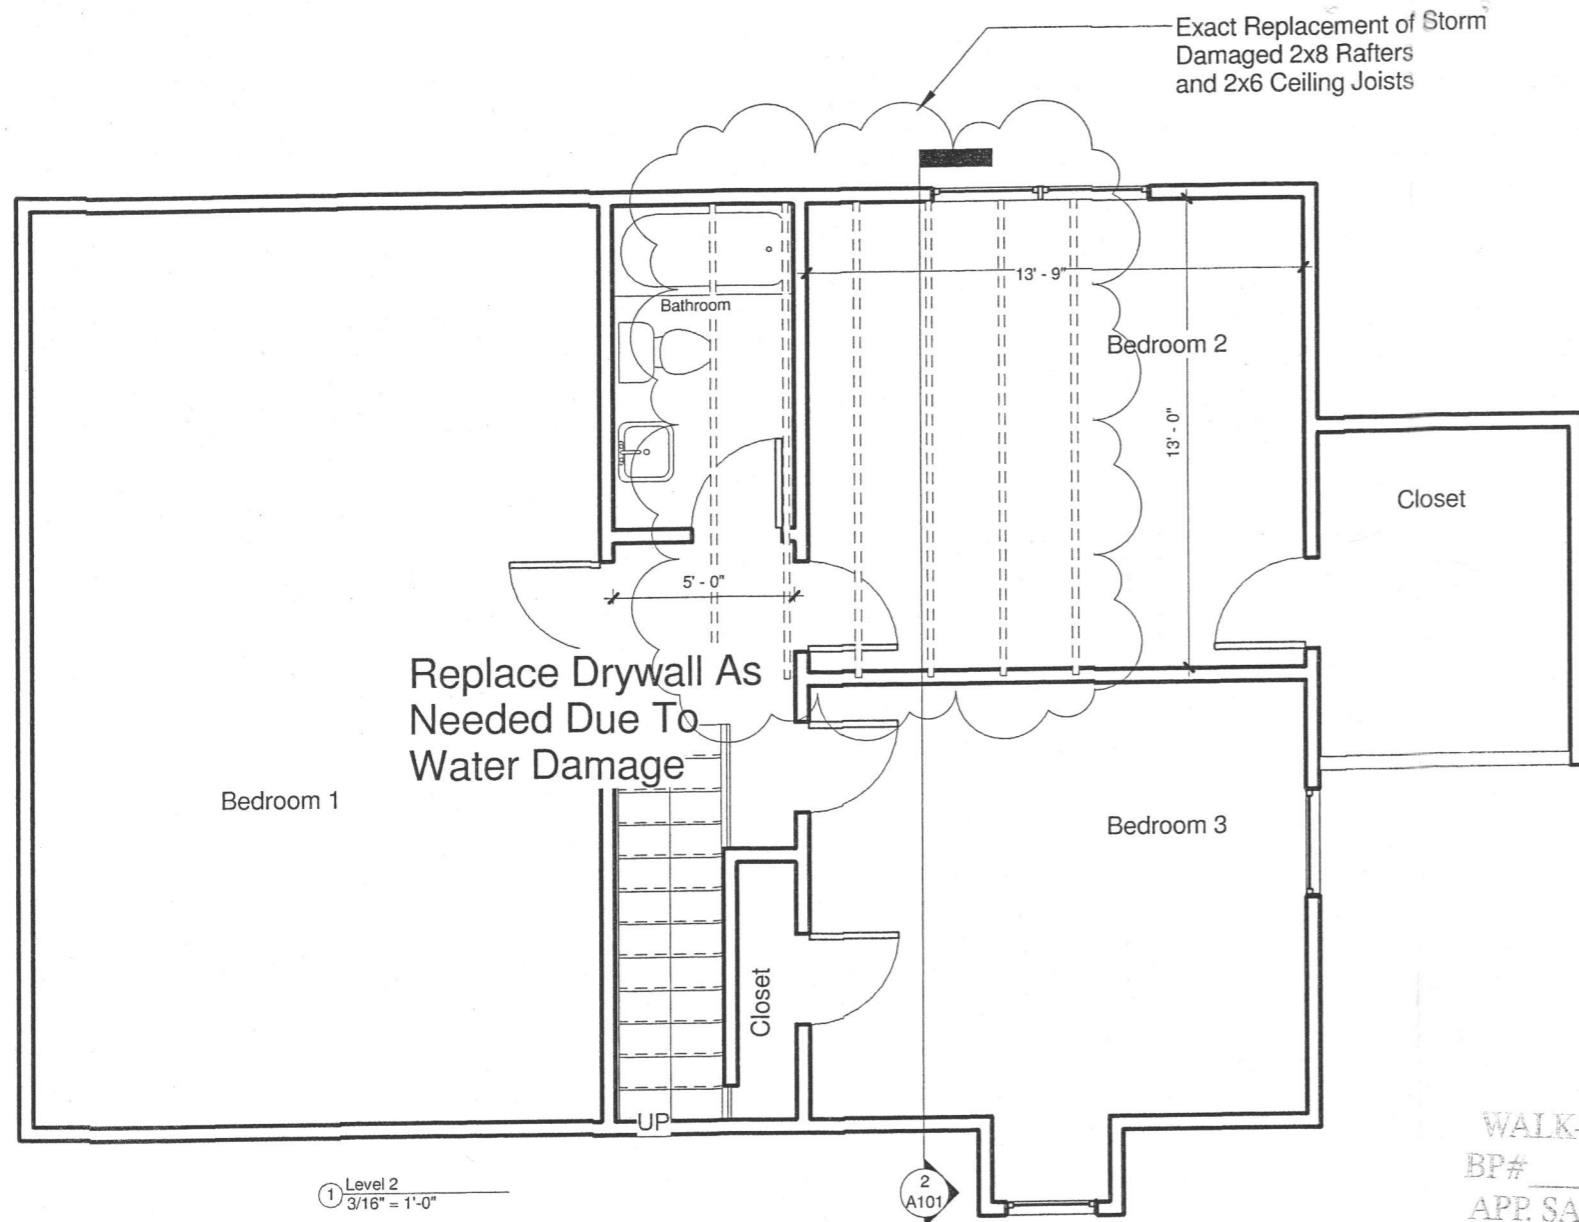

1 Level 2
3/16" = 1'-0"

2 A101


GENERAL NOTES:

- Framing
- Must be spaced 16 inches on centers
 - Pressure Treated joists less than 18" to ground
 - Provide double joists under oversize bathroom tubs
 - Provide collar ties or structural ridge at framed roofs less than 3 1/2 in 12 pitch Wood
 - Shall not rest upon masonry within 8" of the ground
 - No wood within 4' of the ground shall be allowed to come in contact w/piping, or other objects unless they have been fitted w/metal shields to block the shelter tubes of termites.

IECC Notes:

Recessed luminaries installed in the building thermal envelope shall be sealed to limit air leakage.

All work must be done in accordance with IBC, NFPA and Howard County building and zonings codes. Written dimensions shall have precedence over scale dimensions. Contractor shall verify and be responsible for all dimensions and conditions on the job.

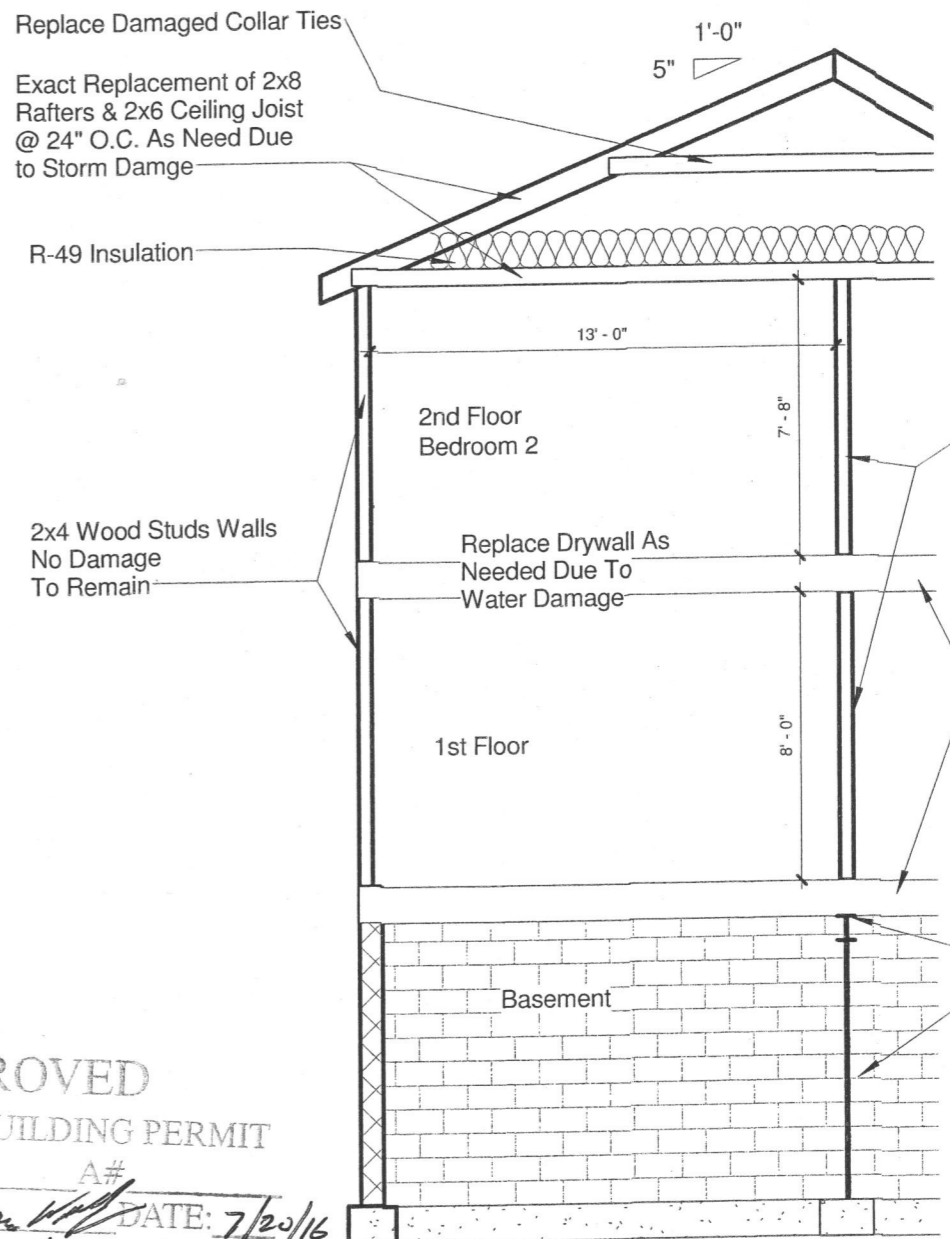

2 Section 1
3/16" = 1'-0"

APPROVED
WALK-THRU BUILDING PERMIT
BP# _____ A# _____
APP. SAN *[Signature]* DATE: 7/20/16
DESC. OF WORK: *Approved renovations as shown.*

Scope Of Work:
Replace Rafter, Ceiling Joists and Collar Ties on Rear of House Damage By Storm.
Replace Drywall as Needed Due to Water Damaged

Property Info:
12256 Carroll Mill Road
Ellicott City, MD 21042

Dist 03 Acct No. 291227
Map 0022 Grid 0007 Parcel 0174

Lot 1 BL F S 4
Woodmark

Contractor and/or owner is responsible for all necessary additional information to build job and meet local and state requirements before starting construction.

12256 Carroll Mill Road

Project number	Project Number
Date	Issue Date
Drawn by	Author
Checked by	Checker

A101

Scale 3/16" = 1'-0"