

RECORDED

APPLICATION

A 22358

SEWAGE DISPOSAL TESTING

P _____

STATE OF MARYLAND - DEPARTMENT OF HEALTH AND MENTAL HYGIENE

HOWARD COUNTY HEALTH DEPARTMENT
ENVIRONMENTAL HEALTH SERVICES
P. O. BOX 476, ELLICOTT CITY, MARYLAND 21043
TELEPHONE: 465-5000, EXT. 356

DISTRICT 5th
DATE 10/23/75

10/31/75
9:30 A.M.

TO: THE COUNTY HEALTH OFFICER
ELLICOTT CITY, MARYLAND

I, HEREBY, APPLY FOR THE NECESSARY TEST IN ORDER TO CONSTRUCT (OR RECONSTRUCT) A SEWAGE DISPOSAL SYSTEM.

PROPERTY OWNER Bruce M G. Mc Neil

ADDRESS 7330 Mink Hollow Road, Highland, Md. PHONE 774-7648

PROPERTY LOCATION:

SUBDIVISION _____ LOT NO. _____

ROAD AND DESCRIPTION 7330 Mink Hollow Road - approximately 1500 ft. from Montgomery
County Line on right hand side.

SIZE OF LOT 3 acres TOTAL BOTH LOTS Existing house - use as landmark
TYPE BLDG. 3 bedrooms
NUMBER OF BEDROOMS _____

IF NOT SINGLE RESIDENCE DESCRIBE _____

THE SYSTEM INSTALLED UNDER THIS APPLICATION IS ACCEPTABLE ONLY UNTIL PUBLIC FACILITIES BECOME AVAILABLE.

SIGNATURE OF APPLICANT Bruce M. McNeil


APPROVED BY _____ FOR _____ DATE _____
(KIND OF SYSTEM)

REJECTED BY _____ FOR _____ DATE _____
(KIND OF SYSTEM)

HOLD PENDING FURTHER TESTS BH DATE 10/31/75

REASONS FOR REJECTION OR HOLDING 10/31/75 - LITTLE PERC BH.

THIS IS NOT A PERMIT

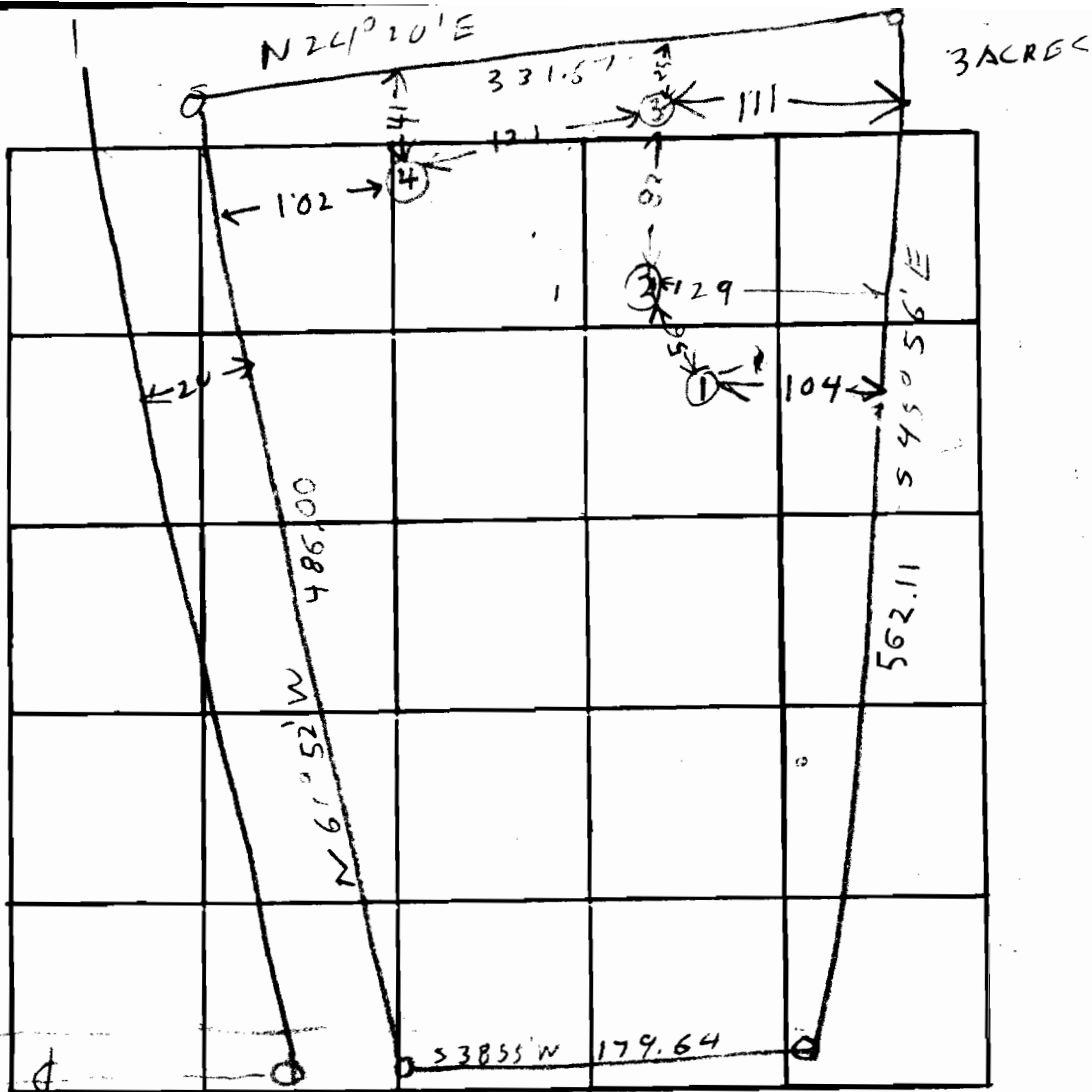

INDICATE NORTH. - NAME ADJOINING ROADWAY AS BASE LINE.

MINK HOLLOW RD

← TO MONTGOMERY COUNTY

DATE	TEST NO.	DEPTH	PRE-WET		TEST - 1" DROP		TIME
			START	STOP	START	STOP	
10/31/75	1	13	1050	1130	little per	FAILED	
	1A	5	1058	1130	little per	FAILED	
	2	12 1/2	1138	1153	1153	1229	28
	2A	4	1227	144	little per	FAILED	
	3	12	1244	145	little per	FAILED	
	3A	4	1246	146	little per	FAILED	
	4	4 1/2	153	208	208	240	32
	4A	1 1/2	156	254	little per	FAILED	
10/31/75	2B	6	222	232	little per	FAILED	

REMARKS _____

TYPE OF SOIL _____

TESTED BY R. HODGES

EDWARD LOPEZ
ALSO PRESENT: BRUCE MCNEIL