



Health

Building Permit Application

Howard County Maryland
Department of Inspections, Licenses and Permits
3430 Court House Drive
Permits: 410-313-2455
www.howardcounty.md.gov

DILP 2016 JUN 20 AM 11:2

Date Received:

Permit No.: B16002763

Building Address: 14389 Howard Rd.
City: Dayton State: MD Zip Code: 21036
Suite/Apt. # SDP/WP/BA #:
Census Tract: Subdivision:
Section: Area: Lot:
Tax Map: Parcel: Grid:
Zoning: Map Coordinates: Lot Size:

Property Owner's Name: THOMAS DENAULT
Address: 14389 Howard Rd.
City: Dayton State: MD Zip Code: 21036
Phone: 301-793-8114 Fax:
Email: Jakedog35@verizon.net
Applicant's Name & Mailing Address, (if other than stated herein)
Applicant's Name:
Address:
City: State: Zip Code:
Phone: Fax:
Email:

Existing Use: EXISTING LAND
Proposed Use: WORKSHOP
Estimated Construction Cost: \$ 50K
Description of Work: Build 2000 sq. foot Pole Barn
Occupant or Tenant: N/A
Was tenant space previously occupied? Yes No
Contact Name:
Address:
City: State: Zip Code:
Phone: Fax:
Email:

Contractor Company: HOMEOWNER
Contact Person: HOMEOWNER
Address:
City: State: Zip Code:
License No.:
Phone: Fax:
Engineer/Architect Company:
Responsible Design Prof.:
Address:
City: State: Zip Code:
Phone: Fax:
Email:

Commercial Building Characteristics
Residential Building Characteristics
Height:
No. of stories:
Gross area, sq. ft./floor:
Area of construction (sq. ft.):
Use group:
Construction type:
Reinforced Concrete
Structural Steel
Masonry
Wood Frame
State Certified Modular
Roadside Tree Project Permit
Roadside Tree Project Permit #

Utilities
Water Supply
Sewage Disposal
Heating System
Sprinkler System
Grading Permit Number:
Building Shell Permit Number:

THE UNDERSIGNED HEREBY CERTIFIES AND AGREES AS FOLLOWS: (1) THAT HE/SHE IS AUTHORIZED TO MAKE THIS APPLICATION; (2) THAT THE INFORMATION IS CORRECT; (3) THAT HE/SHE WILL COMPLY WITH ALL REGULATIONS OF HOWARD COUNTY WHICH ARE APPLICABLE THERETO; (4) THAT HE/SHE WILL PERFORM NO WORK ON THE ABOVE REFERENCED PROPERTY NOT SPECIFICALLY DESCRIBED IN THIS APPLICATION; (5) THAT HE/SHE GRANTS COUNTY OFFICIALS THE RIGHT TO ENTER ONTO THIS PROPERTY FOR THE PURPOSE OF INSPECTING THE WORK PERMITTED AND POSTING NOTICES.

Applicant's Signature: Jakedog35@verizon.net
Print Name: THOMAS DENAULT
Date: 6.20-16
Title/Company:

Checks Payable to: DIRECTOR OF FINANCE OF HOWARD COUNTY
\*\*PLEASE WRITE NEATLY & LEGIBLY\*\*
-FOR OFFICE USE ONLY-

Table with columns: AGENCY, DATE, SIGNATURE OF APPROVAL. Rows include State Highways, Building Officials, PSZA (Zoning), PSZA (Engineering), Health.

Table with columns: DPZ SETBACK INFORMATION. Rows include Front, Rear, Side, Side St., All minimum setbacks met?, Is Entrance Permit Required?, Historic District?, Lot Coverage for New Town Zone, SDP/Red-line approval date.

Table with columns: Filing Fee, Permit Fee, Tech Fee, Excise Tax, PSFS, Guaranty Fund, Add'l per Fee, Total Fees, Sub- Total Paid, Balance Due, Check #.

Distribution of Copies: White: Building Official, Green: PSZA, Zoning, Yellow: PSZA, Engineering, Pink: Health, Gold: SHA
T:\Operations\Updated Forms\Building applmp 8.2012.docx

166885

Lot Number: 3  
Block/Section: -  
Plat Reference: 9376  
Title of Plat: A Minor Subdivision Plat  
For Lots 1-4, Kennard  
Warfield Jr.



Location Drawing

Scale: 1" = 80'

This plat is of benefit to a consumer only insofar as it is required by a lender or a title insurance company or its agent in connection with contemplated transfer, financing or refinancing. This plat is not to be relied upon for the establishment or location of fences, garages, buildings, dwellings or other existing or future improvements. The accuracy of measured distances is approximately ten feet. This plat does not provide for the accurate identification of property boundary lines, but such identification may not be required for the transfer of title or securing financing or refinancing. The approximate location of the dwelling is shown in relation to the apparent property lines. The undersigned surveyor was in charge of preparing this plat.

14389 Howard Road  
Howard County, Maryland

*William T. Matthes* 1/27/14

**Ruxton Design Corporation**

9475 Deereco Road  
Suite B200  
Timonium, Maryland 21093

410-823-5000  
410-823-0115fax

rdc@ruxtondesign.com www.ruxtondesign.com

UTS-8728

Lot 4


Lot 2

Approved Septic System Plan  
Howard County Health Department

*Rana Bevel* 7-18-16  
Signature Date

NTS - Pole Base

No additional attachments ROAD

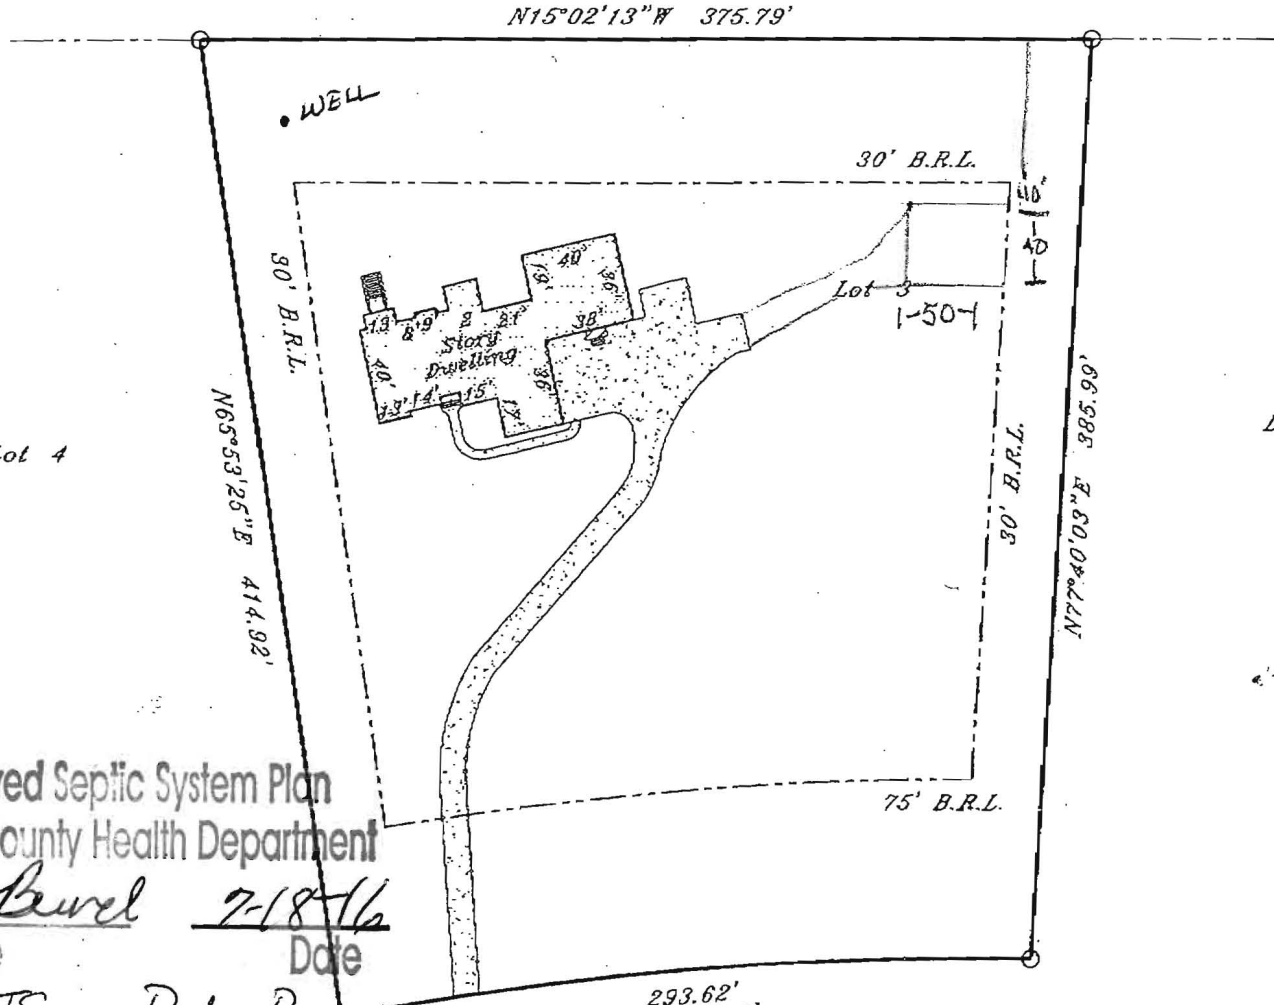

293.62'  
R=1500.00'