

LAYOUT 10/6/03 11AM INSP 4 _____
INSP 2 _____ INSP 5 _____
INSP 3 _____ INSP 6 _____

ISSUE DATE: 10/1/2003
APPROVAL DATE: 10/14/03

PERMIT

P 519596
A 519007

**ON-SITE SEWAGE DISPOSAL SYSTEM
HOWARD COUNTY HEALTH DEPARTMENT
BUREAU OF ENVIRONMENTAL HEALTH
3525-H ELLICOTT MILLS DRIVE, ELLICOTT CITY, MD 21043**


Jack Fyock Septic Service, Inc IS PERMITTED TO INSTALL ALTER
ADDRESS: PO Box 89, Glenelg MD 21737 PHONE NUMBER: 410-988-9270
SUBDIVISION: Dzubak Property LOT NUMBER: TM 40, P 7
ADDRESS: 7215 Mink Hollow Road PROPERTY OWNER: Dzubak
SEPTIC TANK CAPACITY (GALLONS): 1250 OUTLET BAFFLE FILTER REQUIRED
PUMP CHAMBER CAPACITY (GALLONS): N/A COMPARTMENTED TANK REQUIRED
NUMBER OF BEDROOMS: 4
SQUARE FEET PER BEDROOM: 180
LINEAR FEET OF TRENCH REQUIRED: 240 HOUSE SERVED BY PUBLIC WATER

TRENCHES:	Trench to be 3.0 feet wide. Inlet 4.0 feet below original grade. Bottom maximum depth 6.0 feet below original grade. Effective area begins at 4.0 feet below original grade. 2.0 feet of stone below distribution pipe.
LOCATION:	Place the distribution box 120' from the lowest EXISTING septic cleanout and 80' from the left lot line. Run (3) 60' trenches on contour to left lot line.
NOTES:	Final approval issued upon proper abandonment of existing septic system.

PLANS APPROVED: MER DATE: 9/17/03

NOTES: PERMIT VOID AFTER 2 YEARS
CONTRACTOR IS RESPONSIBLE FOR SCHEDULING A PRE-CONSTRUCTION INSPECTION FOR ALL INSTALLATIONS
WATERTIGHT SEPTIC TANKS REQUIRED
ALL PARTS OF SEPTIC SYSTEM SHALL BE 100 FEET FROM ANY WATER WELL UNLESS SPECIFICALLY AUTHORIZED
MANHOLE RISERS REQUIRED ON ALL SEPTIC TANKS AND PUMP CHAMBERS UNLESS SPECIFICALLY AUTHORIZED
CONTRACTOR RESPONSIBLE FOR COMPLIANCE WITH APPLICABLE REGULATIONS, GUIDELINES AND THE TERMS OF THIS PERMIT

**NEITHER THE HOWARD COUNTY COUNCIL NOR THE HEALTH DEPARTMENT IS
RESPONSIBLE FOR THE SUCCESSFUL OPERATION OF ANY SYSTEM
PERMITTEE RESPONSIBLE FOR OBTAINING FINAL APPROVAL ON THIS PERMIT
CALL 410-313-2640 FOR INSPECTION OF SEPTIC SYSTEM
DO NOT LEAVE ANY REQUEST FOR INSPECTION ON VOICEMAIL**

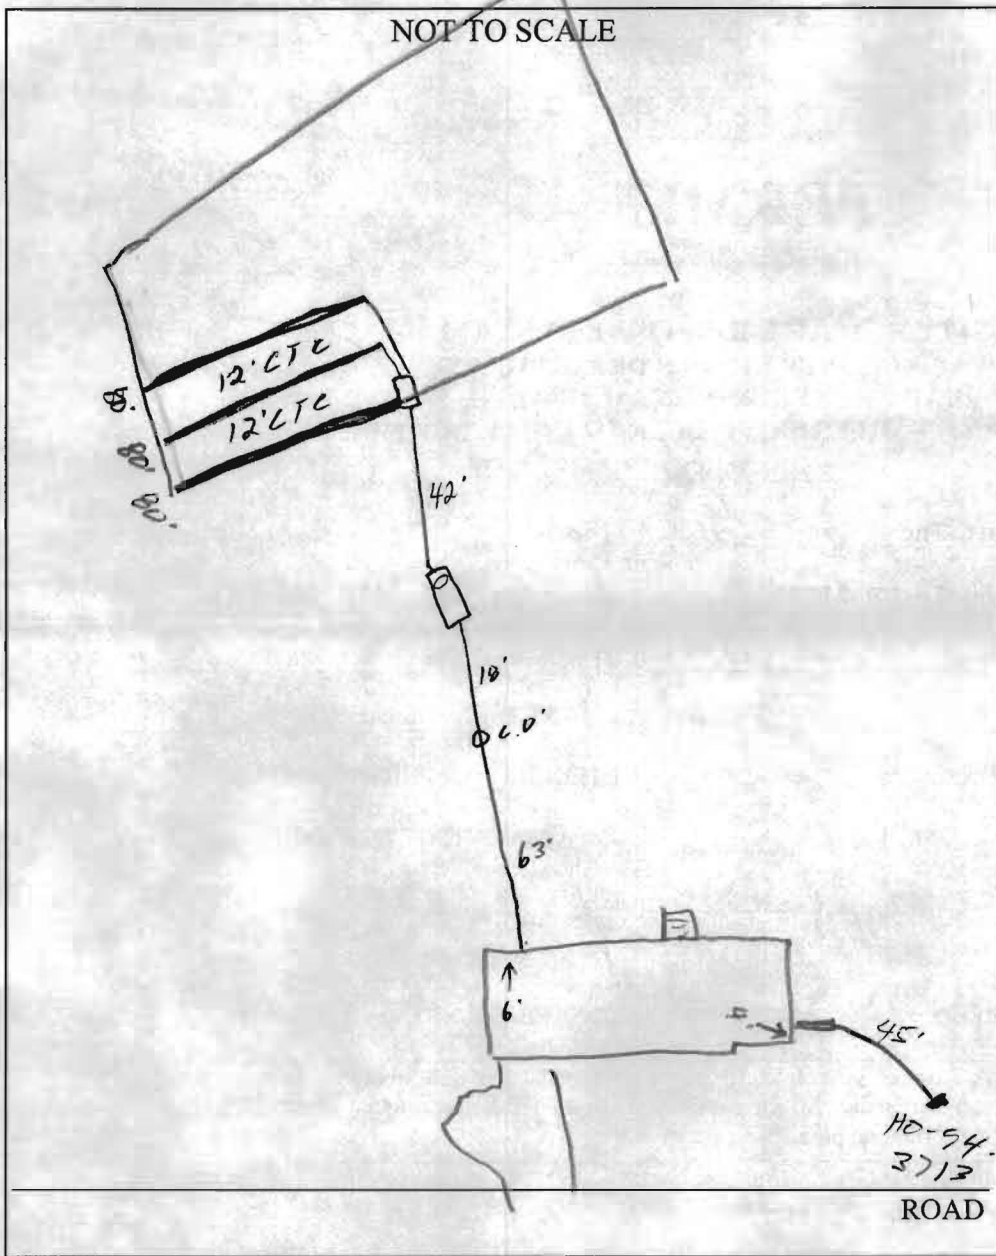

TRENCH/DRAINFIELD DATA		
WIDTH	INLET	BOTTOM
3'	4'	6'
NUMBER OF TRENCHES		3
TOTAL LENGTH		240'
ABSORPTION AREA		720 sq
DISTRIBUTION BOX LEVEL		—
DISTRIBUTION BOX BAFFLE		—
DISTRIBUTION BOX PORT		—

SEPTIC TANK DATA	
SEPTIC TANK 1 LEVEL	✓
CAPACITY	1250 GAL
SEAM LOC	Top
TANK LID DEPTH	1'
BAFFLES	✓
BAFFLE FILTER	—
MANHOLE LOC	Back
6" PORT LOC	—
WATERTIGHT TEST	—
SEPTIC TANK 2 LEVEL	
CAPACITY	— GAL
SEAM LOC	—
TANK LID DEPTH	—
BAFFLES	N/A
BAFFLE FILTER	—
MANHOLE LOC	—
6" PORT LOC	—
WATERTIGHT TEST	—

PRE-CONSTRUCTION 10/6/03 SRA staked; contour appears accurate, install 3 80' trenches on contour. KB/50

INSTALLATION 10/14/03 - OK to cover all work SO

1/26/04 - T.C. to contractor, indicated old septic system has been abandoned SO

FINAL INSPECTOR [Signature] DATE OF APPROVAL 10/14/03

N 56°55'00" E 99'

435

N 43°55'00" E 101'

#7215

MINK HOLLOW ROAD

EX. HOUSE

PROP. HOUSE

S 58°55'00" E 815.70'

1.7 MILES ± TO HIGHLAND RD.

N 62°35'00" E 853.54'

440

435

430

425

420

415

410

405

400

395

390

400

425


SEE 50 SCALE PLAN FOR DETAIL

S 44°57'00" W 136'

DZUBAK PROPERTY

3-5-03

1" = 100'

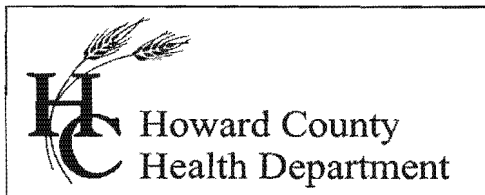

7178 Columbia Gateway Drive, Columbia MD 21046
(410) 313-2640 Fax (410) 313-2648
TDD (410) 313-2323 Toll Free 1-866-313-6300
website: www.hchealth.org

Peter L. Beilenson , M.D., M.P.H., Health Officer

MEMORANDUM

TO: Thomas Frey
Dept of Inspections. Licenses, and Permits

FROM: Sara Fegel, R.S. *SF*
Well and Septic Program
Development Coordination Section

RE: 7215 Mink Hollow Rd
Use and Occupancy approval

DATE: September 5, 2007

Regarding the referenced property, the Health Department approved the septic system on 9/17/03, the well line was approved on 10/14/03 and approvable water samples were received on 12/30/03 and 1/13/04.

NOTE:

1. EXISTING 1 STY. FRAME DWELLING TO BE VACATED AND DEMOLISHED UPON COMPLETION AND OCCUPANCY OF PROP. HOUSE.
2. EXISTING WELL AND SEPTIC SYSTEM TO BE ABANDONED UPON OCCUPANCY OF PROPOSED HOUSE AND PRIOR TO DEMOLITION OF EXISTING HOUSE. EX. WELL TO BE FILLED AND SEALED BY WELL DRILLER.

PROP. DRIVE SECTION
NO. SCALE



SEPTIC DATA

HOUSE F.F.	4437
" BSMT.	4340
" SEWER INV.	4313
SEPTIC INV. IN TANK " OUT	4280
" FIN. GR.	4283
DISTR. INV. IN BOX FIN. GR.	4310
WATER EX. " WELL FIN. "	4273
	4313
	4395
	"

NOTE: TRENCH LENGTH TO BE DETERMINED AT TIME OF SEPTIC PERMIT ISSUANCE.

NOTE: AREA OF DISTURBANCE TO BE THE IMMEDIATE PERIMETER AROUND THE PROPOSED HOUSE, ENTRY POINTS, CONCRETE SLABS, AND DRIVEWAY TIE IN; THUS MINIMIZING DISTURBANCE TO EXISTING LAWN. DISTURBED AREA = 4750 sq ft

Approved Septic System Plan
Howard County Health Department

Mark Refkin 8/12/03
Signature Date

ENGINEER
JOHN L. SCHNEIDER
100 N. ROLLING RD.
CATONSVILLE, MD.
21228
PHONE: 410 744 1945

PROPERTY OWNERS:
JACQUELINE DZUBAK
JONATHAN DZUBAK
7215 MINK HOLLOW RD.
HIGHLAND, MD. 20777
PHONE 301 854 0881

PLOT PLAN

SCALE: 1" = 50'	APPROVED BY:	DRAWN BY TGM
DATE: 7-9-03		REVISED
DZUBAK PROPERTY - PARCEL 17-GRID 7 7215 MINK HOLLOW RD. MAP 40		DRAWING NUMBER 311
5th ELECTION DISTRICT HOWARD COUNTY, MARYLAND		

