

12/03
6/19/03
9-00

APPLICATION

PERCOLATION TESTING

A _____

P _____

HOWARD COUNTY HEALTH DEPARTMENT
BUREAU OF ENVIRONMENTAL HEALTH
3525-H ELLICOTT MILLS DRIVE/ELLICOTT CITY, MARYLAND 21043
TELEPHONE: 313-2640

DISTRICT 5th

DATE May 1st, 2003

TO: THE COUNTY HEALTH OFFICER
ELLICOTT CITY, MARYLAND

I HEREBY APPLY FOR THE NECESSARY TEST PRIOR TO APPLICATION FOR PERMIT TO CONSTRUCT (OR RECONSTRUCT) A SEWAGE DISPOSAL SYSTEM.

PROPERTY OWNER Jacqueline Dzubak and Jonathan Dzubak

ADDRESS 7215 Mink Hollow Road Highland, MD 20777 PHONE (301) 854-0881

AGENT OR PROSPECTIVE BUYER _____

ADDRESS _____ PHONE _____

PROPERTY LOCATION: 7215 Mink Hollow Road

SUBDIVISION _____ LOT NO. _____

ROAD AND DESCRIPTION Mink Hollow Road (paved road)

TAX MAP 40 PARCEL # 17 Grid 7

SIZE OF LOT 3 acres TYPE BLDG. Single Family Dwelling
(SINGLE FAMILY DWELLING OR COMMERCIAL)

THE SYSTEM INSTALLED UNDER THIS APPLICATION IS ACCEPTABLE ONLY UNTIL PUBLIC FACILITIES BECOME AVAILABLE. I FULLY UNDERSTAND THE FEE CONNECTED WITH THE FILING OF THIS PERC TEST APPLICATION IS NON-REFUNDABLE UNDER ANY CIRCUMSTANCES. I ALSO AGREE TO COMPLY WITH ALL M.O.S.H.A. REQUIREMENTS IN TESTING THIS LOT.

(SIGNATURE OF APPLICANT)

APPROVED BY _____ FOR _____ DATE _____

DISAPPROVED BY _____ FOR _____ DATE _____

HOLD PENDING FURTHER TESTS _____

REASONS FOR REJECTION OR HOLDING _____


PERCOLATION TEST PLAT/PRELIMINARY PLAT - TITLE OR I.D. # _____ DATE _____

SITE DEVELOPMENT PLAN/FINAL PLAT - TITLE OR I.D. # _____ DATE _____

THIS IS NOT A PERMIT

A/P

① ⑥
 orge brn
 hvy lm
 3 1/2
 tan gray
 sa mi
 lm
 15-25%
 frags
 15 1/2

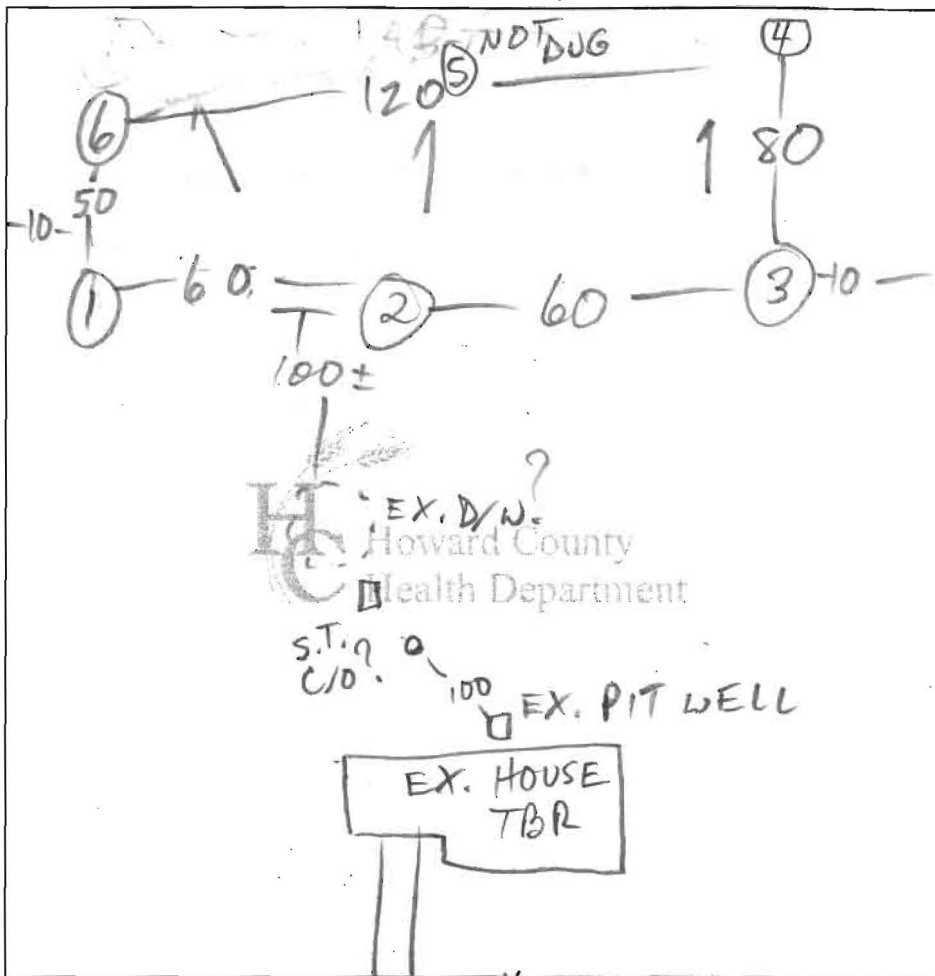

② ③
 orge red
 hvy lm
 4 1/2
 orge red
 mi lm
 15-20%
 frags
 9
 lt. brn
 brn red
 sa mi lm
 20% frags
 15 1/2

MINK HOLLOW RD

DATE	TEST #	DEPTH	START	BREAK 1" DROP	STOP 2" DROP	TIME OF 2nd INCH	P/F/H
6/12/03	1 S V	4 1/2 15 1/2	10:04	10:05	10:08	3	
	2 V	13 1/2					
	3 S V	5 1/2 13	10:13	10:15	10:19	4	
	4 S	4 1/2 12 1/2 12 1/2	10:24 10:37	10:32 10:48	SLOW SLOW		
	4 S2	6	11:13 11:15	11:14 11:16	11:15 11:18	1 2	
	6 S V	4 1/2 13	10:52	10:54	10:58	4	

4
 red orge
 hvy lm
 5
 orge
 tan yel
 sand
 15-20%
 frags
 12 1/2

REMARKS _____
 SANITARIAN M. Ripkin BACKHOE _____ OTHERS _____
 TEST HOLES USED IN SDA _____ AVG. PERC TIME _____ SQ. FT/BR 180
 TRENCH WIDTH 3 INLET DEPTH 4 MAX. BOT DEPTH 6 EFFECTIVE SW 2