

# APPLICATION

A 08610

SEWAGE DISPOSAL TESTING

P \_\_\_\_\_

MARYLAND STATE DEPARTMENT OF HEALTH

HOWARD COUNTY

ELLICOTT CITY

DISTRICT 5

DATE 6/12/64

*Notify Mr. Beavis when site job is completed & approved.*

*one 9'x12' dry well in area slated.*

TO: THE COUNTY HEALTH OFFICER  
ELLICOTT CITY, MARYLAND

I, HEREBY, APPLY FOR THE NECESSARY TESTS IN ORDER TO CONSTRUCT (OR RECONSTRUCT) A SEWAGE DISPOSAL SYSTEM.

PROPERTY OWNER A. N. Rush

ADDRESS Mink Hollow Road, Highland, Maryland PHONE 774-9372

PROPERTY LOCATION:

SUBDIVISION \_\_\_\_\_ LOT NO. \_\_\_\_\_

ROAD AND DESCRIPTION Mink Hollow Rd., 3rd from River up - mailbox has name on it - directly across from Mr. Woods property.

OCCUPANT \_\_\_\_\_ PHONE \_\_\_\_\_

PERSON TO CONSTRUCT SYSTEM \_\_\_\_\_

ADDRESS \_\_\_\_\_ PHONE \_\_\_\_\_

SIZE OF LOT 6 1/2 acres TYPE BLDG. 3  
NUMBER OF BEDROOMS

IF NOT SINGLE RESIDENCE DESCRIBE \_\_\_\_\_

SIGNATURE OF APPLICANT Andrew N. Rush


APPROVED BY Palmer F. Wene FOR dry well DATE 6/16/64  
(KIND OF SYSTEM)

REJECTED BY \_\_\_\_\_ FOR \_\_\_\_\_ DATE \_\_\_\_\_  
(KIND OF SYSTEM)

HOLD PENDING FURTHER TESTS \_\_\_\_\_ DATE \_\_\_\_\_

REASONS FOR REJECTION OR HOLDING \_\_\_\_\_

# THIS IS NOT A PERMIT

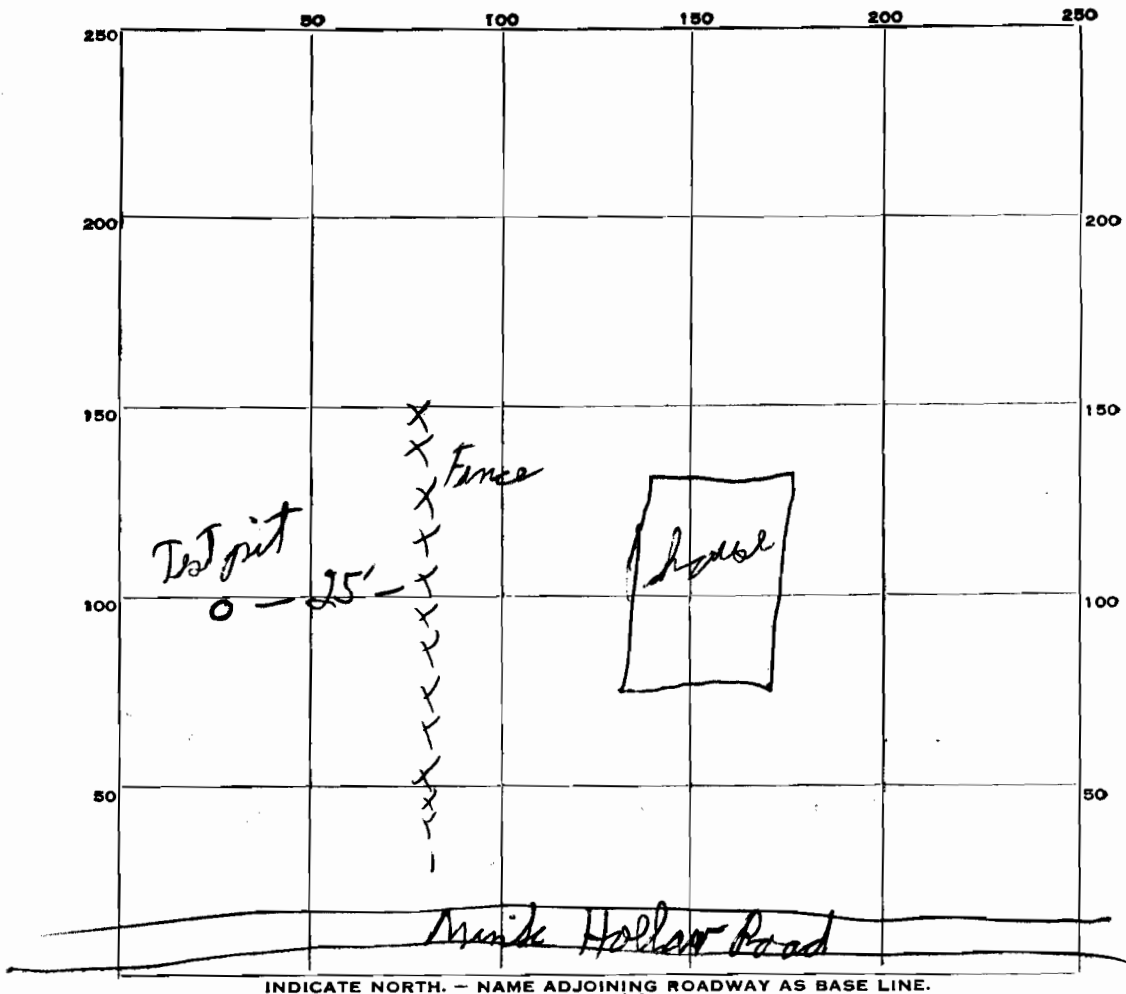

| DATE    | TEST NO. | DEPTH | PRE-WET |       | TEST - 1" DROP |       | TIME   |
|---------|----------|-------|---------|-------|----------------|-------|--------|
|         |          |       | START   | STOP  | START          | STOP  |        |
| 6/16/04 | 1        | 9'    | 12:50   | 12:53 | 12:53          | 12:57 | 4 min. |
|         |          |       |         |       |                |       |        |
|         |          |       |         |       |                |       |        |
SOIL AUGER FINDING clay lat. few feet

TESTED BY Palmer F. Wine

REMARKS repair job

ALSO PRESENT Earlene Theberge LOT NO.

HOWARD COUNTY HEALTH DEPARTMENT

FILE \_\_\_\_\_ DATE REPORTED \_\_\_\_\_

PROPERTY OWNER \_\_\_\_\_

P.O. ADDRESS \_\_\_\_\_ TELEPHONE \_\_\_\_\_

DIRECTIONS TO PROPERTY \_\_\_\_\_

INFORMANT \_\_\_\_\_

CONDITION FOUND *6-10-64* House at present is a three bedroom home with kitchen, dining room and bath. Adding two extra baths, a extra living room, porch, two car garage and kitchen. Five members in family - no increase.

ACTION TAKEN *6-10-64* Phoned Mr. Early's office (secretary) and told her not to issue any plumbing permits. JH.

*6-15-64* Mr. Rush came in *6-12-64* and made out perm. application and test to be run *6-16-64*. JH.

Sanitarian *James E. Hennigan*

Want to install bath, etc.  
Amiel Rush  
Mink Hollow Rd.  
N.W. side

Notify Early at  
Plumbing Dept.  
~~school~~  
PT 6-2122 Spring Home 9372  
Mink Hollow Rd.