

APPLICATION

FOR PERCOLATION TESTING AND SITE EVALUATION

TEST DATE(S) _____ TEST TIME _____ A/P _____

AGENCY REVIEW: _____ DATE 11/29/05

DO NOT WRITE ABOVE THIS LINE

I HEREBY APPLY FOR THE NECESSARY TESTING/EVALUATION PRIOR TO ISSUANCE OF SEWAGE DISPOSAL SYSTEM PERMIT(S) TO:

CHECK AS NEEDED:

- CONSTRUCT NEW SEPTIC SYSTEM(S)
- REPAIR/ADD TO AN EXISTING SEPTIC SYSTEM
- REPLACE AN EXISTING SEPTIC SYSTEM

CHECK AS NEEDED:

- NEW STRUCTURE(S)
- ADDITION TO AN EXISTING STRUCTURE
- REPLACE AN EXISTING STRUCTURE

CHECK ONE:

- CREATE NEW LOT(S)
- BUILD ON AN EXISTING LOT IN A SUBDIVISION
- BUILD ON AN EXISTING PARCEL OF RECORD

IS THE PROPERTY WITHIN 2500' OF ANY RESERVOIR?

- YES
- NO

THE TYPE OF STRUCTURE IS:

- RESIDENTIAL WITH _____ PROPOSED BEDROOMS IN THE COMPLETED STRUCTURE (NOTE *UNKNOWN* IF APPROPRIATE)
- COMMERCIAL (PROVIDE DETAIL OF NUMBERS AND TYPES OF EMPLOYEES/ CUSTOMERS ON ACCOMPANYING PLAN)
- INSTITUTIONAL/GOVERNMENT (PROVIDE DETAIL OF NUMBERS AND TYPES OF EMPLOYEES/USERS ON ACCOMPANYING PLAN)

PROPERTY OWNER(S) Frances Deulin

DAYTIME PHONE 410-997-4600 CELL _____ FAX _____

MAILING ADDRESS Echo Farm Rt 3, 43 East Litchfield Litchfield CT 06750
STREET CITY/TOWN STATE ZIP

APPLICANT Heritage LAND DEVELOPMENT

DAYTIME PHONE 410-489-7900 CELL 410-982-2882 FAX 410-489-9768

MAILING ADDRESS 3060 Washington Rd Glenwood Md 21738
STREET CITY/TOWN STATE ZIP

APPLICANT'S ROLE: DEVELOPER BUILDER BUYER RELATIVE/FRIEND REALTOR CONSULTANT

PROPERTY LOCATION
SUBDIVISION/PROPERTY NAME Merriweather Farm LOT NO. _____

PROPERTY ADDRESS 14944 Roxbury Road
STREET TOWN/POST OFFICE

TAX MAP PAGE(S) 21 GRID _____ PARCEL(S) 28 PROPOSED LOT SIZE _____

AS APPLICANT, I UNDERSTAND THE FOLLOWING: THE SYSTEM INSTALLED SUBSEQUENT TO THIS APPLICATION IS ACCEPTABLE ONLY UNTIL PUBLIC SEWERAGE IS AVAILABLE. THIS APPLICATION IS COMPLETE WHEN ALL APPLICABLE FEES AND A SUITABLE SITE PLAN HAVE BEEN RECEIVED. I ACCEPT THE RESPONSIBILITY FOR COMPLIANCE WITH ALL M.O.S.H.A. AND "MISS UTILITY" REQUIREMENTS. APPROVAL IS BASED UPON SATISFACTORY REVIEW OF A PERC CERTIFICATION PLAN.

TEST RESULTS WILL BE MAILED TO APPLICANT. _____
SIGNATURE OF APPLICANT


HOWARD COUNTY HEALTH DEPARTMENT, BUREAU OF ENVIRONMENTAL HEALTH, WELL AND SEPTIC PROGRAM
3525-H ELLICOTT MILLS DRIVE, ELLICOTT CITY, MARYLAND 21043-4544 (410) 313-1771 FAX (410) 313-2648
TDD (410) 313-2323 TOLL FREE 1-877-4MD-DHMH

AP
 6021
 WK org rd brn
 hvyl SL
 2'±
 Dk brn
 Loam
 pockets
 SL
 4'
 HKy brn
 FS/LS
 Chert
 10%
 Bottom 13'

6024
 Str rd
 SL
 2'
 org brn,
 rd
 med
 gr SAND
 pockets
 decomposed
 parent material
 (pockets
 of med coarse
 SAND)
 had
 small
 ledge
 (granite
 or gneiss)
 Bottom 14'

N
 Side
 9'

6022
 org brn
 hvyl
 2'
 Str org
 SAND
 med gr.
 Trace
 Py
 Bottom 13½'

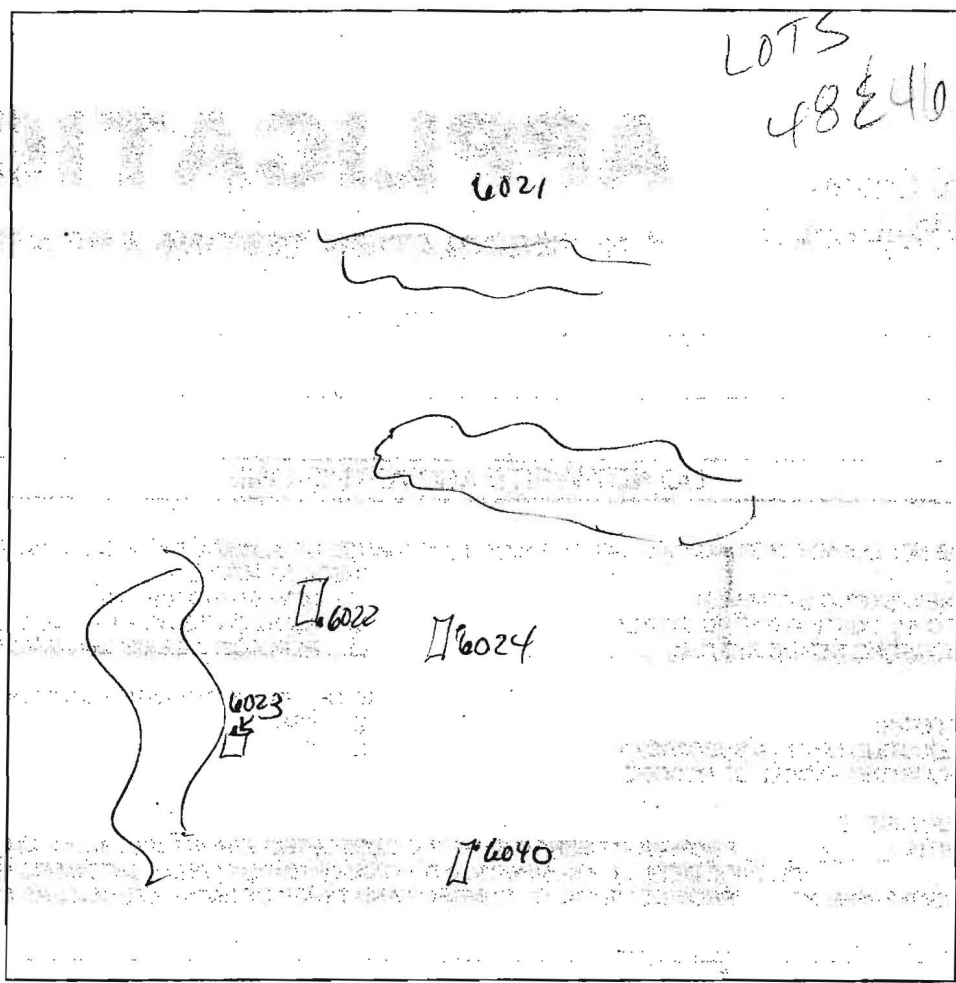

LOTS
 48 & 40

6040

6025
 LS-S
 3'
 med gr
 SAND
 compact
 single
 grain
 Bottom 14'

DATE	TEST #	DEPTH	START	BREAK 1" DROP	STOP 2" DROP	TIME OF 2nd INCH	P/F/H
11-29-05	6021	3'3"	10:45	10:56	10:57	26	P LOT 48
6" perc hole	6024	3'	10:57	10:58	11:00	2	P
	6023	Refusal @ 2'					
	6040	@ 3'					
	6022	SEE 6021	11:05	11:10	11:16	6	P
	6022	SEE 6024					
	6025	3'	11:17	11:20	11:27	7	P


Makes dug on stake

REMARKS TESTING ON KNOW / PLenty of TX ZONE prop. well loc
 SANITARIAN Kacie BACKHOE OTHERS
 TEST HOLES USED IN SDA _____ AVG. PERC TIME _____ SQ. FT/BR _____
 TRENCH WIDTH _____ INLET DEPTH _____ MAX. BOT DEPTH _____ EFFECTIVE SW _____

AP 5129
 Brown L 11'
 Red/Orange Sol w/ 10% flangy Red 4'
 Red/Yellow SC 5 1/2'
 Yellow/Brown SL w/ Arrow Pin 11'

6012
 Brown L 1'
 Red/Orange Sol 4'
 Yellow/Brown SL 8'
 Yellow/Grey SL w/ Arrow Pin 9'

5128
 Brown L 1'
 Red/Orange Sol 4'
 Yellow/Brown SL 7 1/2'
 Grey/Brown SL w/ 20% Flangy Red 9'

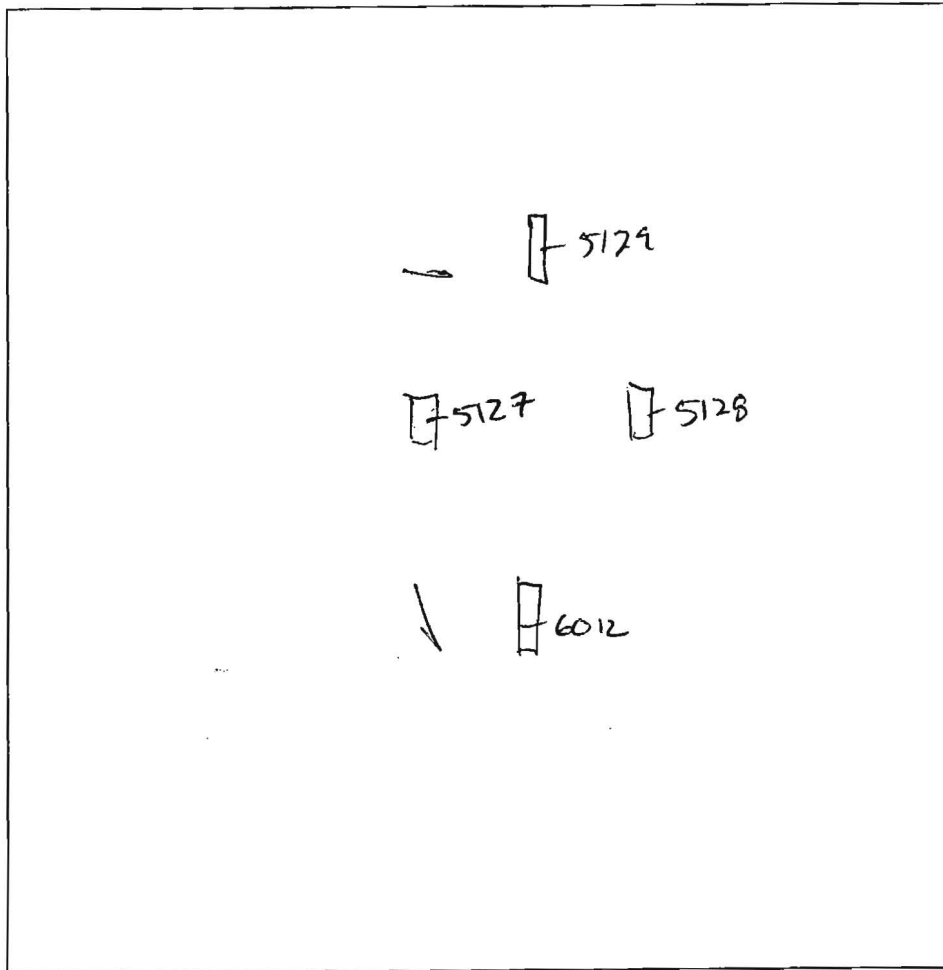

5127
 Brown L 1'
 Red/Orange Sol 4'
 Yellow/Brown SL 9 1/2'
 Yellow/Brown S 14'

DATE	TEST #	DEPTH	START	BREAK 1" DROP	STOP 2" DROP	TIME OF 2nd INCH	P/F/H
9/16/61	5129	4 1/2" / 11"	18:57	1:00	1:02	2 min	P
	6012	4" / 9"	2:13	2:17	2:32	5 min	P
	5128	9"	- Visual -			OK	P
	5127	4 1/2" / 14"	2:25	2:27	2:30	3 min	P

REMARKS lot 49
 SANITARIAN _____ BACKHOE _____ OTHERS _____
 TEST HOLES USED IN SDA _____ AVG. PERC TIME _____ SQ. FT/BR _____
 TRENCH WIDTH _____ INLET DEPTH _____ MAX. BOT DEPTH _____ EFFECTIVE S/W _____

Wetland Buffer

PRIVATELY OWNED
EASEMENT HOLDERS: H.O.A. & HO. CO., MD.
**BUILDABLE
PRESERVATION
PARCEL 'A'**
111.88 AC.

*Approved P-plan
1/25/08*

LOT 31
49,294 sq. ft.

PRIVATE 20' DRAINAGE &
UTILITY EASEMENT

PRIVATE S.W.M. DRAINAGE &
UTILITY EASEMENT

B.M.P. No.
BIO-RETENTION
6010

P18

B.M.P. No. 10
LEVEL SPREADER

P19

LOT 29
49,973 sq. ft.

LOT 30
46,236 sq. ft.

LOT 22
49,182 sq. ft.

LOT 23
42,383 sq. ft.

24,000 GAL. TANK FOR
RURAL WATER SUPPLY
& DRY HYDRANT

ROAD 'B'
(PUBLIC ACCESS STREET)

55'x20' W/10' TAPERS
FOR FIRE TRUCK PULL-
OFF

PRIVATELY OWNED
**BUILDABLE
PRESERVATION
PARCEL 'A'**
111.88 AC.

P16

