

PERMIT

SEWAGE DISPOSAL SYSTEM

MARYLAND STATE DEPARTMENT OF HEALTH

HOWARD COUNTY

ELLICOTT CITY

DISTRICT 5th

DATE 9/16/76

*Approved
HB
11-23-76* INDEX

23932

18677

William Hopkins

IS PERMITTED TO INSTALL ALTER

ADDRESS Jennings Chapel Road, Woodbine, Md. 21897

PHONE 489-4711

A SEWAGE DISPOSAL SYSTEM LOCATED AT

(all the way to end of road)

SUBDIVISION Country Farm Lane

ROAD 7465 Mink Hollow Road

LOT Parcel 15

PROPERTY OWNER David E. Rosquist

ADDRESS 4506 Oaklyn Lane, Bowie, Md.

Phone: 262-4038

SPECIFICATIONS 3 bedrooms

DRAIN FIELD _____ DEPTH _____ FEET, BOTTOM AREA _____ SQ. FT.

SEEPAGE PITS _____ ABSORBENT SIDE-WALL AREA _____ SQ. FT.

SEPTIC TANK CAPACITY 1000 GALLONS

FOR GARBAGE GRINDER, INCREASE DISPOSAL AREA 22% & TANK CAPACITY 50%.

OTHER DRY WELL - To have 120 sq. ft. effective absorbent sidewall area per bedroom below the first 3 1/2 ft. of non-absorbent ground at original grade. Maximum depth of dry well is to be 11 1/2 ft. Locate dry well 75 ft. from the 904.76 ft. lot line and 255 ft. from the court lot line at the front of the lot.

NOTE: ALL PIPE FROM HOUSE TO DISPOSAL AREA MUST BE CAST IRON.

PERMIT VOID AFTER THREE YEARS

NOTE: INSTALL STAND PIPE ON SEPTIC TANK AND DRY WELL. STAND PIPES MUST BE 6

INCHES IN DIAMETER. CAST IRON, CONCRETE, OR TERRA COTTA ACCEPTED

PLANS APPROVED BY William W. Zepp

DATE 9/11/73

FILL SEPTIC TANK AND DISTRIBUTION BOX WITH WATER BEFORE CALLING FOR AN INSPECTION. COVER NO WORK UNTIL INSPECTED AND APPROVED.

NEITHER THE HOWARD COUNTY COMMISSIONERS NOR THE HEALTH DEPARTMENT IS RESPONSIBLE FOR THE SUCCESSFUL OPERATION OF ANY SYSTEM.


BLDG. PERMIT SIGNED
AND RETURNED 5/28/82
for pool

18677

INSPECTOR APPROVED

Location
OK

1 1/2
8
51
408

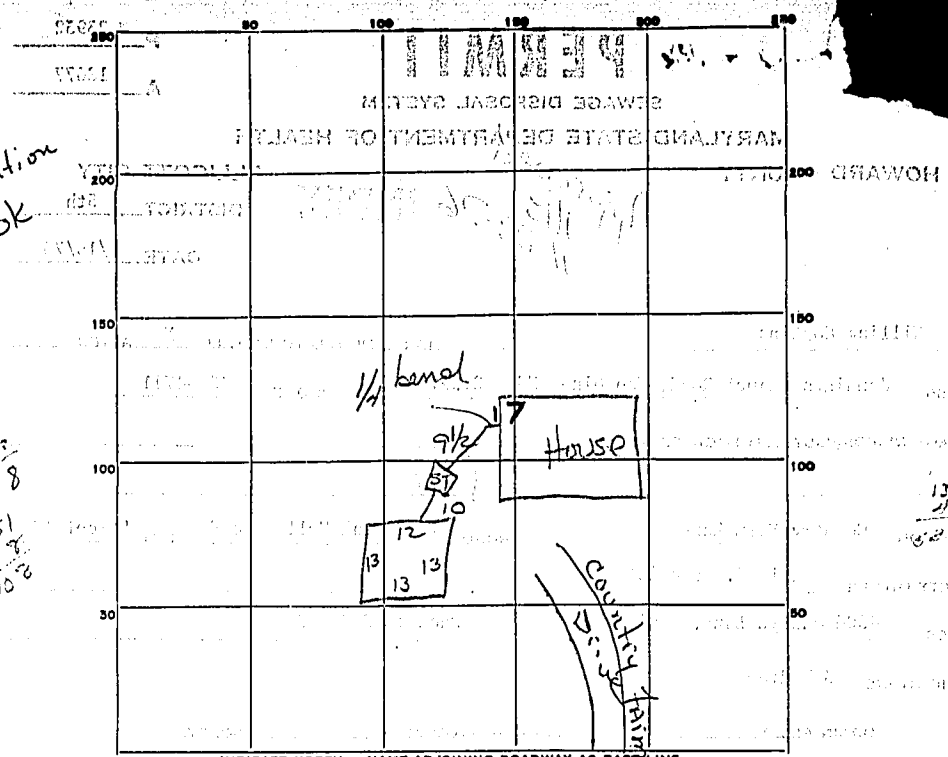

INDICATE NORTH. - NAME ADJOINING ROADWAY AS BASE LINE.

1/2
mink Hollow Rd

PERMIT CARD NO

NW ST
✓ ✓

SEPTIC TANK, LEVEL _____

CLEANOUTS _____

DISTRIBUTION BOX, LEVEL N/A

TILE FIELD, DEPTH N/A FT. TRENCH WIDTH _____ FT.

GRAVEL DEPTH _____ IN. TOTAL LENGTH _____ FT.

NUMBER OF TRENCHES _____ TOTAL BOTTOM AREA _____

SEEPAGE PITS, INSIDE DIAMETER Perimeter 51 FT. DEPTH BELOW INLET 8 FT.

ABSORBENT AREA 408 SQ. FT.

REMARKS _____

NEITHER THE HOWARD COUNTY COMMISSIONERS NOR THE HEALTH DEPARTMENT IS RESPONSIBLE FOR THE SUCCESSFUL OPERATION OF ANY SYSTEM.

DATE SYSTEM APPROVED 11-

INSPECTOR _____