


SITE INSPECTION SHEET

OWNER: Demault PHONE #: _____
ADDRESS: 14389 Howard Rd CONTRACTOR: _____
WELL TAG #: _____
SUBDIVISION: _____ LOT: _____ COUNTY #: _____
PROPOSAL: _____

LOCATION DIAGRAM

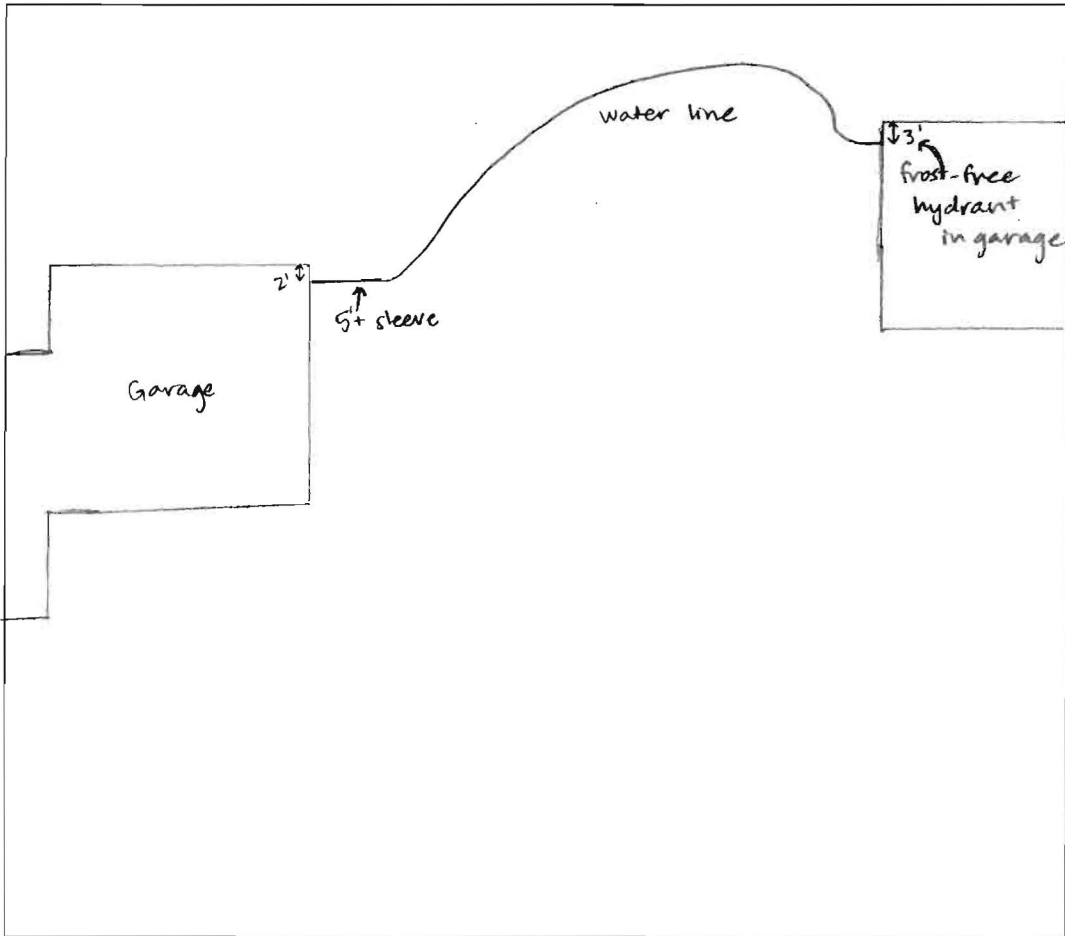

COMMENTS: Michael Runk plumbing ran a water line from the house to a free-standing garage. No new septic in garage.

DATE: 10/7/16 INSPECTOR: S. Collins