


SITE INSPECTION SHEET

OWNER: Dr. Jamilson PHONE #: 301-549-3503
ADDRESS: 11604 Mirror Pond CONTRACTOR: Jay Curley % Jodd Curley
Fulton MD 20759 Count WELL TAG #: HO-94-3011
SUBDIVISION: Pindell LOT: 42 COUNTY #: Howard
PROPOSAL: Woods Deck

LOCATION DIAGRAM

• Well is in front of House away from Construction

(Scale 1-30)

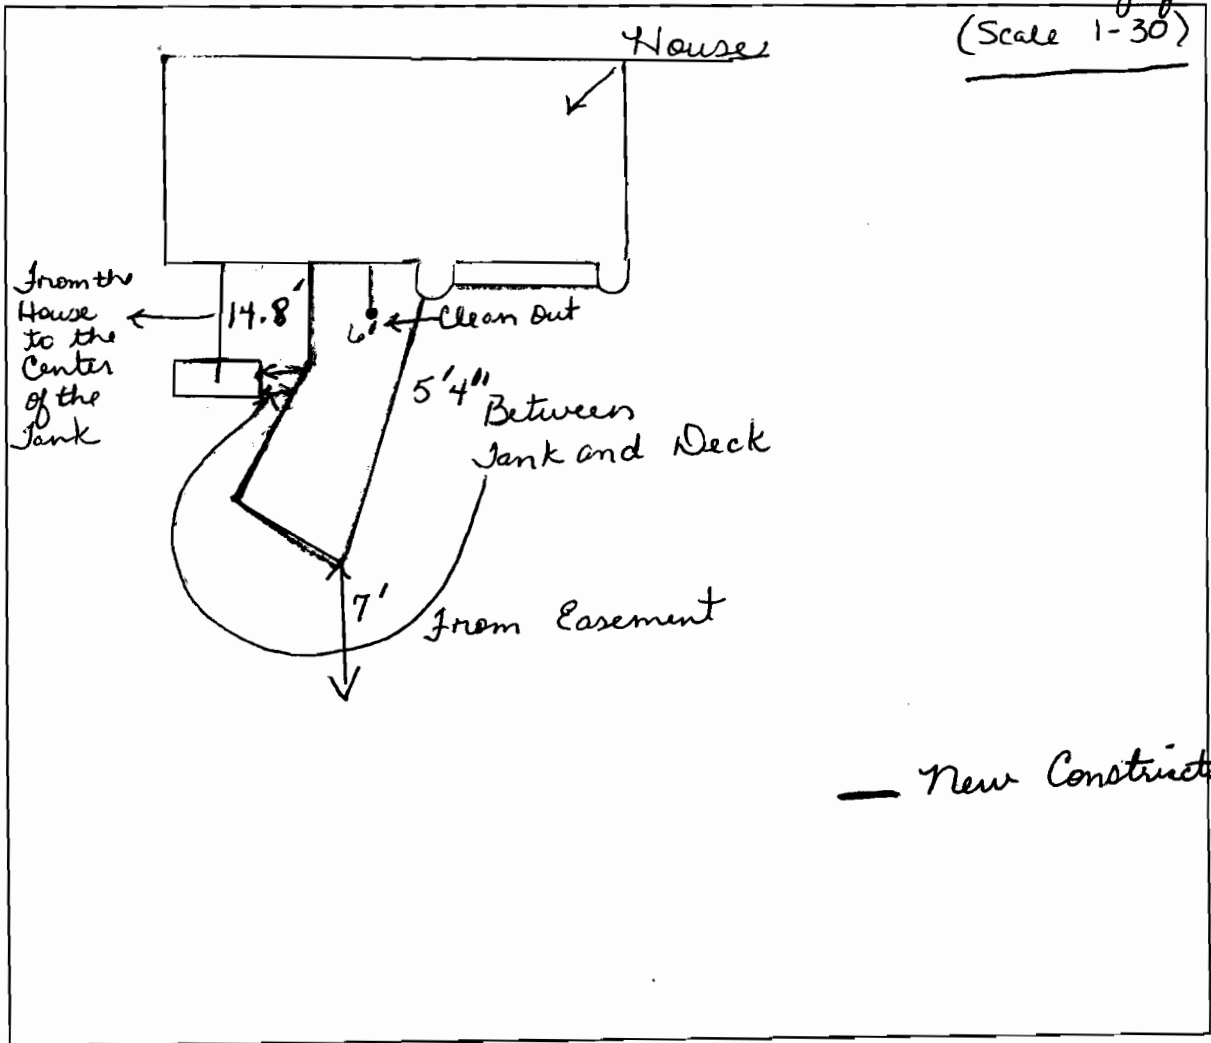

COMMENTS: Site Visit with contractor Jodd Curley
H- 301-549-3503
Cell- 301-440-0657
Measurements taken and applied to drawings
Building Permit # ?

DATE: 7-11-08

INSPECTOR: Dana Bernard