

APPLICATION

PERCOLATION TESTING

A 38/25

P _____

HOWARD COUNTY HEALTH DEPARTMENT
BUREAU OF ENVIRONMENTAL HEALTH
P.O. BOX 476 ELLICOTT CITY, MARYLAND 21043
TELEPHONE: 461-9933

DISTRICT _____

DATE 11/28/86

TO: THE COUNTY HEALTH OFFICER
ELLICOTT CITY, MARYLAND

I, HEREBY, APPLY FOR THE NECESSARY TEST IN ORDER TO CONSTRUCT (OR RECONSTRUCT) A SEWAGE DISPOSAL SYSTEM.

Wayne + Debi Cossetino

PROPERTY OWNER Springhill Associates - c/o D.S. Thaler & Associates, Inc.

ADDRESS 11 Warren Road, Baltimore, MD 21208 PHONE (301) 484-4100

PROSPECTIVE BUYER N/A

ADDRESS _____ PHONE _____

PROPERTY LOCATION:

SUBDIVISION Meadowood LOT NO. 1817

ROAD AND DESCRIPTION Henryton Road - approximately 4000' north of Tunnel Road

Howard County, Maryland

PLUM. PERMIT SIGNED

TAX MAP 10 PARCEL # 139

AND RETURNED 4-15-97

Serial # B 4104861

SIZE OF LOT 3⁺ Acres TYPE BLDG. Single Family 5000s

(SINGLE FAMILY DWELLING OR COMMERCIAL)

THE SYSTEM INSTALLED UNDER THIS APPLICATION IS ACCEPTABLE ONLY UNTIL PUBLIC FACILITIES BECOME AVAILABLE. I FULLY UNDERSTAND THE FEE CONNECTED WITH THE FILING OF THIS PERC TEST APPLICATION IS NON-REFUNDABLE UNDER ANY CIRCUMSTANCES. I ALSO AGREE TO COMPLY WITH ALL M.O.S.H.A. REQUIREMENTS IN TESTING THIS LOT.

Mike Sedgwick
(SIGNATURE OF APPLICANT)

APPROVED BY _____ FOR _____ DATE _____


REJECTED BY _____ FOR _____ DATE _____

HOLD PENDING FURTHER TESTS _____ DATE _____

REASONS FOR REJECTION OR HOLDING _____

THIS IS NOT A PERMIT

LOT 19

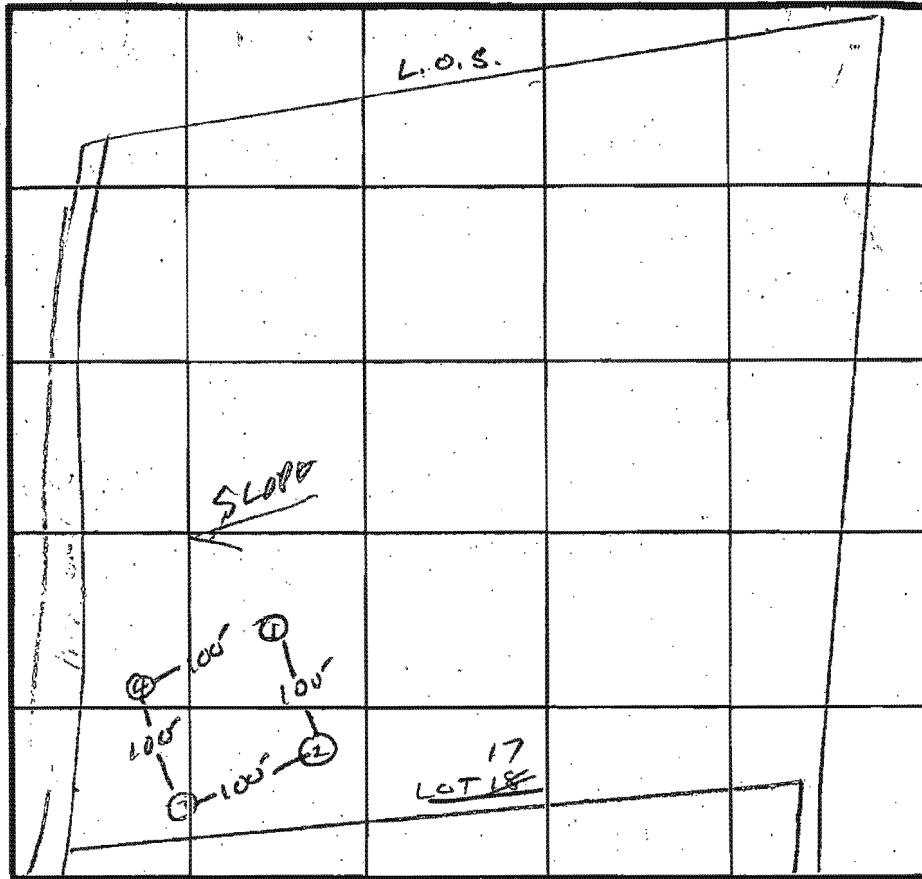

Hole Elevation

- ① HIGHEST
- ② HIGH
- ④ LOWEST
- ③ LOW

X PENETRATION
 1/4 MIN
 200 # BROM
 IN LOT 4
 BOTTOM 8

INDICATE NORTH - NAME ADJOINING ROADWAY AS BASE LINE.

↓ TO HENRYTON Rd.

SOIL PROFILE ① ②

CLAY
 BROWN SAND SILT LOAM

③

BROWN CLAY
 RED BROWN SANDY LOAM

ASHE SAND LOAM
 & COBBLES

④

BROWN CLAY

BROWN SAND SILT LOAM

DATE	TEST NO.	DEPTH	PRE-WET		TEST - 1" DROP		TIME
			START	STOP	START	STOP	
12/10/86	1 S	3.5	209	212	212	214	2
	1 N	8	208	210	210	214	4
	IV	H	OK				
	2 S	4	211	218	218	220	
	2 V	11.5	OK				
	3 S	3.5	224	232	232	302	28
	3 V	11	OK				
	4 S	4	227	244	244	303	19
	4 V	11	OK	OK			

16
3

EH-12-1079

REMARKS _____

TYPE OF SOIL _____

TESTED BY R. Hodgen

ALSO PRESENT FRANK COE
ROCKY
BILL
Ed Owen