

APPLICATION

PERCOLATION TESTING

A _____

P _____

HOWARD COUNTY HEALTH DEPARTMENT
BUREAU OF ENVIRONMENTAL HEALTH
3525-H ELLICOTT MILLS DRIVE/ELLICOTT CITY, MARYLAND 21043
TELEPHONE: 313-2640

DISTRICT _____

DATE _____

TO: THE COUNTY HEALTH OFFICER
ELLICOTT CITY, MARYLAND

I HEREBY APPLY FOR THE NECESSARY TEST PRIOR TO APPLICATION FOR PERMIT TO CONSTRUCT (OR RECONSTRUCT) A SEWAGE DISPOSAL SYSTEM.

PROPERTY OWNER KENNARD WARFIELD JR

ADDRESS 14663 TRIADELPHIA ROAD PHONE 410-442-2337

AGENT OR PROSPECTIVE BUYER LAND DESIGN & DEVELOPMENT

ADDRESS 8000 MAIN STREET ELLICOTT CITY PHONE 410-480-9105

PROPERTY LOCATION:

SUBDIVISION THE WARFIELDS II LOT NO. 15 16

ROAD AND DESCRIPTION SOUTH SIDE OF TRIADELPHIA ROAD AT THE INTERSECTION OF TRIADELPHIA ROAD AND HOWARD ROAD

TAX MAP 21 PARCEL # _____

SIZE OF LOT ONE ACRE TYPE BLDG. SINGLE FAMILY DWELLING
(SINGLE FAMILY DWELLING OR COMMERCIAL)

THE SYSTEM INSTALLED UNDER THIS APPLICATION IS ACCEPTABLE ONLY UNTIL PUBLIC FACILITIES BECOME AVAILABLE. I FULLY UNDERSTAND THE FEE CONNECTED WITH THE FILING OF THIS PERC TEST APPLICATION IS NON-REFUNDABLE UNDER ANY CIRCUMSTANCES. I ALSO AGREE TO COMPLY WITH ALL M.O.S.H.A. REQUIREMENTS IN TESTING THIS LOT.

DONALD R. REUWER
(SIGNATURE OF APPLICANT)

APPROVED BY _____ FOR _____ DATE _____

DISAPPROVED BY _____ FOR _____ DATE _____

HOLD PENDING FURTHER TESTS _____

REASONS FOR REJECTION OR HOLDING _____

PERCOLATION TEST PLAT/PRELIMINARY PLAT - TITLE OR I.D. # _____ DATE _____

SITE DEVELOPMENT PLAN/FINAL PLAT - TITLE OR I.D. # _____ DATE _____

THIS IS NOT A PERMIT

COUNTY #

SOIL PROFILE

0' 6275

orange
brn
hvy lm
25% Rx

5' tan yel

orange
lt. brn
sa lm
25% frags

9'9"

40%
frags

13'

6276

orange brn
hvy lm

4 1/2
-5


tan
sa lm

10%
frags

12 1/2'

6280

orange
brn
hvy lm
25% Rx
40% frags

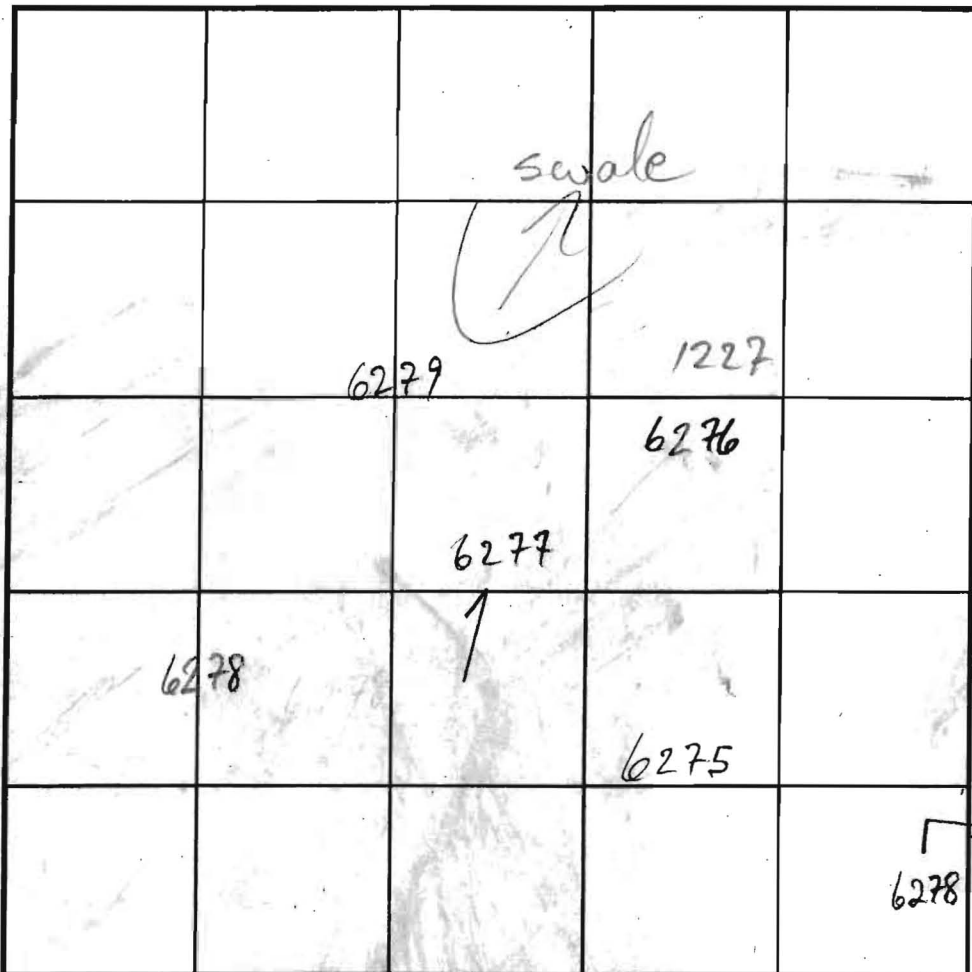

SOIL PROFILE
0' 6277/6279

orange
brn red
cl lm

4 1/2
-6

tan
beige
lt. brn
sa lm

10%
frags

13 1/2
-14

orange brn
hvy lm

tan sa lm
25-40% Rx
HARD BOT
WORSE DOWNHILL

5
9 1/2

INDICATE NORTH - NAME ADJOINING ROADWAY AS BASE LINE. TRIA RD

DATE	TEST NO.	DEPTH	PRE-WET		TEST - 1" DROP		TIME
			START	STOP	START	STOP	
2/10/03	6275 M V	8 13	10:19 MARGINAL	10:22	10:22	10:26	4
	6276 M V	6'9" / 12'3"	10:25	10:27	10:27	10:36	9
	6278 M V	7 9 1/2	10:08 MARGINAL	10:11	10:11	10:15	4
2/5/03	6277 S V	6 1/2 14	4:02	4:06	4:06	4:11	5
	6279 S V	7 13 1/2	4:09	4:12	4:12	4:17	5
8/13/03	1227 V	7'8"	ROCK	REFUSAL	6'CL	R	

REMARKS ALL HOLES PER PLAN; BEST COMBINED W/LOT 16 AND ADJUSTED DOWN


TYPE OF SOIL _____ TESTED BY M. Rifkin, F. Alfonso ALSO PRESENT Mike L. Crow, Tori M.

TRENCH DESIGN DATA: AVERAGE PERCOLATION TIME _____ TRENCH WIDTH _____

INLET DEPTH _____ MAXIMUM BOTTOM DEPTH _____ SQ. FT./BEDROOM _____

TRIADELPHIA

MINOR COLLECTOR
(60' R/W)

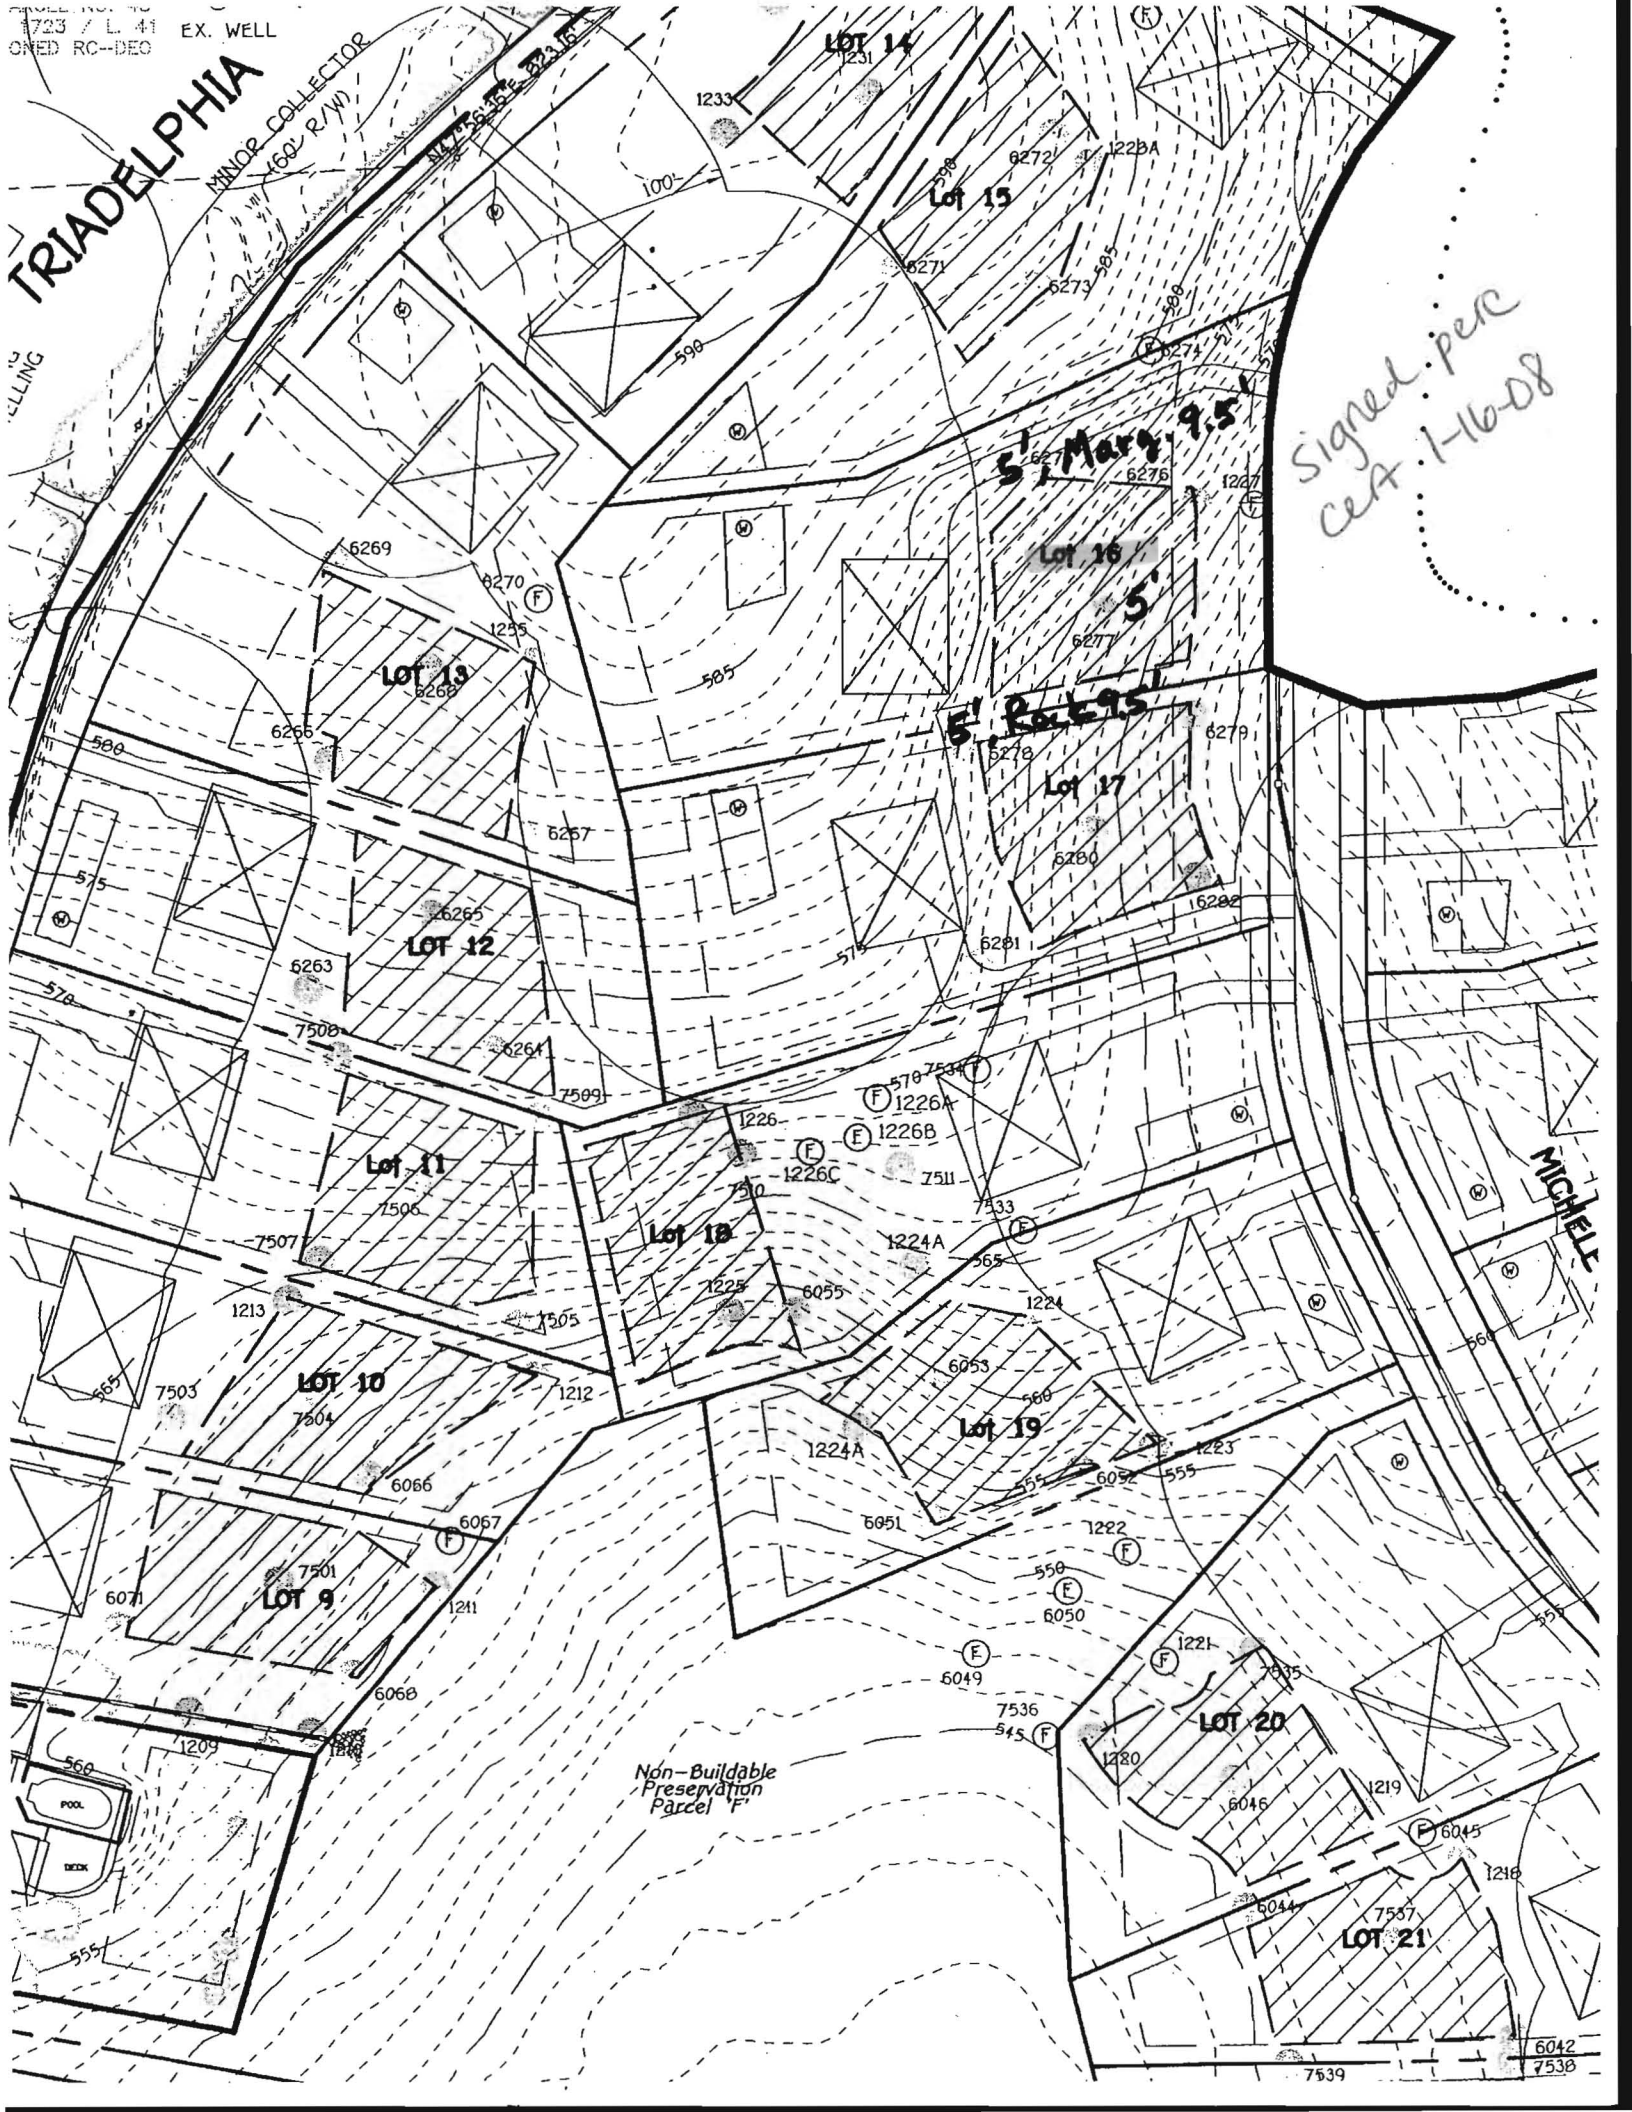

Signed per
cert 1-16-08

Non-Buildable
Preservation
Parcel

MICHELL