


12-4-2016

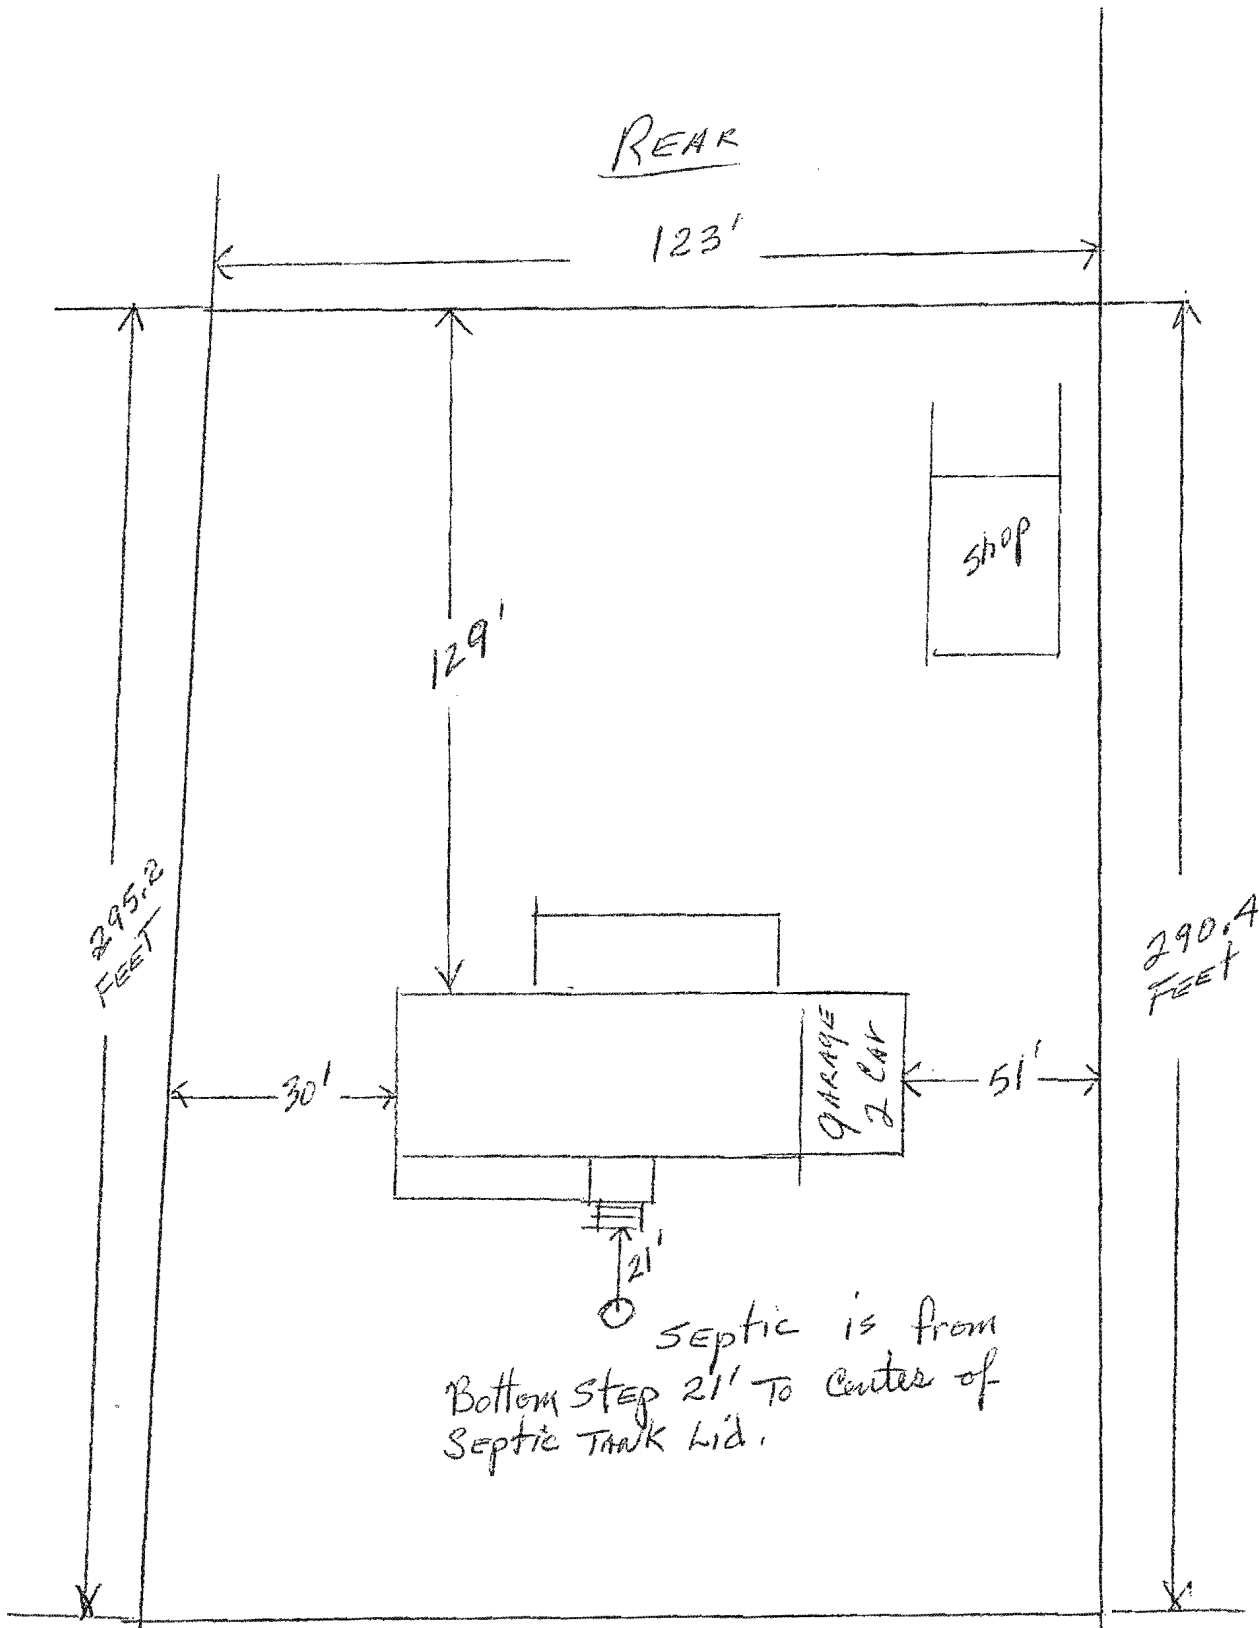

Front

William H. BARNETT

Front

12700 TRIADELPHIA RD
 ELLICOTT CITY MD
 21042