

APPLICATION

A 10329

P _____

SEWAGE DISPOSAL TESTING

MARYLAND STATE DEPARTMENT OF HEALTH

30 FEB 00 MS
HOWARD COUNTY

4/3 E A ROOMS

ELLICOTT CITY

750 Gallon Tank

1000 Gallon Tank

DISTRICT 5

DATE 6/15/65

Dry Well - 300 soft sidewall area below the inlet

Dry Well - 400 soft sidewall area below the inlet

Place the dry well 30 ft to 50 ft from the lot line along ~~South View Dr~~ and 150 ft to 120 ft from the lot line along ~~South View Ct~~ MONTGOMERY CT

TO: THE COUNTY HEALTH OFFICER
ELLICOTT CITY, MARYLAND

I, HEREBY, APPLY FOR THE NECESSARY TESTS IN ORDER TO CONSTRUCT (OR RECONSTRUCT) A SEWAGE DISPOSAL SYSTEM:

PROPERTY OWNER V. L. Vinella

ADDRESS 12631 Circle Dr., Glen Hills, Rockville, Maryland

PHONE 301-762-3007

PROPERTY LOCATION:

SUBDIVISION Green Hill Manor

LOT NO. 8, Blk. A

ROAD AND DESCRIPTION Corner ~~South View Rd.~~ & ~~South View Ct.~~

OCCUPANT _____

PHONE _____

PERSON TO CONSTRUCT SYSTEM _____

ADDRESS _____

PHONE _____

SIZE OF LOT 47,025 sq. ft.

TYPE BLDG. _____

3 or 4
NUMBER OF BEDROOMS

IF NOT SINGLE RESIDENCE DESCRIBE _____

SIGNATURE OF APPLICANT /s/ V. L. Vinella

APPROVED BY Raymond Hodges

FOR Drywell

(KIND OF SYSTEM)

DATE 17 MAR 66

REJECTED BY _____

FOR _____

(KIND OF SYSTEM)


DATE _____

HOLD PENDING FURTHER TESTS _____

DATE _____

REASONS FOR REJECTION OR HOLDING _____

THIS IS NOT A PERMIT

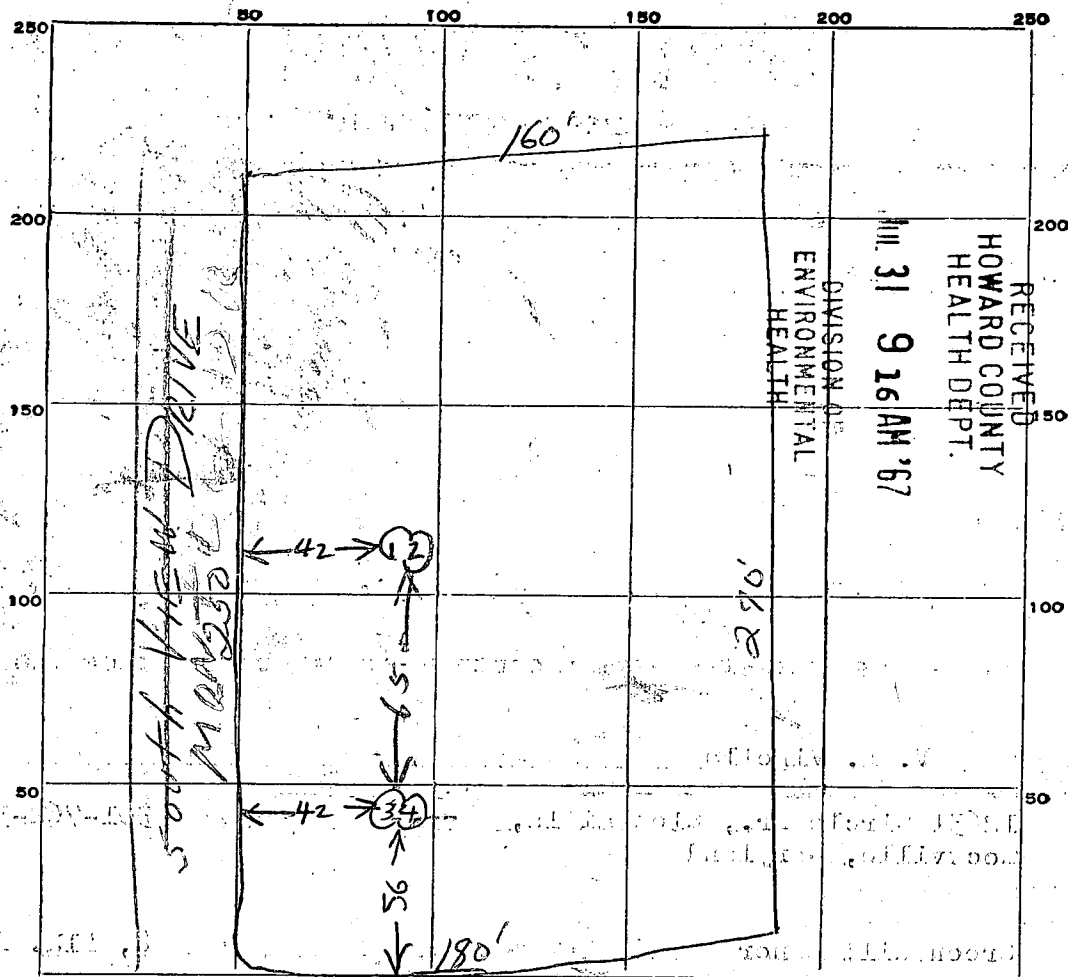

INDICATE NORTH. - NAME ADJOINING ROADWAY AS BASE LINE.

South View Court, Montello CT

| DATE | TEST NO. | DEPTH | PRE-WET | | TEST - 1" DROP | | TIME |
|------------|----------|-------|---------|----------|----------------|------|-------|
| | | | START | STOP | START | STOP | |
| 20 July 65 | 1 | 4 1/2 | 1056 | 1057 | 1057 | 1058 | 1 |
| 11 " " | 2 | 9 | 1058 | 1058 1/2 | 1058 1/2 | 1059 | 1 1/2 |
| 11 " " | 3 | 5 | 1100 | 1107 | 1102 | 1104 | 2 |
| 11 " " | 4 | 9 | 1101 | 1103 | 1103 | 1104 | 1 |
| | | | | | | | |
| | | | | | | | |
*1 min
air time
for system
+ repair area*

SOIL AUGER FINDING _____
 TESTED BY *BK* _____
V. L. Tucker
 REMARKS _____