

*This lot is not built on*  
**PERMIT**

P 03839

A 03829

SEWAGE DISPOSAL SYSTEM

MARYLAND STATE DEPARTMENT OF HEALTH

HOWARD COUNTY

ELLICOTT CITY

DISTRICT 5 th

DATE 6-8-61

**INDEXED**

C. C. Cissell IS PERMITTED TO INSTALL  ALTER

ADDRESS Highland PHONE

A SEWAGE DISPOSAL SYSTEM LOCATED AT Mink Hollow Rd. the south two arece parcel of the Robert D. Flanigan Property

SUBDIVISION ROAD LOT

PROPERTY OWNER Leo. M. Dubois

ADDRESS Highland

SPECIFICATIONS

DRAIN FIELD DEPTH FEET. BOTTOM AREA SQ. FT.

SEEPAGE PITS  ABSORBENT SIDE-WALL AREA SQ. FT.

SEPTIC TANK CAPACITY 750 GALLONS

FOR GARBAGE GRINDER, INCREASE DISPOSAL AREA 22% & TANK CAPACITY 50%.


OTHER Dry well 300 sw. ft. side wall area below the inlet

PLANS APPROVED BY Walton T. Leevy DATE 6-7-61

FILL SEPTIC TANK AND DISTRIBUTION BOX WITH WATER BEFORE CALLING FOR AN INSPECTION. COVER NO WORK UNTIL INSPECTED AND APPROVED.

NEITHER THE HOWARD COUNTY COMMISSIONERS NOR THE HEALTH DEPARTMENT IS RESPONSIBLE FOR THE SUCCESSFUL OPERATION OF ANY SYSTEM.

A 03829

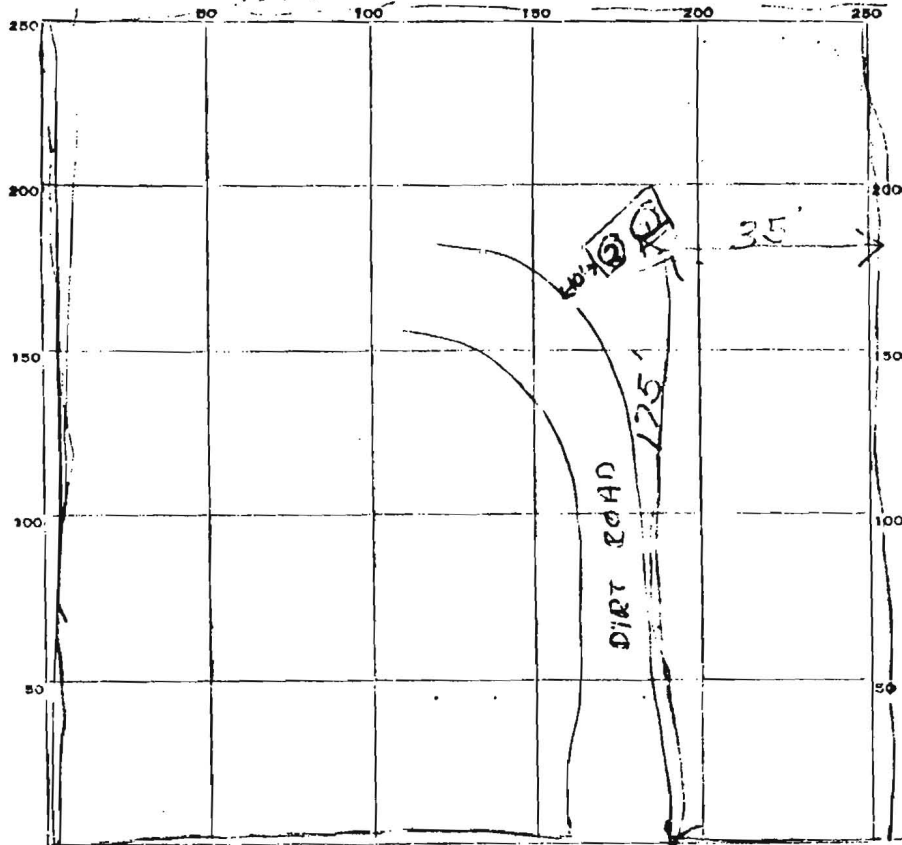

INDICATE NORTH. - NAME ADJOINING ROADWAY AS BASE LINE.

MINK HOLLOW RD

→ SOUTH

DATE	TEST NO.	DEPTH	PRE-WET		TEST - 1" DROP		TIME
			START	STOP	START	STOP	
6/7/61	1	9'	956	958	958	1001	3min
11	2	4'	958	959	959	1000	1min

} 2 min average

SOIL AUGER FINDING

TESTED BY

*Walter J. Jolley 6/12/61 OK*

REMARKS

ALSO PRESENT

LOT NO.