

PUB. SEWER STATUS VERIFIED BY _____

ISSUE DATE: _____

PERMIT

P INDEX _____

APPROVAL DATE: _____

A 519569-D _____

INDEXED

ON-SITE SEWAGE DISPOSAL SYSTEM HOWARD COUNTY HEALTH DEPARTMENT BUREAU OF ENVIRONMENTAL HEALTH

05-349893

IS PERMITTED TO INSTALL ALTER

ADDRESS: _____ PHONE NUMBER: _____

SUBDIVISION: _____ LOT NUMBER: _____

ADDRESS: 6840 Mink Hollow Road PROPERTY OWNER: William Alewine

SEPTIC TANK CAPACITY (GALLONS): _____

PUMP CHAMBER CAPACITY (GALLONS): _____

NUMBER OF BEDROOMS: _____

SQUARE FEET PER BEDROOM: _____

LINEAR FEET OF TRENCH REQUIRED: _____

TRENCHES:	Trench to be _____ feet wide. Inlet _____ feet below original grade. Bottom maximum depth _____ feet below original grade. Effective area begins at _____ feet below original grade. _____ feet of stone below distribution pipe.
LOCATION:	
PURPOSE:	No previous records found, building permit #B00138090 not approved. Septic repair needed, ltr sent to owner 8/30/02, owner never responded.

PLANS APPROVED: _____ DATE: _____

- NOTE: PERMIT VOID AFTER 2 YEARS
- NOTE: CONTRACTOR RESPONSIBLE FOR SCHEDULING A PRE-CONSTRUCTION INSPECTION FOR ALL INSTALLATIONS
- NOTE: WATERTIGHT SEPTIC TANKS REQUIRED
- NOTE: ALL PARTS OF SEPTIC SYSTEM SHALL BE 100 FEET FROM ANY WATER WELL
- NOTE: MANHOLE RISERS REQUIRED ON ALL SEPTIC TANKS AND PUMP CHAMBERS


**NEITHER THE HOWARD COUNTY COUNCIL NOR THE HEALTH DEPARTMENT IS
RESPONSIBLE FOR THE SUCCESSFUL OPERATION OF ANY SYSTEM
PERMITTEE RESPONSIBLE FOR OBTAINING FINAL APPROVAL ON THIS PERMIT
CALL 410-313-2640 FOR INSPECTION OF SEPTIC SYSTEM**

4519569-D

SITE INSPECTION SHEET

OWNER: _____ PHONE #: _____
ADDRESS: 6840 Mink Hollow Rd CONTRACTOR: _____
SUBDIVISION: _____ LOT: _____ WELL TAG #: _____
COUNTY #: _____
PROPOSAL: BP for deck in rear of house

LOCATION DIAGRAM

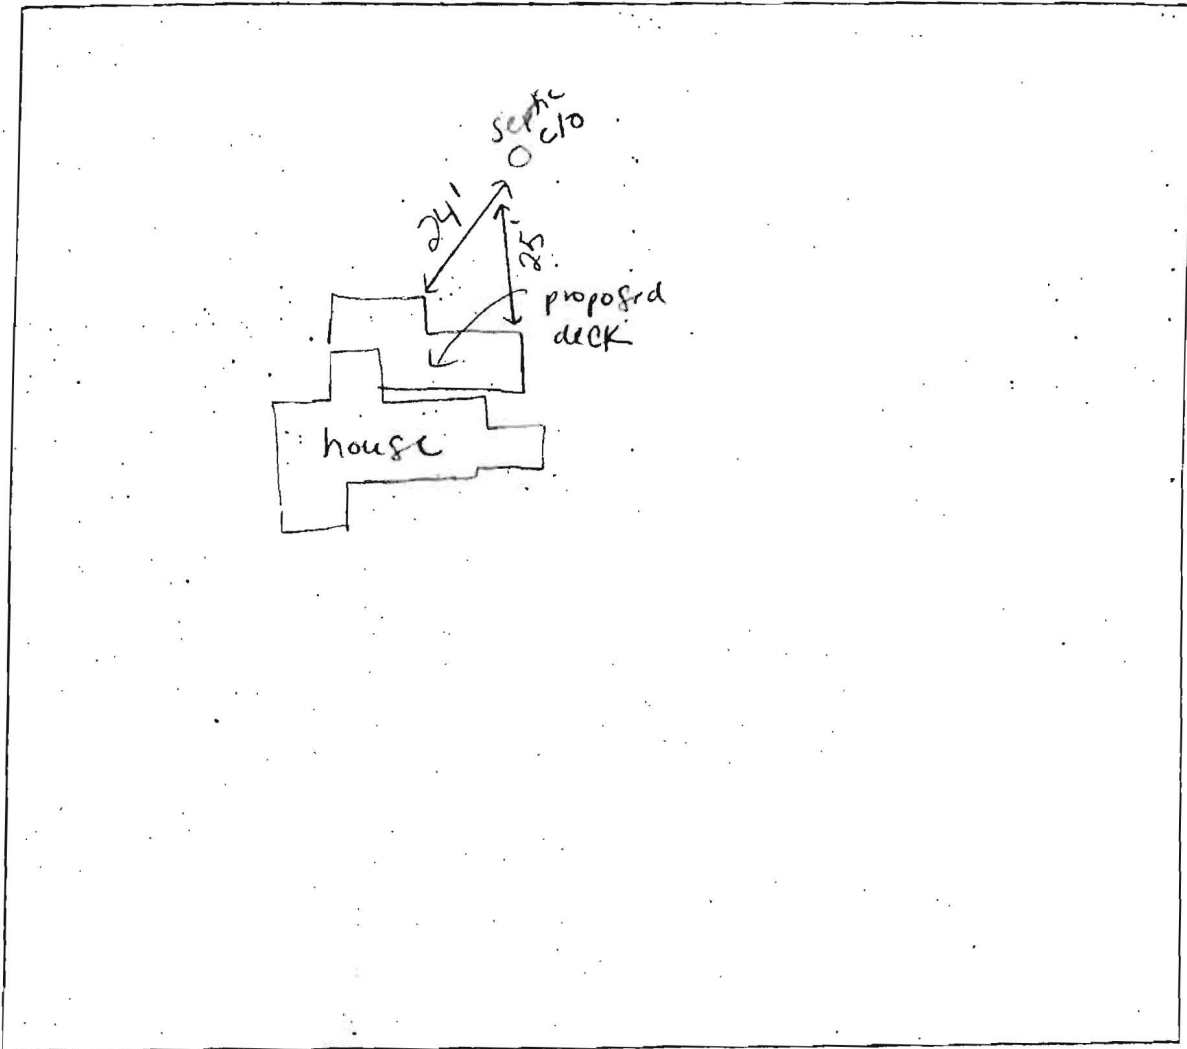


COMMENTS: 4/18/08 - HS

RHO1-38-B 6846 MINK HOLLOW RD HIGHLAND NOW 5/24/01 PROPS CASE#1-13241-01
 Fern Panel: 240044 00025
 Flood Zone: C
 LOT 2 PLAT OF SURVEY
 FOR FRANCIS W SMITH
 Book: 3929
 Folio: 81
 Dist: 5
 CO: HOWARD
 MD
 Scale 1"=60'

Reviewed and accepted this 29th day of May, 2001.

William S. Alewine Christine Campo

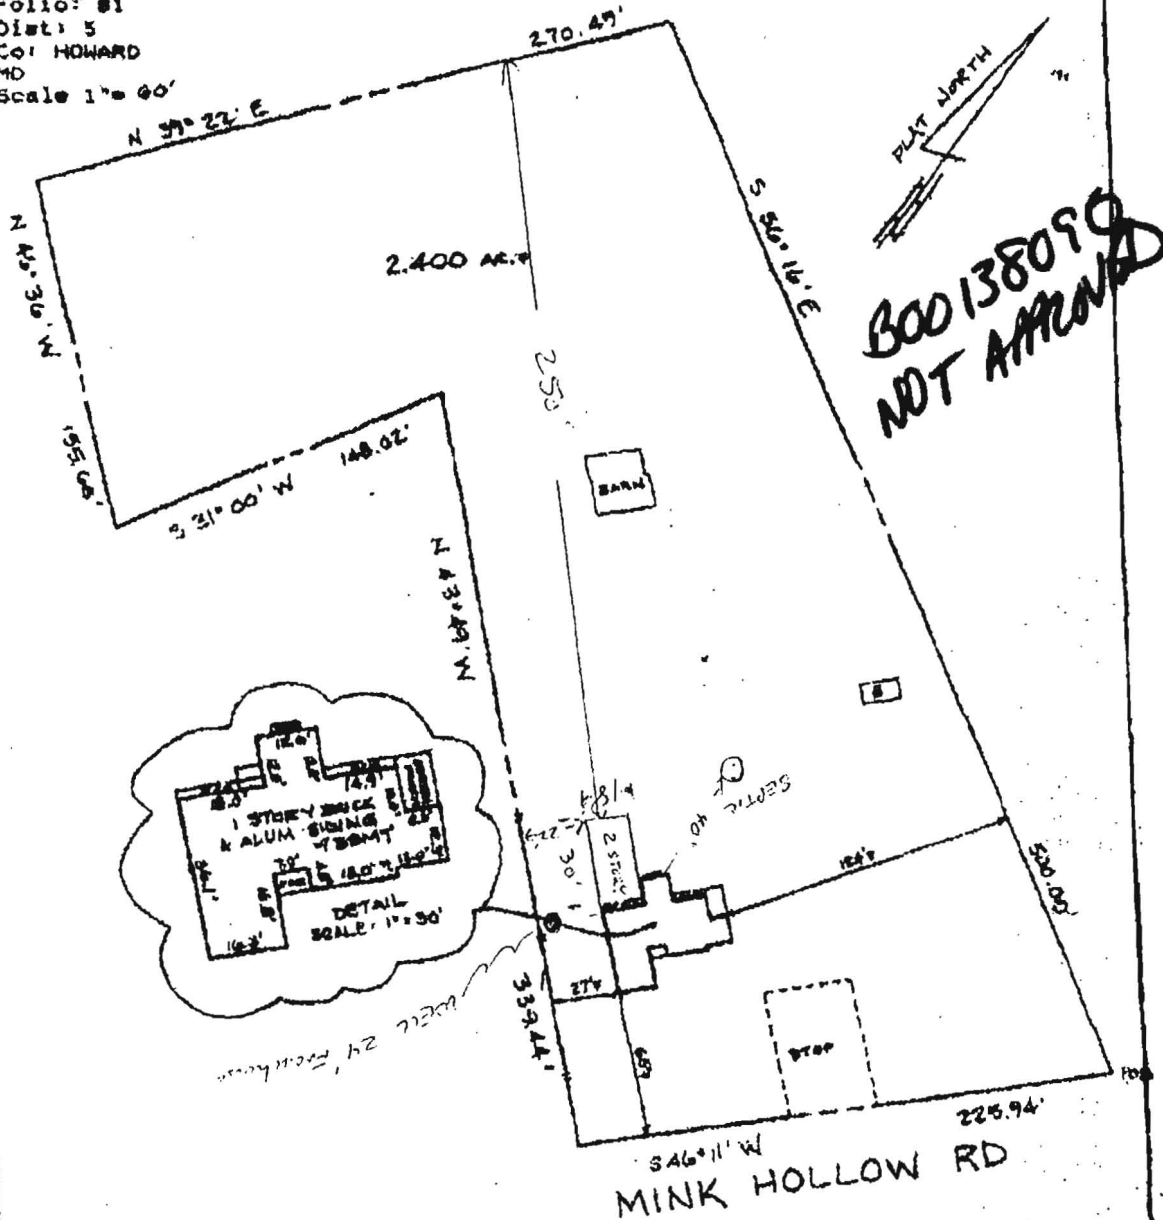

Accuracy: Approximate average accuracy (SD of sideline distances) for small suburban lots is two feet, and for large lots and metro and bounds parcels varies from two feet to twenty feet. In case of doubt, we recommend a Boundary Survey.



EMAIL: SURVEYASSOCIATES@EMDLS.COM

LEGEND

- Shed (unsurveyed)
- Blacktop Drive
- Gravel Drive
- Concrete

This is an Improvements Location Survey only, and must not be used for Boundary purposes. No Title Report furnished. No statement is made as to ownership of property or right or interest therein. Fences are approximate only and may not be shown. Not to be used for construction purposes or permits of any kind whatsoever.

SURVEY ASSOCIATES OF MARYLAND
 4905 SUDLEY RD
 WEST RIVER MARYLAND 20778

LOCATION