

PERMIT

SEWAGE DISPOSAL SYSTEM

MARYLAND STATE DEPARTMENT OF HEALTH

HOWARD COUNTY

INDEXED

ELLICOTT CITY

DISTRICT 5

DATE 2/28/74

19600

17498

Jack Fyock

IS PERMITTED TO INSTALL OR ALTER

ADDRESS Ten Oaks Road, Glennig, Maryland

PHONE 286-2939

A SEWAGE DISPOSAL SYSTEM LOCATED AT

SUBDIVISION ROAD 6717 Mink Hollow Rd. LOT

(use application for better directions)

PROPERTY OWNER Dr. Richard G. Allison

HILLDALE RD

ADDRESS 14003 Eagle Court, Rocksville, Maryland 20852

20777

SPECIFICATIONS - 4 bedrooms

DRAIN FIELD DEPTH FEET, BOTTOM AREA SQ. FT.

SEEPAGE PITS ABSORBENT SIDE-WALL AREA SQ. FT.

SEPTIC TANK CAPACITY 1,250 GALLONS

FOR GARBAGE GRINDER, INCREASE DISPOSAL AREA 22% & TANK CAPACITY 50%

OTHER Dry well - 400 sq. ft. sidewall area below top 6 ft. clay Dry well inlet

to be 5 ft. below grade and dry well bottom to be 13 ft. below grade. Place the dry well

90 ft. from the lot line which is 604.59 ft. long and runs 55°26'23"N and 210 ft. from

the lot line which is 288.84 ft. long and runs 85°42'04"E.

NOTE: ALL PIPE FROM HOUSE TO DRY WELL MUST BE CAST IRON.

PERMIT VOID AFTER THREE YEARS.

NOTE: INSTALL STAND PIPE ON SEPTIC TANK AND DRY WELL.

PLANS APPROVED BY Raymond Hodges DATE 11/2/72

FILL SEPTIC TANK AND DISTRIBUTION BOX WITH WATER BEFORE CALLING FOR AN INSPECTION. COVER NO WORKS UNTIL INSPECTED AND APPROVED.

NEITHER THE HOWARD COUNTY COMMISSIONERS NOR THE HEALTH DEPARTMENT IS RESPONSIBLE FOR THE SUCCESSFUL OPERATION OF ANY SYSTEM.


BOG. PERMIT SIGNED AND RETURNED 2/21/74

Initial F 3/2/74
3 car garage

17498

INSPECTOR

DATE SYSTEM APPROVED

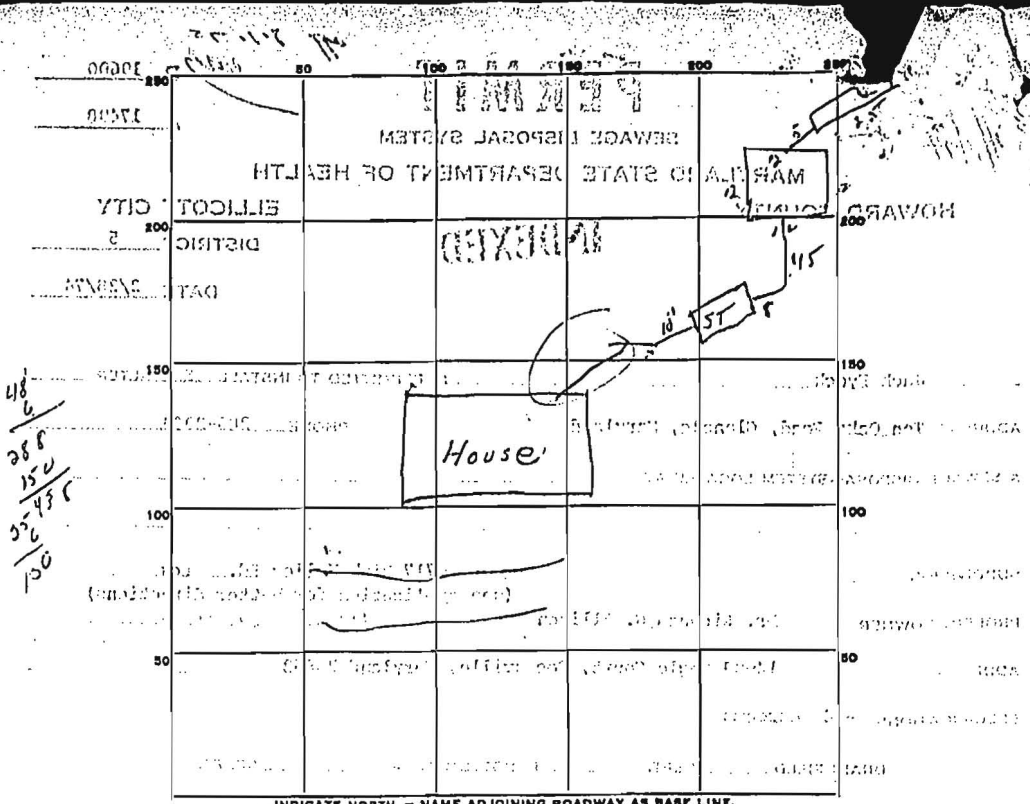

PERMIT CARD OK

SEPTIC TANK, LEVEL OK (15.00) CLEANOUTS OK

DISTRIBUTION BOX, LEVEL _____

TILE FIELD, DEPTH 12 FT. TRENCH WIDTH 2 FT.

GRAVEL DEPTH 2 MIN. TOTAL LENGTH 22.5 FT.

NUMBER OF TRENCHES _____ TOTAL BOTTOM AREA 50 sq. ft.

SEEPAGE PITS, INSIDE DIAMETER 48 FT. DEPTH BELOW INLET 6 FT.

ABSORBENT AREA 28.8 SQ. FT. 154 cu. ft. 438 sq. ft.

REMARKS System for tank OK - line 12' deep from tank OK - rest of house sewer must be unexcavated.

DATE SYSTEM APPROVED 8-1-77 INSPECTOR DW Mores