

# APPLICATION

A 17498

SEWAGE DISPOSAL TESTING

P \_\_\_\_\_

MARYLAND STATE DEPARTMENT OF HEALTH

HOWARD COUNTY

ELLICOTT CITY

DISTRICT 5th

DATE 9/28/72

TO: THE COUNTY HEALTH OFFICER  
ELLICOTT CITY, MARYLAND

I, HEREBY, APPLY FOR THE NECESSARY TESTS IN ORDER TO CONSTRUCT (OR RECONSTRUCT) A SEWAGE DISPOSAL SYSTEM.

PROPERTY OWNER William Canby

ADDRESS Brighton Dam Road, Brookeville, Md. PHONE 774-4002

PROPERTY LOCATION:

SUBDIVISION \_\_\_\_\_ LOT NO. \_\_\_\_\_

ROAD AND DESCRIPTION On east side of Mink Hollow Road x approximately 1/2 mile south of Highland Rd.

OCCUPANT \_\_\_\_\_ PHONE \_\_\_\_\_

PERSON TO CONSTRUCT SYSTEM \_\_\_\_\_

ADDRESS \_\_\_\_\_ PHONE \_\_\_\_\_

SIZE OF LOT 11.017 acres TYPE BLDG. 3 or 4 bedrooms  
NUMBER OF BEDROOMS

IF NOT SINGLE RESIDENCE DESCRIBE \_\_\_\_\_

SIGNATURE OF APPLICANT Richard Hallowell, Agent, Highland, Md. 20777 At 6-2988

APPROVED BY \_\_\_\_\_ FOR \_\_\_\_\_ DATE \_\_\_\_\_  
(KIND OF SYSTEM)

REJECTED BY Robt. V. ... FOR Ans. ... DATE 10/17/72  
(KIND OF SYSTEM)


HOLD PENDING FURTHER TESTS \_\_\_\_\_ DATE \_\_\_\_\_

REASONS FOR REJECTION OR HOLDING Not enough on the ...

## THIS IS NOT A PERMIT

PP471 A

APPLICATION

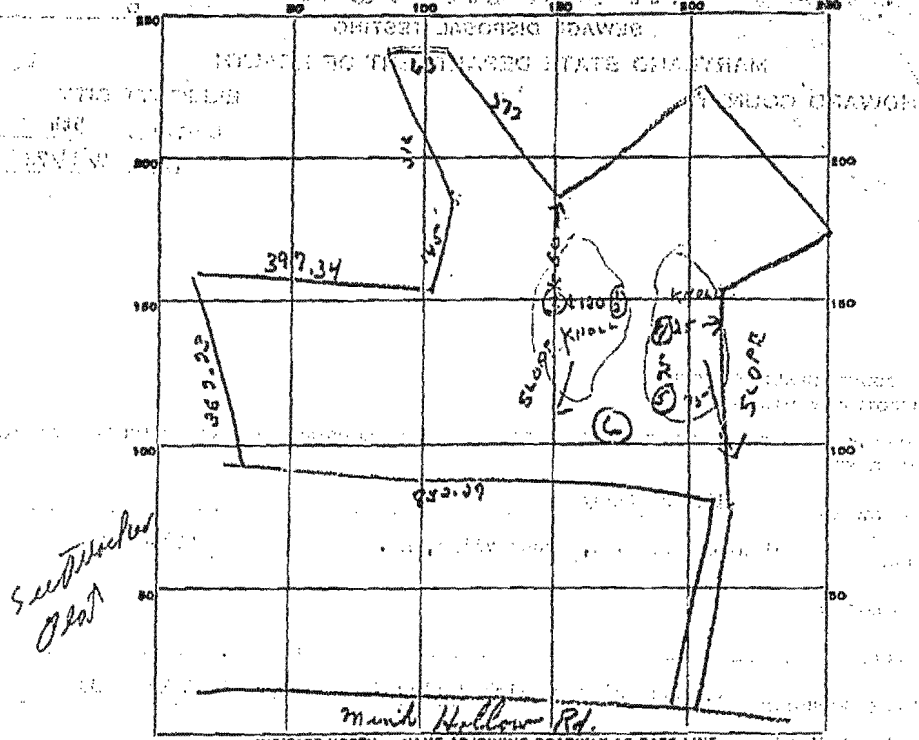

*See attached plot*

103

INDICATE NORTH. - NAME ADJOINING ROADWAY AS BASE LINE.

DATE	TEST NO.	DEPTH	PRE-WET		TEST - 1" DROP		TIME
			START	STOP	START	STOP	
10/2/72	1	6 ft	10:44				
	2	10 1/2 ft	Rock				
	3	6 1/2 ft	Rock				
	4	8 1/2 ft	Rock				
	5	6 1/2 ft	Rock				
	6	10 ft	Water & clay				
11/2/72	7	12 1/2	11:13	11:13 1/2	11:15 1/2	11:16 1/2	3:40
11/2/72	8	4	11:14	11:14 1/2	11:17	11:18	2:50
11/11	9	3	11:18	11:18 1/2	11:17	11:26	4:00
11/11	10	12	11:19	11:20	11:20	11:22	2:00
11/11	11	13					

TOP 6 FT CLAY SHALE  
BOT 6 FT SANDSHING

SOIL AUGER FINDING: 12 TOP 4 FT CLAY SHALE BOT 9 FT SANDY SHALE Rvy- TOP 3 FT CLAY BOT 9 FT SAND

TESTED BY: R. Toner

REMARKS