

WD 674-5771  
 STATE OF MARYLAND  
 WATER RESOURCES ADMINISTRATION  
 TAWES STATE OFFICE BLDG., ANNAPOLIS, MD. 21401  
 WELL COMPLETION REPORT

SEQUENCE NO. 0800  
 THIS REPORT MUST BE SUBMITTED WITHIN 30 DAYS AFTER WELL COMPLETION.  
 FILL IN THIS FORM COMPLETELY  
 COUNTY NUMBER  
 DATE RECEIVED  
 DATE WELL COMPLETED 2/70  
 DEPTH OF WELL 240 (TO NEAREST FOOT)  
 PERMIT NO. FROM "PERMIT TO DRILL WELL"  
 DRILLER'S IDENTIFICATION NO.

OWNER: Richard  
 STREET OR RFD: POST OFFICE: *Richard*

WELL LOG

STATE THE KIND OF FORMATIONS PENETRATED, THEIR COLOR, DEPTH, THICKNESS AND IF WATER BEARING

DESCRIPTION (USE ADDITIONAL SHEETS IF NECESSARY)	FEET		CHECK IF WATER BEARING
	FROM	TO	
Top soil	0	2	
Shale	2	16	
Brown slate	16	80	
Brown mica	80	140	✓
White mica	140	240	✓

GROUTING RECORD

WELL HAS BEEN GROUTED (CIRCLE APPROPRIATE BOX) YES  NO

TYPE OF GROUTING MATERIAL (CIRCLE NOS):  
 CEMENT  BENTONITE CLAY

NO. OF BAGS: 200  
 GALLONS OF WATER: 210

DEPTH OF GROUT SEAL (TO NEAREST FOOT):  
 FROM 0 FT. TO 18 FT.

PUMPING TEST

HOURS PUMPED (TO NEAREST HOUR) 4

PUMPING RATE (GALLONS PER MINUTE TO NEAREST GALLON) 100

METHOD USED TO MEASURE PUMPING RATE: bucket

WATER LEVEL (DISTANCE FROM LAND SURFACE):  
 BEFORE PUMPING 600 (NEAREST FOOT)  
 WHEN PUMPING 940 (NEAREST FOOT)

CASING RECORD

MAIN CASING TYPE: S T  
 NOMINAL DIAMETER (NEAREST INCH): 6  
 TOTAL DEPTH OF MAIN CASING (NEAREST FEET): 20

OTHER CASING (IF USED):  
 DIAMETER (INCH) \_\_\_\_\_ DEPTH (FEET) \_\_\_\_\_

TYPE OF PUMPED USED (CIRCLE APPROPRIATE BOX) (FOR PUMPING TEST)

AIR  PISTON  TURBINE  
 CENTRIFUGAL  ROTARY  OTHER (DESCRIBE BELOW)  
 JET  SUBMERSIBLE

SCREEN RECORD

SCREEN TYPE OR OPEN HOLE: S T B R H O  
 STEEL BRASS OPEN HOLE OR SPOON  
 PL  O T  
 PLASTIC OTHER

PUMP INSTALLED

DRILLER WILL INSTALL PUMP (CIRCLE APPROPRIATE BOX) YES  NO

CAPACITY:  
 GALLONS PER MINUTE (TO NEAREST GALLON) \_\_\_\_\_  
 PUMP HORSE POWER \_\_\_\_\_  
 PUMP COLUMN LENGTH (NEAREST FEET) \_\_\_\_\_

DIAMETER OF SCREEN \_\_\_\_\_ (NEAREST INCH)  
 GRAVEL PACK \_\_\_\_\_  
 IF WELL DRILLED WAS A FLOWING WELL CIRCLE BOX

CASING HEIGHT (CIRCLE APPROPRIATE BOX AND ENTER CASING HEIGHT)

ABOVE  BELOW  
 LAND SURFACE (NEAREST FOOT) 2

CIRCLE APPROPRIATE BOXES

A WELL WAS ABANDONED AND SEALED WHEN THIS WELL WAS COMPLETED

E ELECTRIC LOG OBTAINED

P TEST WELL CONVERTED TO PRODUCTION WELL

I HEREBY CERTIFY THAT I HAVE COMPLIED WITH ALL CONDITIONS STATED ON THE ABOVE-CAPTIONED "PERMIT TO DRILL WELL", AND THAT INFORMATION CONTAINED IN THIS REPORT IS TRUE, ACCURATE, AND COMPLETE TO THE BEST OF MY KNOWLEDGE, INFORMATION AND BELIEF.


DRILLER'S NAME: *J. J. Carls*  
 SIGNATURE: *J. J. Carls*

LOCATION OF WELL ON LOT

SHOW PERMANENT STRUCTURE SUCH AS BUILDINGS, SEPTIC TANKS, AND/OR OTHER LAND MARKS AND INDICATE NOT LESS THAN TWO DISTANCES (MEASURED TO WELL).

*well*  
*45'*  
 HOUSE



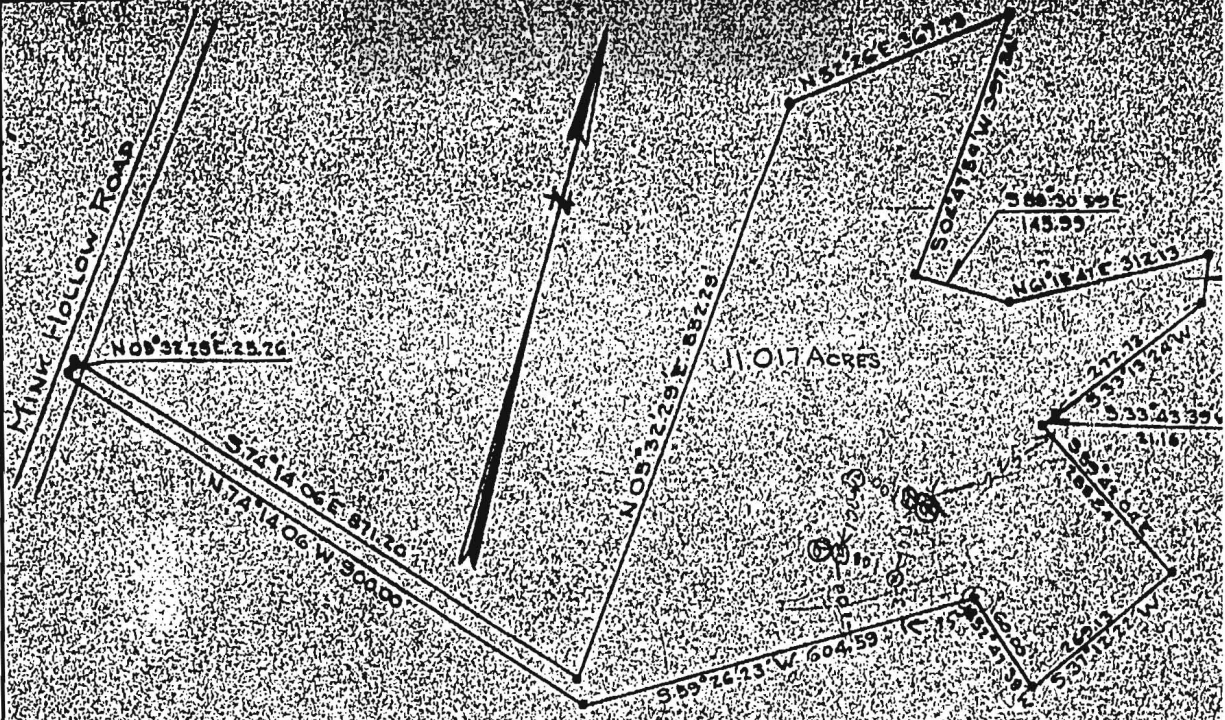

PLAT OF SURVEY  
 FOR  
 WILLIAM M. CANBY  
 FIFTH ELECTION DIST. HOWARD CO.  
 HIGHLAND MARYLAND  
 SCALE: 1 IN. = 200 FT.      APRIL 29, 1972

*Claude M. Skiffington*  
 Claude M. Skiffington  
 Reg. Professional Engineer &  
 Land Surveyor No. 2237

PROFESSIONAL ENGINEER  
 LAND SURVEYOR  
 No. 2237

