

PERMIT

SEWAGE DISPOSAL SYSTEM

MARYLAND STATE DEPARTMENT OF HEALTH

HOWARD COUNTY

INDEXED

File 05-356555

INDEXED

STATE

59309-D
18208

ELLICOTT CITY

DISTRICT 7th

DATE 5/30/73

Gordon Walker

IS PERMITTED TO INSTALL ALTER

ADDRESS Hall's Shop Road, Fulton, Maryland 20759

PHONE 286-2306

A SEWAGE DISPOSAL SYSTEM LOCATED AT

SUBDIVISION ROAD 6705 Mink Hollow Road Parcel 9

PROPERTY OWNER San-Annele David + Kathy Modesitt

ADDRESS 14816 Stone Gate Terrace, Silver Spring, Md. Phone: 384-6747

SPECIFICATIONS 3 bedrooms

DRAIN FIELD DEPTH FEET. BOTTOM AREA SQ. FT.

SEEPAGE PITS ABSORBENT SIDE-WALL AREA SQ. FT.

SEPTIC TANK CAPACITY 1000 GALLONS

FOR GARBAGE GRINDER, INCREASE DISPOSAL AREA 22% & TANK CAPACITY 50%

OTHER DRY WELL - To have 120 sq. ft. effective absorbent sidewall area per bedroom, below inlet. Inlet to be 3 ft. below original grade. Maximum depth permitted for dry well is 11 ft. Locate as per certified engineer 318 ft. down left property line and 18 1/2 ft. in from left property line as seen when facing lot from front.

NOTE: ALL PIPE FROM HOUSE TO DISPOSAL AREA MUST BE CAST IRON.

PERMIT VOID AFTER THREE YEARS.

NOTE: INSTALL STAND PIPE ON SEPTIC TANK AND DRY WELL. STAND PIPES MUST BE 6 INCHES IN DIAMETER. CAST IRON, CONCRETE OR TERRA COTTA ACCEPTED.

PLANS APPROVED BY Charles B. Streaker DATE 5/9/73

FILL SEPTIC TANK AND DISTRIBUTION BOX WITH WATER BEFORE CALLING FOR AN INSPECTION. COVER NO WORK UNTIL INSPECTED AND APPROVED.

NEITHER THE HOWARD COUNTY COMMISSIONERS NOR THE HEALTH DEPARTMENT IS RESPONSIBLE FOR THE SUCCESSFUL OPERATION OF ANY SYSTEM.

OLD PERMIT SIGNED
AND RETURNED 2-19-98
Serial # B70110928
pouch.

A 18208

59309-D

SEPTIC


PERMIT

MARYLAND STATE DEPARTMENT OF HEALTH
SEWAGE DISPOSAL SYSTEM

INDEXED

HOWARD COUNTY

PROPERTY LINE APPROX AS SHOWN BY PROPERTY OWNERS

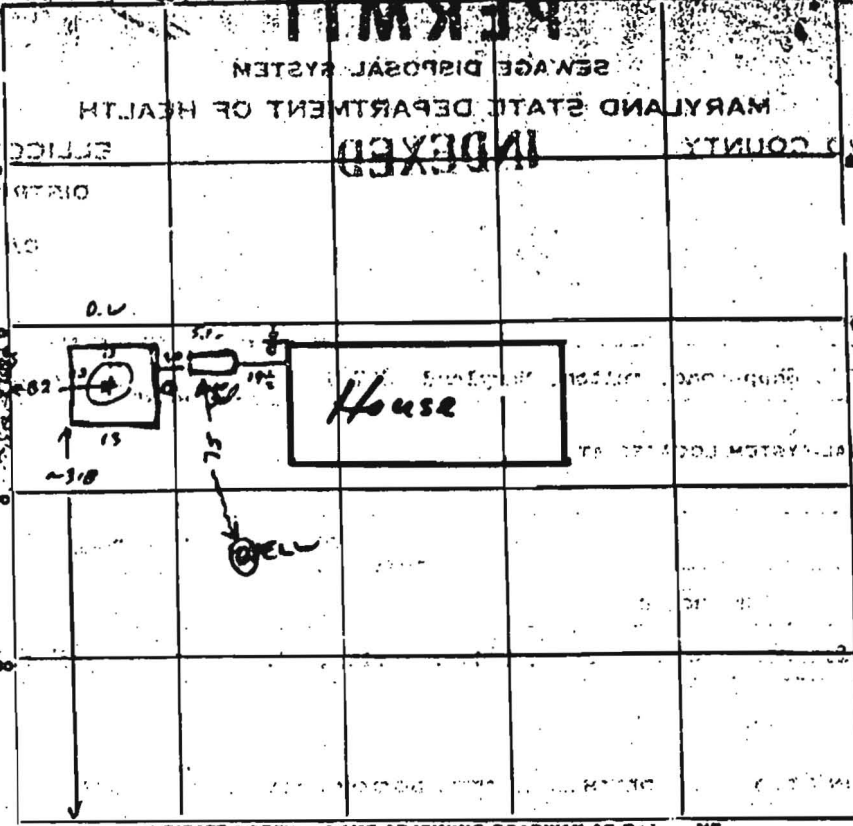

INDICATE NORTH - NAME ADJOINING ROADWAY AS BALANCE LINE

Milk Hollow Rd.

PERMIT CARD

SEPTIC TANK LEVEL

CLEANOUTS

DISTRIBUTION BOX LEVEL

TILE FIELD DEPTH

FT. TRENCH WIDTH

GRAVEL DEPTH

IN.

TOTAL LENGTH

FT.

NUMBER OF TRENCHES

TOTAL BOTTOM AREA

Parimeter

SEEPAGE PITS, INSIDE DIAMETER

52

Acceptable

8

DEPTH BELOW INLET

FT.

ABSORBENT AREA

406

SQ. FT.

120
350

REMARKS

5/12/75

1) inlet @ 3', max depth 13'

2) D.W. too close to sideline by 120 ft if sideline is @ Barker

3) re-seal below pipe where enters 55' from house R.M.

5/14/75

fill 13' hole dug - soil ok.

Don Parbett

(2) S.T. Level

(3) lower line sealed to 5.7

DATE SYSTEM APPROVED

5/15/75

INSPECTOR

R. Turner