

B10007028

Building Address 11211 ...
 Suite/Apt. #: _____ SDP/WP/Petition #: _____
 Census Tract _____ Subdivision ...
 Section _____ Area _____ Lot 2
 Tax Map _____ Parcel _____ Grid _____
 Zoning _____ Map Coordinates _____ Lot Size _____

Property Owner's Name ...
 Address ...
 City _____ State MD Zip Code 21075
 Home Phone _____ Work Phone ...
 Applicant's Name & Mailing Address, (if other than stated herein):
Jim Kerwin
PO Box 572
...
 Phone 410-379-7777 Fax 410-379-2430

Existing Use ...
 Proposed Use ...
 Estimated Construction Cost \$...
 Description of Work ...
 Occupant or Tenant _____
 Contact Name _____
 Address _____
 City _____ State _____ Zip Code _____
 Phone _____ Fax _____

Contractor Company ...
 Contact Person ...
 Address ...
 City _____ State MD Zip Code 21075
 License No. _____
 Phone _____ Fax _____
 Engineer or Architect Company _____
 Contact Person _____
 Address _____
 City _____ State _____ Zip Code _____
 Phone _____ Fax _____

BUILDING DESCRIPTION - COMMERCIAL

BUILDING DESCRIPTION - RESIDENTIAL

Building Characteristics	Utilities
Height: _____	Water Supply: _____ Public <input type="checkbox"/> Private <input type="checkbox"/>
No. of stories: _____	Sewage Disposal: _____ Public <input type="checkbox"/> Private <input type="checkbox"/>
Gross area, sq. ft. per floor: _____	Electric Yes <input type="checkbox"/> No <input type="checkbox"/> Gas Yes <input type="checkbox"/> No <input type="checkbox"/>
Use group: _____	Heating System: _____ Electric <input type="checkbox"/> Oil <input type="checkbox"/> Natural Gas <input type="checkbox"/> Propane Gas <input type="checkbox"/>
Construction type: Reinforced Concrete <input type="checkbox"/> Structural Steel <input type="checkbox"/> Masonry <input type="checkbox"/> Wood Frame <input type="checkbox"/> State Certified Modular <input type="checkbox"/>	Sprinkler system: N/A <input type="checkbox"/> Full <input type="checkbox"/> Partial <input type="checkbox"/> Other Suppression <input type="checkbox"/> # of Heads _____

Building Characteristics	Utilities
SF Dwelling <input type="checkbox"/> SF Townhouse <input type="checkbox"/> Depth _____ Width _____ 1 st floor: _____ 2 nd floor: _____ Basement: _____	Water Supply: _____ Public <input type="checkbox"/> Private <input type="checkbox"/>
Finished Basement <input type="checkbox"/> Unfinished Basement <input type="checkbox"/> Crawl space <input type="checkbox"/> Slab on Grade <input type="checkbox"/> No. of Bedrooms <u>4</u>	Sewage Disposal: _____ Public <input type="checkbox"/> Private <input type="checkbox"/>
Multi-family dwellings: No. of efficiency units: _____ No. of 1 BR units: _____ No. of 2 BR units: _____ No. of 3 BR units: _____	Electric Yes <input type="checkbox"/> No <input type="checkbox"/> Gas Yes <input type="checkbox"/> No <input type="checkbox"/>
Other Structure: _____ Dimensions: _____ Footings: _____ Roof: _____ State Certified Modular <input type="checkbox"/> Manufactured Home <input type="checkbox"/>	Heating System: _____ Electric <input type="checkbox"/> Oil <input type="checkbox"/> Natural Gas <input type="checkbox"/> Propane Gas <input type="checkbox"/>
	Sprinkler system: N/A <input type="checkbox"/> NFPA #13D <input type="checkbox"/> NFPA #13R <input type="checkbox"/> Other: _____

THE UNDERSIGNED HEREBY CERTIFIES AND AGREES AS FOLLOWS: (1) THAT HE/SHE IS AUTHORIZED TO MAKE THIS APPLICATION; (2) THAT THE INFORMATION IS CORRECT; (3) THAT HE/SHE WILL COMPLY WITH ALL REGULATIONS OF HOWARD COUNTY WHICH ARE APPLICABLE THERETO; (4) THAT HE/SHE WILL PERFORM NO WORK ON THE ABOVE REFERENCED PROPERTY NOT SPECIFICALLY DESCRIBED IN THIS APPLICATION; (5) THAT HE/SHE GRANTS COUNTY OFFICIALS THE RIGHT TO ENTER ONTO THIS PROPERTY FOR THE PURPOSE OF INSPECTING THE WORK PERMITTED AND POSTING NOTICES.

Applicant's Signature _____
 Email Address _____
 Title/Company _____

Print Name Jim Kerwin
 Date 7/2/2010


Checks payable to: **DIRECTOR OF FINANCE OF HOWARD COUNTY**
****PLEASE WRITE NEATLY AND LEGIBLY.****

- FOR OFFICE USE ONLY -

AGENCY	DATE	SIGNATURE	APPROVAL	DPZ SETBACK INFORMATION	PROPERTY ID #
Land Development, DPZ				Front: _____	Filing fee \$ _____
State Highways				Rear: _____	Permit fee \$ _____
Building Officials				Side: _____	Excise tax \$ _____
Dev. Engineering, DPZ				Side St.: _____	Add'l per fee \$ _____
Health <u>8-12-10</u> <u>DBernard</u>				All minimum setbacks met?	TOTAL FEES \$ _____
Fire Protection				YES <input type="checkbox"/> NO <input type="checkbox"/>	Sub-total paid \$ _____
Is Sediment Control approval required prior to issuance? YES <input type="checkbox"/> NO <input type="checkbox"/>				Is Entrance Permit Required? YES <input type="checkbox"/> NO <input type="checkbox"/>	Balance due \$ _____
				Historic District? YES <input type="checkbox"/> NO <input type="checkbox"/>	Check # _____
				Lot Coverage for New Town Zone _____	Validation # _____
				SDP/Red-line approval date _____	Accepted by _____

CONTINGENCY CONSTRUCTION START:
 ONE STOP SHOP:

(3)

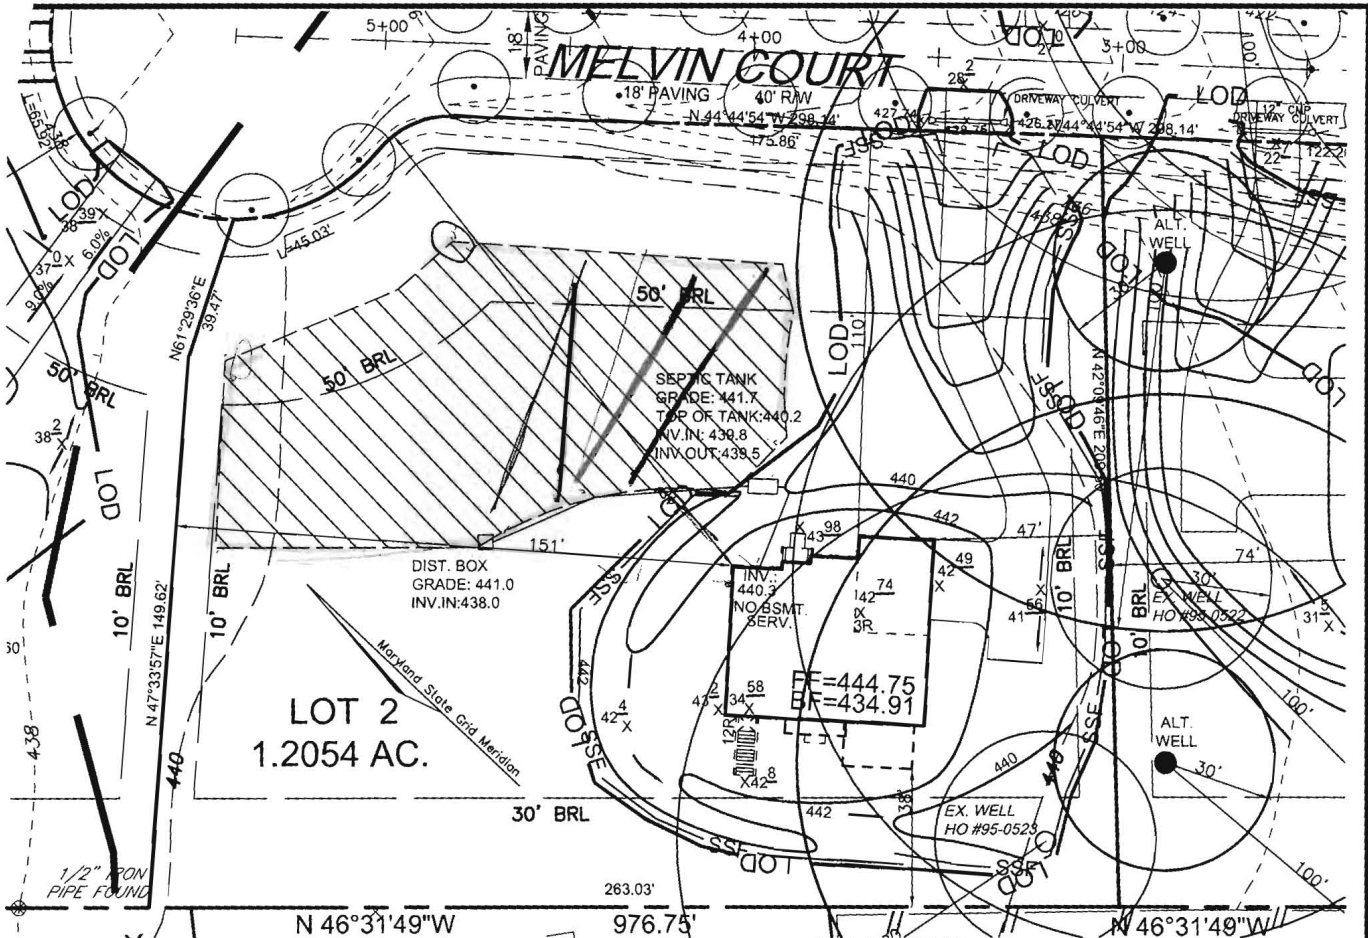


BP# *B10002028*
 DB *approved as shown*
 8-12-10

THE EXISTING WELL SHOWN ON LOT 2 TAG NO. HO-95-0523 HAVE BEEN FIELD LOCATED BY ROBERT H. VOGEL ENGINEERING, INC.
 BUILDING OF LOT 2
 GROSS FLOOR AREA: 3,300 SF.

OPT. FIREPLACE
 2.17' X 5.67' W/OPT.
 4' FAMILY ROOM EXT.
 4' X 16.50'
 OPT. MORNING ROOM
 12' X 19'

OPT. 4' WELLED EXIT

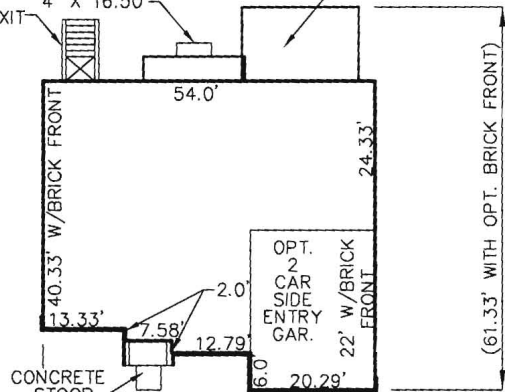

(54.67' WITH OPT. BRICK FRONT)
 ELEV. C
 W/ OPT. BRICK FRONT
CHAPEL HILL

SCALE: 1" = 30'

ROBERT H. VOGEL ENGINEERING, INC.
 ENGINEERS • SURVEYORS • PLANNERS
 8407 MAIN STREET TEL: 410.461.7666
 ELLICOTT CITY, MD 21043 FAX: 410.461.8961

NV HOMES SCAGGSVILLE KNOLLS

F-06-091

LOT 2

11211 MELVIN COURT

PARCEL 118
 HOWARD COUNTY, MARYLAND

SCALE: 1"=50'
 DRAWN BY: KG/HS
 CHECKED BY: RHV
 DATE: JULY 2010
 W. O. #: 04-49
 SHEET # 1 OF 1

REV. 8/12/10
 TAX MAP 46 BLOCK 3&9
 5TH ELECTION DISTRICT

B10002551

Building Address 11211 Melvin Court
 Suite/Apt. #: 112 SDP/WP/Petition #:
 Census Tract _____ Subdivision _____
 Section _____ Area _____ Lot 2
 Tax Map 44 Parcel 11 Grid _____
 Zoning _____ Map Coordinates _____ Lot Size _____

Property Owner's Name NY Homes
 Address Marshalee Drive 6085 #130
 City _____ State _____ Zip Code _____
 Home Phone _____ Work Phone _____
 Applicant's Name & Mailing Address, (if other than stated herein):

 Phone 410 271 1771 Fax _____

Existing Use _____
 Proposed Use install 500 Gal propane tank
 Estimated Construction Cost \$ _____
 Description of Work _____

 Occupant or Tenant _____
 Contact Name _____
 Address _____
 City _____ State _____ Zip Code _____
 Phone _____ Fax _____

Contractor Company _____
 Contact Person _____
 Address _____
 City _____ State _____ Zip Code _____
 License No. _____
 Phone _____ Fax _____
 Engineer or Architect Company _____
 Contact Person _____
 Address _____
 City _____ State _____ Zip Code _____
 Phone _____ Fax _____

BUILDING DESCRIPTION - COMMERCIAL

BUILDING DESCRIPTION - RESIDENTIAL

Building Characteristics	Utilities
Height: _____	Water Supply: _____ <input type="checkbox"/> Public <input type="checkbox"/> Private
No. of stories: _____	Sewage Disposal: _____ <input type="checkbox"/> Public <input type="checkbox"/> Private
Gross area, sq. ft. per floor: _____	Electric Yes <input type="checkbox"/> No <input type="checkbox"/> Gas Yes <input type="checkbox"/> No <input type="checkbox"/>
Use group: _____	Heating System: _____ Electric <input type="checkbox"/> Oil <input type="checkbox"/> Natural Gas <input type="checkbox"/> Propane Gas <input type="checkbox"/>
Construction type: _____ <input type="checkbox"/> Reinforced Concrete <input type="checkbox"/> Structural Steel <input type="checkbox"/> Masonry <input type="checkbox"/> Wood Frame <input type="checkbox"/> State Certified Modular	Sprinkler system: N/A <input type="checkbox"/> <input type="checkbox"/> Full <input type="checkbox"/> Partial <input type="checkbox"/> Other Suppression <input type="checkbox"/> # of Heads _____

Building Characteristics	Utilities
SF Dwelling <input type="checkbox"/> SF Townhouse <input type="checkbox"/> Depth _____ Width _____ 1 st floor: _____ 2 nd floor: _____ Basement: _____	Water Supply: _____ <input type="checkbox"/> Public <input type="checkbox"/> Private
Finished Basement <input type="checkbox"/> Unfinished Basement <input type="checkbox"/> Crawl space <input type="checkbox"/> Slab on Grade <input type="checkbox"/> No. of Bedrooms _____	Sewage Disposal: _____ <input type="checkbox"/> Public <input type="checkbox"/> Private
Multi-family dwellings: No. of efficiency units: _____ No. of 1 BR units: _____ No. of 2 BR units: _____ No. of 3 BR units: _____	Electric Yes <input type="checkbox"/> No <input type="checkbox"/> Gas Yes <input type="checkbox"/> No <input type="checkbox"/>
Other Structure: _____ Dimensions: _____ Footings: _____ Roof: _____ <input type="checkbox"/> State Certified Modular <input type="checkbox"/> Manufactured Home	Heating System: _____ Electric <input type="checkbox"/> Oil <input type="checkbox"/> Natural Gas <input type="checkbox"/> Propane Gas <input type="checkbox"/>
	Sprinkler system: N/A <input type="checkbox"/> <input type="checkbox"/> NFPA #13D <input type="checkbox"/> NFPA #13R <input type="checkbox"/> Other: _____

THE UNDERSIGNED HEREBY CERTIFIES AND AGREES AS FOLLOWS: (1) THAT HE/SHE IS AUTHORIZED TO MAKE THIS APPLICATION; (2) THAT THE INFORMATION IS CORRECT; (3) THAT HE/SHE WILL COMPLY WITH ALL REGULATIONS OF HOWARD COUNTY WHICH ARE APPLICABLE THERETO; (4) THAT HE/SHE WILL PERFORM NO WORK ON THE ABOVE REFERENCED PROPERTY NOT SPECIFICALLY DESCRIBED IN THIS APPLICATION; (5) THAT HE/SHE GRANTS COUNTY OFFICIALS THE RIGHT TO ENTER ONTO THIS PROPERTY FOR THE PURPOSE OF INSPECTING THE WORK PERMITTED AND POSTING NOTICES.

Applicant's Signature _____
 Email Address _____
 Title/Company _____

Print Name _____
 Date 1/13/10


Checks payable to: **DIRECTOR OF FINANCE OF HOWARD COUNTY**
 PLEASE WRITE NEATLY AND LEGIBLY
 - FOR OFFICE USE ONLY -

AGENCY	DATE	SIGNATURE APPROVAL
Land Development, DPZ		
State Highways		
Building Officials		
Dev. Engineering, DPZ		
Health		<u>[Signature]</u>
Fire Protection		
Is Sediment Control approval required prior to issuance? YES <input type="checkbox"/> NO <input type="checkbox"/>		

DPZ SETBACK INFORMATION
Front: _____
Rear: _____
Side: _____
Side St.: _____
All minimum setbacks met? YES <input type="checkbox"/> NO <input type="checkbox"/>
Is Entrance Permit Required? YES <input type="checkbox"/> NO <input type="checkbox"/>
Historic District? YES <input type="checkbox"/> NO <input type="checkbox"/>
Lot Coverage for New Town Zone _____
SDP/Red-line approval date _____


PROPERTY ID #
Filing fee \$ _____
Permit fee \$ <u>100</u>
Excise tax \$ _____
Add'l per fee \$ <u>10</u>
TOTAL FEES \$ _____
Sub-total paid \$ _____
Balance due \$ _____
Check # _____
Validation # _____
Accepted by _____

CONTINGENCY CONSTRUCTION START:
 ONE STOP SHOP:

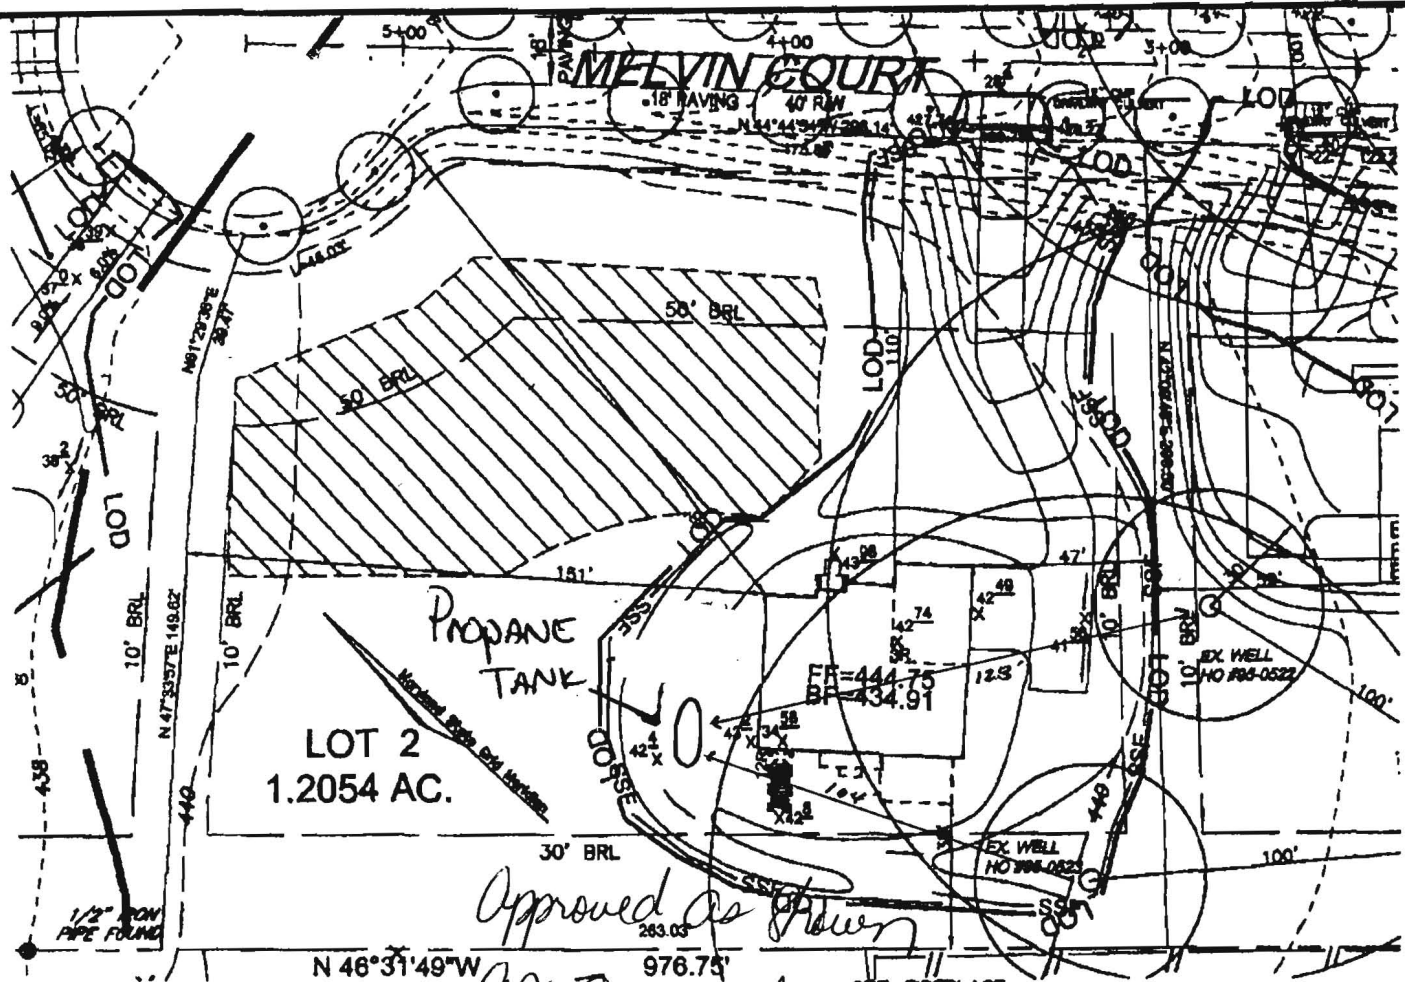

Approved as Shown
as Shown for
 BP# B10002551

THE EXISTING WELL SHOWN ON LOT 2 TAG NO. HO-95-0523 HAVE BEEN FIELD LOCATED BY ROBERT H. VOGEL ENGINEERING, INC.
 BUILDING OF LOT 2
 GROSS FLOOR AREA: 3,300 SF.

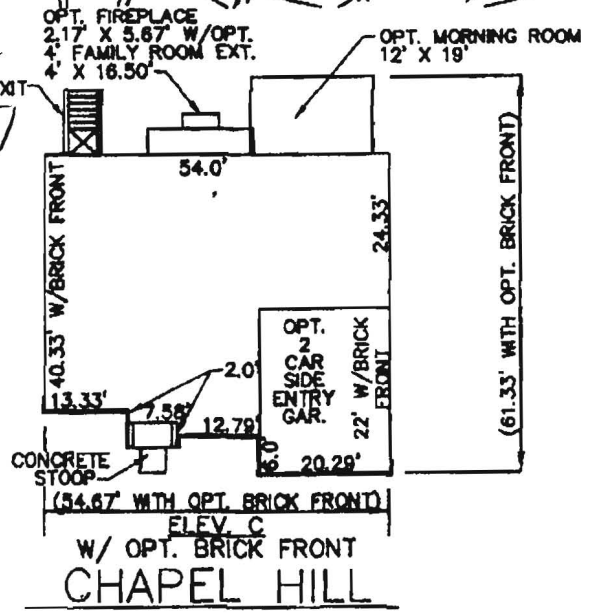


VA ROBERT H. VOGEL ENGINEERING, INC.
 ENGINEERS • SURVEYORS • PLANNERS
 8407 MAIN STREET ELLICOTT CITY, MD 21043 TEL: 410.481.7666 FAX: 410.481.8981

W/ OPT. BRICK FRONT
CHAPEL HILL
 SCALE: 1" = 30'

SCALE: 1"=50'
 DRAWN BY: KG/HS
 CHECKED BY: RHV
 DATE: JUNE 2010
 W. O. #: 04-49
 SHEET # 1 OF 1

NV HOMES SCAGGSVILLE KNOLLS
 F-06-091
 LOT 2
 11211 MELVIN COURT
 TAX MAP 46 BLOCK 3&9
 5TH ELECTION DISTRICT
 PARCEL 118
 HOWARD COUNTY, MARYLAND

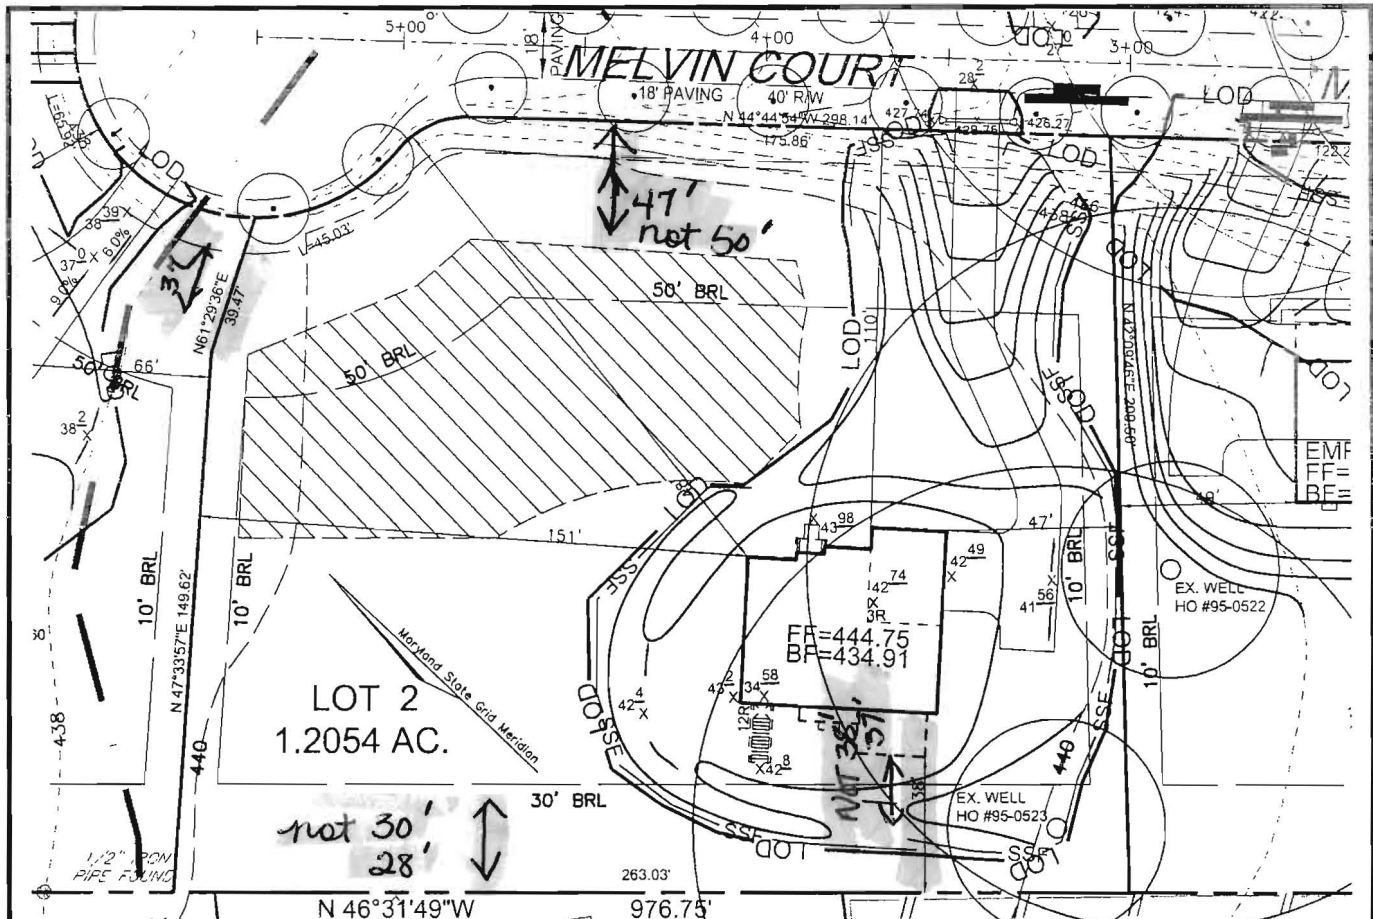


LOT 2
1.2054 AC.

not 30'
28'

- OPT. FIREPLACE 2.17' X 5.67' W/OPT. 4' FAMILY ROOM EXT.
- OPT. MORNING ROOM 12' X 19'
- EX. WELL HO #95-0523
- EX. WELL HO #95-0522

THE EXISTING WELL SHOWN ON LOT 2 TAG NO. HO-95-0523 HAVE BEEN FIELD LOCATED BY ROBERT H. VOGEL ENGINEERING, INC. BUILDING OF LOT 2 GROSS FLOOR AREA: 3.300 SF.

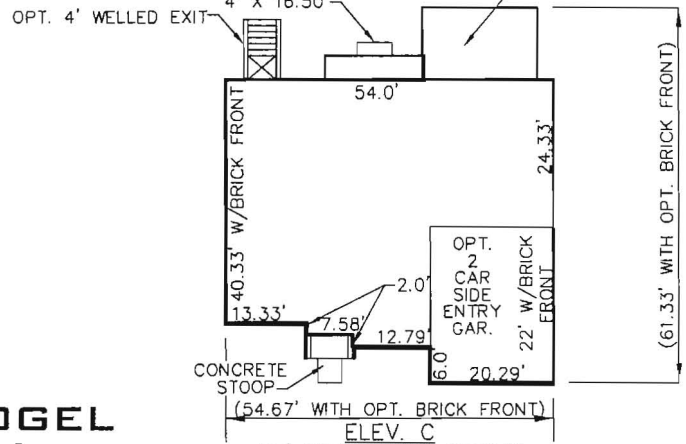

ROBERT H. VOGEL ENGINEERING, INC.
ENGINEERS • SURVEYORS • PLANNERS
8407 MAIN STREET TEL: 410.461.7666
ELLCOTT CITY, MD 21043 FAX: 410.461.8961


ELEV. C
W/ OPT. BRICK FRONT
CHapel Hill
SCALE: 1" = 30'

SCALE: 1"=50'
DRAWN BY: KG/HS
CHECKED BY: RHV
DATE: JUNE 2010
W. O. #: 04-49
SHEET # 1 OF 1


NV HOMES SCAGGSVILLE KNOLLS
F-06-091
LOT 2
11211 MELVIN COURT

TAX MAP 46 BLOCK 3&9 5TH ELECTION DISTRICT
PARCEL 118 HOWARD COUNTY, MARYLAND

RHV 6/25/10

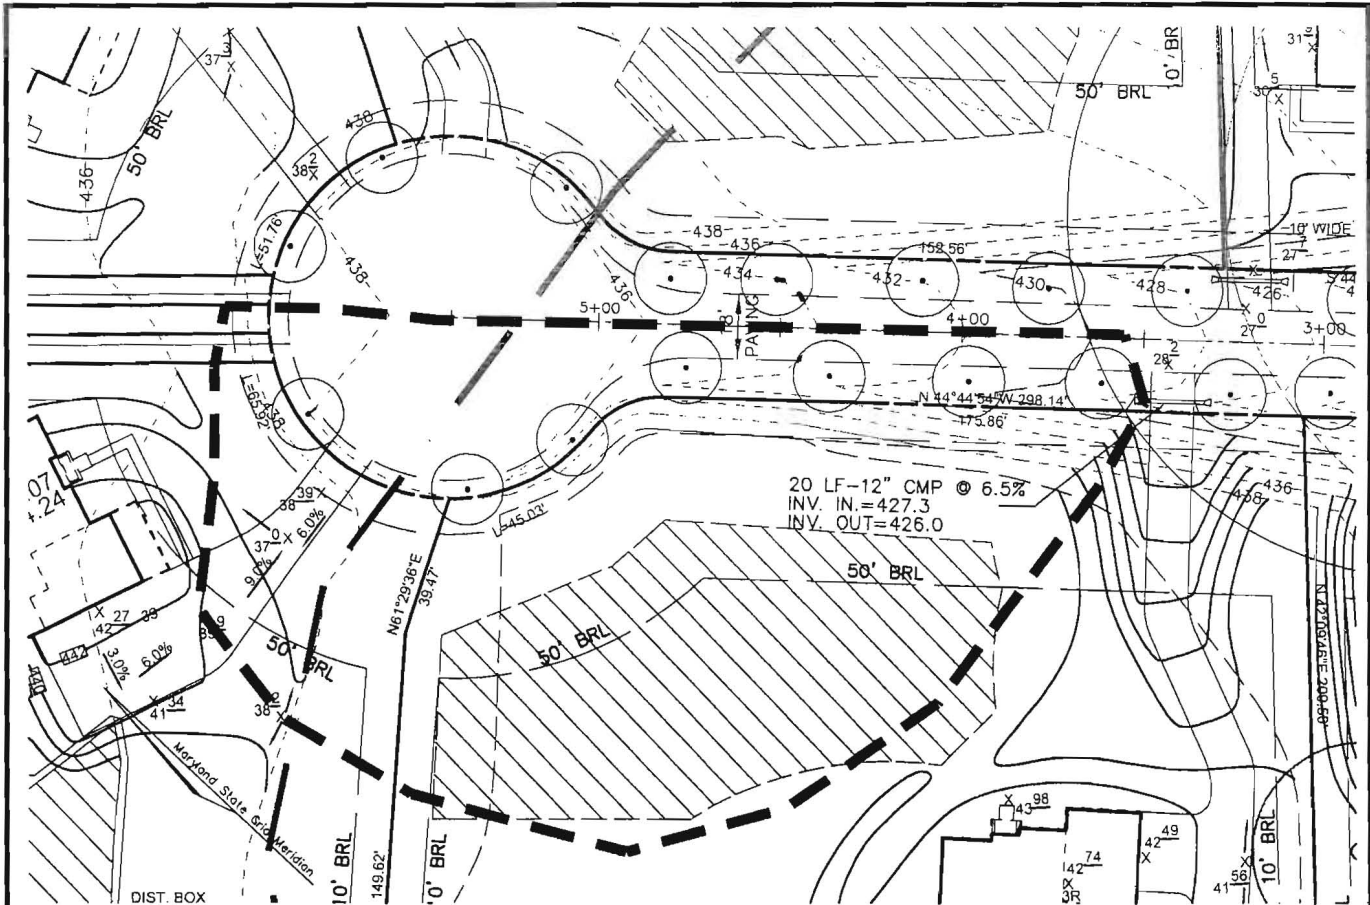

DRAINAGE AREA: 0.67 AC.
 Tc=10.0 MIN.
 I 10YR.=6.6
 C= 0.21(1AC. LOTS, 'B' SOILS)
 Q 10YR= 0.67(6.6)(0.21)
 Q 10R= 0.93 CFS
 V 10YR= 8.38 FPS

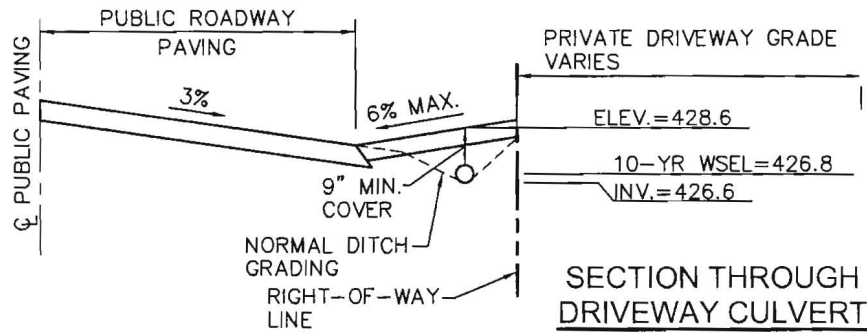

ROBERT H. VOGEL
ENGINEERING, INC.
 ENGINEERS • SURVEYORS • PLANNERS
 8407 MAIN STREET TEL: 410.461.7666
 ELLICOTT CITY, MD 21043 FAX: 410.461.8961

NV HOMES
SCAGGSVILLE KNOLLS
 F-06-091
LOT 2 CULVERT ANALYSIS
11211 MELVIN COURT

SCALE: 1"=50'
 DRAWN BY: KG/HS
 CHECKED BY: RHV
 DATE: JUNE 2010
 W. O. #: 04-49
 SHEET # 1 OF 1

TAX MAP 46 BLOCK 3&9
 5TH ELECTION DISTRICT

PARCEL 118
 HOWARD COUNTY, MARYLAND

K:\Projects\04-49\ENGR\dwg\FINAL PH-INRESITE\CULVERT LOT 2.dwg, 6/25/2010 7:37:03 AM, coglie

Handwritten signature and date: 6/25/10