

7-12-63
late P.M.

file

PERMIT

P 07119
A 06486

SEWAGE DISPOSAL SYSTEM

MARYLAND STATE DEPARTMENT OF HEALTH

HOWARD COUNTY

ELLICOTT CITY

DISTRICT 2

DATE 7/10/63

INDEXED

INDEXED

Emerson Faaga IS PERMITTED TO INSTALL ALTER

ADDRESS _____ PHONE _____

A SEWAGE DISPOSAL SYSTEM LOCATED AT Old Annapolis Rd. - about 1/4 mile S south of Centennial Lane on right

SUBDIVISION _____ ROAD _____ LOT _____

PROPERTY OWNER Betty A. Gerwig

ADDRESS _____

SPECIFICATIONS

DRAIN FIELD _____ DEPTH _____ FEET, BOTTOM AREA _____ SQ. FT.

SEEPAGE PITS X ABSORBENT SIDE-WALL AREA 450 SQ. FT. below top 4 ft. of clay

SEPTIC TANK CAPACITY 750 GALLONS

FOR GARBAGE GRINDER, INCREASE DISPOSAL AREA 22% & TANK CAPACITY 50%.


OTHER Place dry wells 15 to 35 ft. from back lot line and 50 to 80 ft. from left side of lot as seen when facing lot from Old Annapolis Rd.

PLANS APPROVED BY Raymond Hodges DATE 4/16/63

FILL SEPTIC TANK AND DISTRIBUTION BOX WITH WATER BEFORE CALLING FOR AN INSPECTION. COVER NO WORK UNTIL INSPECTED AND APPROVED.

NEITHER THE HOWARD COUNTY COMMISSIONERS NOR THE HEALTH DEPARTMENT IS RESPONSIBLE FOR THE SUCCESSFUL OPERATION OF ANY SYSTEM.

Handwritten signature/initials

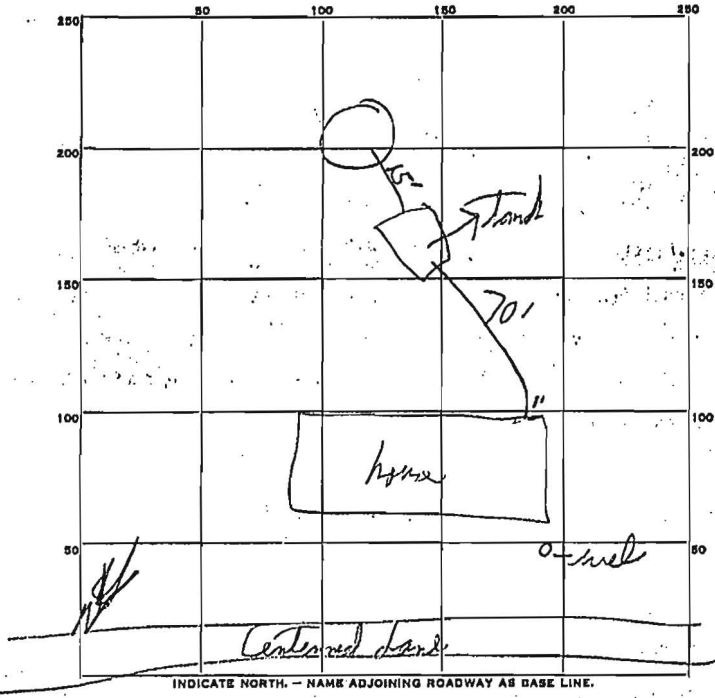

PERMIT CARD _____
 SEPTIC TANK, LEVEL _____ CLEANOUTS _____
 DISTRIBUTION BOX, LEVEL _____

TILE FIELD, DEPTH _____ FT. TRENCH WIDTH _____ FT.
 GRAVEL DEPTH _____ IN. TOTAL LENGTH _____ FT.
 NUMBER OF TRENCHES _____ TOTAL BOTTOM AREA _____
 SEEPAGE PITS, INSIDE DIAMETER 14 FT. DEPTH BELOW INLET 11 FT. 3"
 ABSORBENT AREA 4737 SQ. FT.

REMARKS _____

DATE SYSTEM APPROVED 7/12/63 INSPECTOR P.W.

14
 43
 11
 43
 43
 43
 73