

4/7/66 - Approved - J.H.K.

4/7/66
After 3 PM

PERMIT

SEWAGE DISPOSAL SYSTEM

MARYLAND STATE DEPARTMENT OF HEALTH

HOWARD COUNTY

ELLICOTT CITY

P 11427

A 10316

DISTRICT 6

DATE 1/18/66

INDEXED

W. W. Wagner IS PERMITTED TO INSTALL ALTER

ADDRESS Gamber Road, Finksburg, Maryland PHONE _____

A SEWAGE DISPOSAL SYSTEM LOCATED AT Oakland Mills Rd.

SUBDIVISION _____ ROAD Oakland Mills Rd. LOT _____

PROPERTY OWNER Charles W. Wickes & Wife

ADDRESS Oakland Mills Rd., Ellicott City, Md.

SPECIFICATIONS - 3 bedrooms

DRAIN FIELD _____ DEPTH _____ FEET, BOTTOM AREA _____ SQ. FT.

SEEPAGE PITS _____ ABSORBENT SIDE-WALL AREA _____ SQ. FT.

SEPTIC TANK CAPACITY 750 GALLONS

FOR GARBAGE GRINDER, INCREASE DISPOSAL AREA 22% & TANK CAPACITY 50%.

OTHER Two dry wells each 10 ft. in dia. by 9 ft. deep below the inlet pipe.


First dry well to be located 12 ft. from rear lot line and 18 ft. from left side line as seen when facing lot from Oakland Mills Rd. Second dry well to be at least 30 ft. from first one measured edge to edge. Locate inlet pipes 3 ft. below present grade.

PLANS APPROVED BY J. H. Kilmore DATE 6/22/65

FILL SEPTIC TANK AND DISTRIBUTION BOX WITH WATER BEFORE CALLING FOR AN INSPECTION. COVER NO WORK UNTIL INSPECTED AND APPROVED.

NEITHER THE HOWARD COUNTY COMMISSIONERS NOR THE HEALTH DEPARTMENT IS RESPONSIBLE FOR THE SUCCESSFUL OPERATION OF ANY SYSTEM.

A 10316

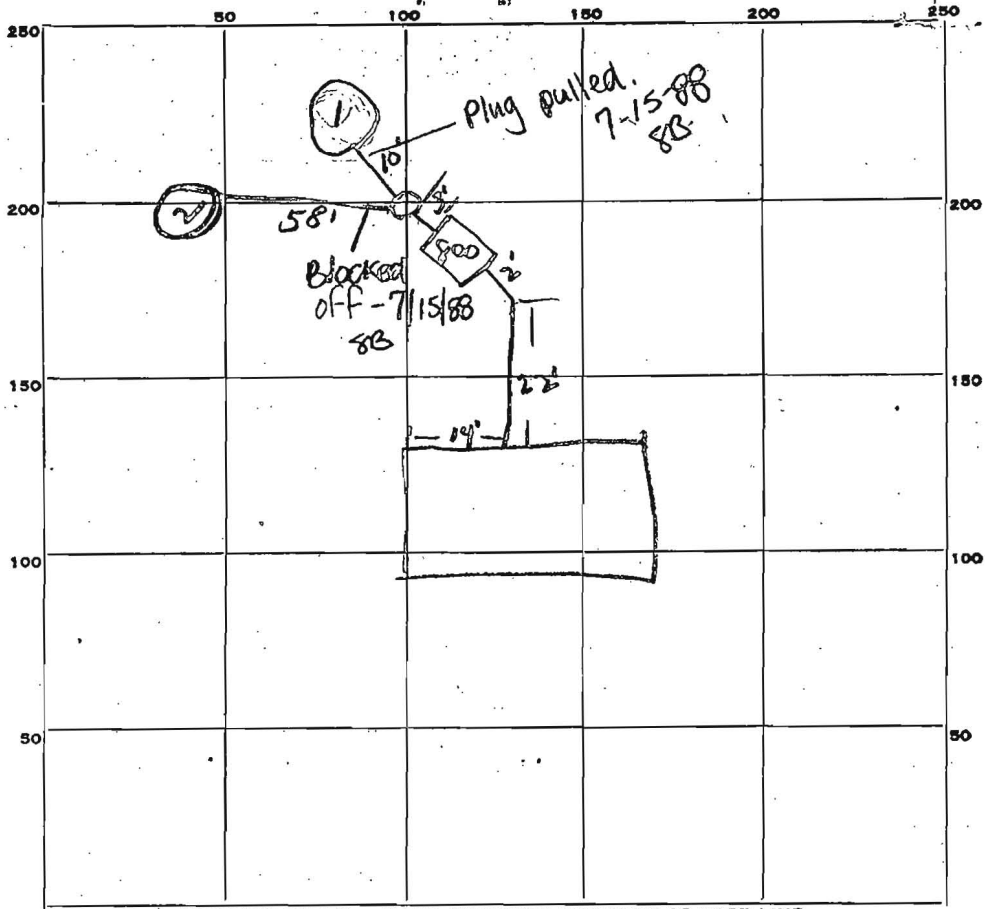

INDICATE NORTH. - NAME ADJOINING ROADWAY AS BASE LINE.

PERMIT CARD OK Oakland Mills Rd

SEPTIC TANK, LEVEL OK CLEANOUTS OK

DISTRIBUTION BOX, LEVEL OK

TILE FIELD, DEPTH _____ FT. TRENCH WIDTH _____ FT.

GRAVEL DEPTH _____ IN. TOTAL LENGTH _____ FT.

NUMBER OF TRENCHES _____ TOTAL BOTTOM AREA _____

SEEPAGE PITS, INSIDE DIAMETER #1-11 FT. DEPTH BELOW INLET #1-9 FT.
#2-11 FT. #2-9 FT.

ABSORBENT AREA 620 SQ. FT.

REMARKS _____

DATE SYSTEM APPROVED 4/7/46 INSPECTOR J.H. Kilmore