

NOT TO BE USED BEFORE DRILLING IS STARTED.

A10316

Wicks jet

APPLICATION FOR PERMIT TO DRILL WELL

No. 579

Owner Associated Home Builders
Street or R. F. D. 29 W Biddle St.
Post Office Baltimore 3, Md.

Driller Russell Hester License Number 132
Street or R. F. D. 2524 Old Frederick Rd.
Post Office Catonville 28, Md.
Date 2/12/66

Quantity of Water to be Produced 5 G.P.M.
Total Quantity Needed For Use 300 G.P.D.
Use for Water New House
Approximate Depth of Well (feet) 60
Method of Drilling to be used cable

Location of Well
Subdivision _____
Section _____ Lot _____
County Howard
Nearest Town Ellicott City
Distance from Town 3 miles
Direction from Town South

Is this a Replacement Well? Yes - No
If YES, indicate date abandoned well is to be sealed: _____
and by whom: _____

Description of Location of Well
(This information should be definite enough to permit locating well on a county map.)
Near what road Oakland Mills Rd
On which side of road North
(North, East, South, West)
Distance from road 100 ft.

PERMIT TO DRILL WELL
(Not To Be Filled In By Driller)

Well Permit No. HO-66-W-250

Samples of Cuttings Required by Department: Yes No
Owner Requires Permit to appropriate Water: Yes No
Owner Has Permit to appropriate Water: Yes No


Appropriation Permit No. _____
The applicant is herewith granted a permit to drill this well subject to the conditions stipulated.

Paul W. McKee Director 2-18-66 Date

THIS PERMIT IS NOT TRANSFERABLE
WITHOUT WRITTEN PERMISSION FROM THE DEPARTMENT
Special conditions that must be observed:

Health Department Approval of Application
Howard County Department of Health
or State Department of Health
Approved by Ronald Fletcher
Title Sanitarian
Date 2/16/66

Draw a sketch below showing location of well in relation to nearby towns, roads, and streams with north in the direction of the arrow, and give distance from well to nearest road junction or stream crossing shown on the sketch.

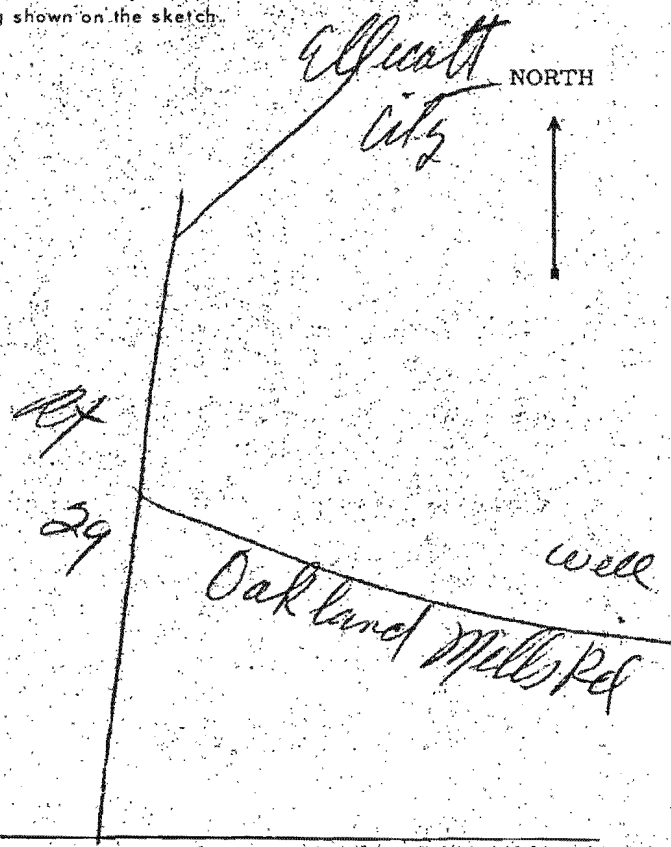

THIS REPORT
MUST BE SUBMITTED
WITHIN 30 DAYS
AFTER COMPLETION
OF THE WELL

WELL COMPLETION REPORT

WELL DESCRIPTION

WELL LOG
State the kind of formations penetrated, their color, their depth, their thickness, and if water-bearing

CASING AND SCREEN RECORD
State the kind and size and position of casing, liner, shoe, screen, and other accessories (if no casing used, give diameter of well).

	FEET		DIAM. (inches)	FEET	
	from	to		from	to
Dirt quicksand sandstone	0	19	Steel 6 1/4	0	51
	19	46			
	46	57			
Water entering 52-54 ft					

Permit Number H066W250
Owner Associated Home Builders
Address 2910 Buckle St.
Subdivision _____
Section _____ Lot _____

PUMPING TEST
Hours Pumped 2
Type of Pump Used Boiler
Pumping Rate 8
Gallons per Minute _____


WATER LEVEL
Distance from land surface to water:
Before Pumping 20 Ft.
When Pumping 44 Ft.

APPEARANCE OF WATER
Clear Cloudy
Taste good
Odor none

Height of Casing Above Land
Surface 2 Ft.

PUMP INSTALLED
Type NONE
Capacity _____
Gallons per Minute _____
Gallons per Hour _____
Pump Column Length _____ Ft.

LOCATION OF WELL ON LOT
Show permanent structures such as building(s), septic tank, and/or other landmarks and indicate not less than 2 distances (measurements) to well.

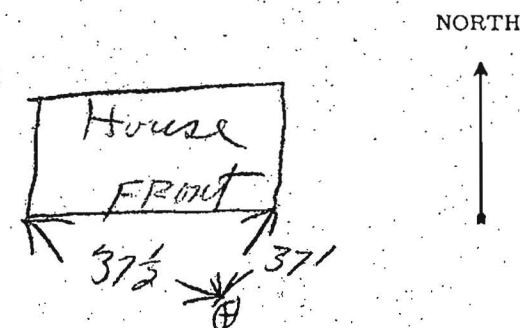

Date Well Completed: 3/1/66
Well Driller: Russell B. Justice
Signature: [Signature]