



PERCOLATION CERTIFICATION PLAN

OAKLAND FARM LOTS 1-4

LOT 1
PLAT NO. 9307

THE PURPOSE OF THIS PLAN IS TO MODIFY THE LIMITS OF EX. SRA TO ACCOMMODATE POOL INSTALL.

GRID NORTH

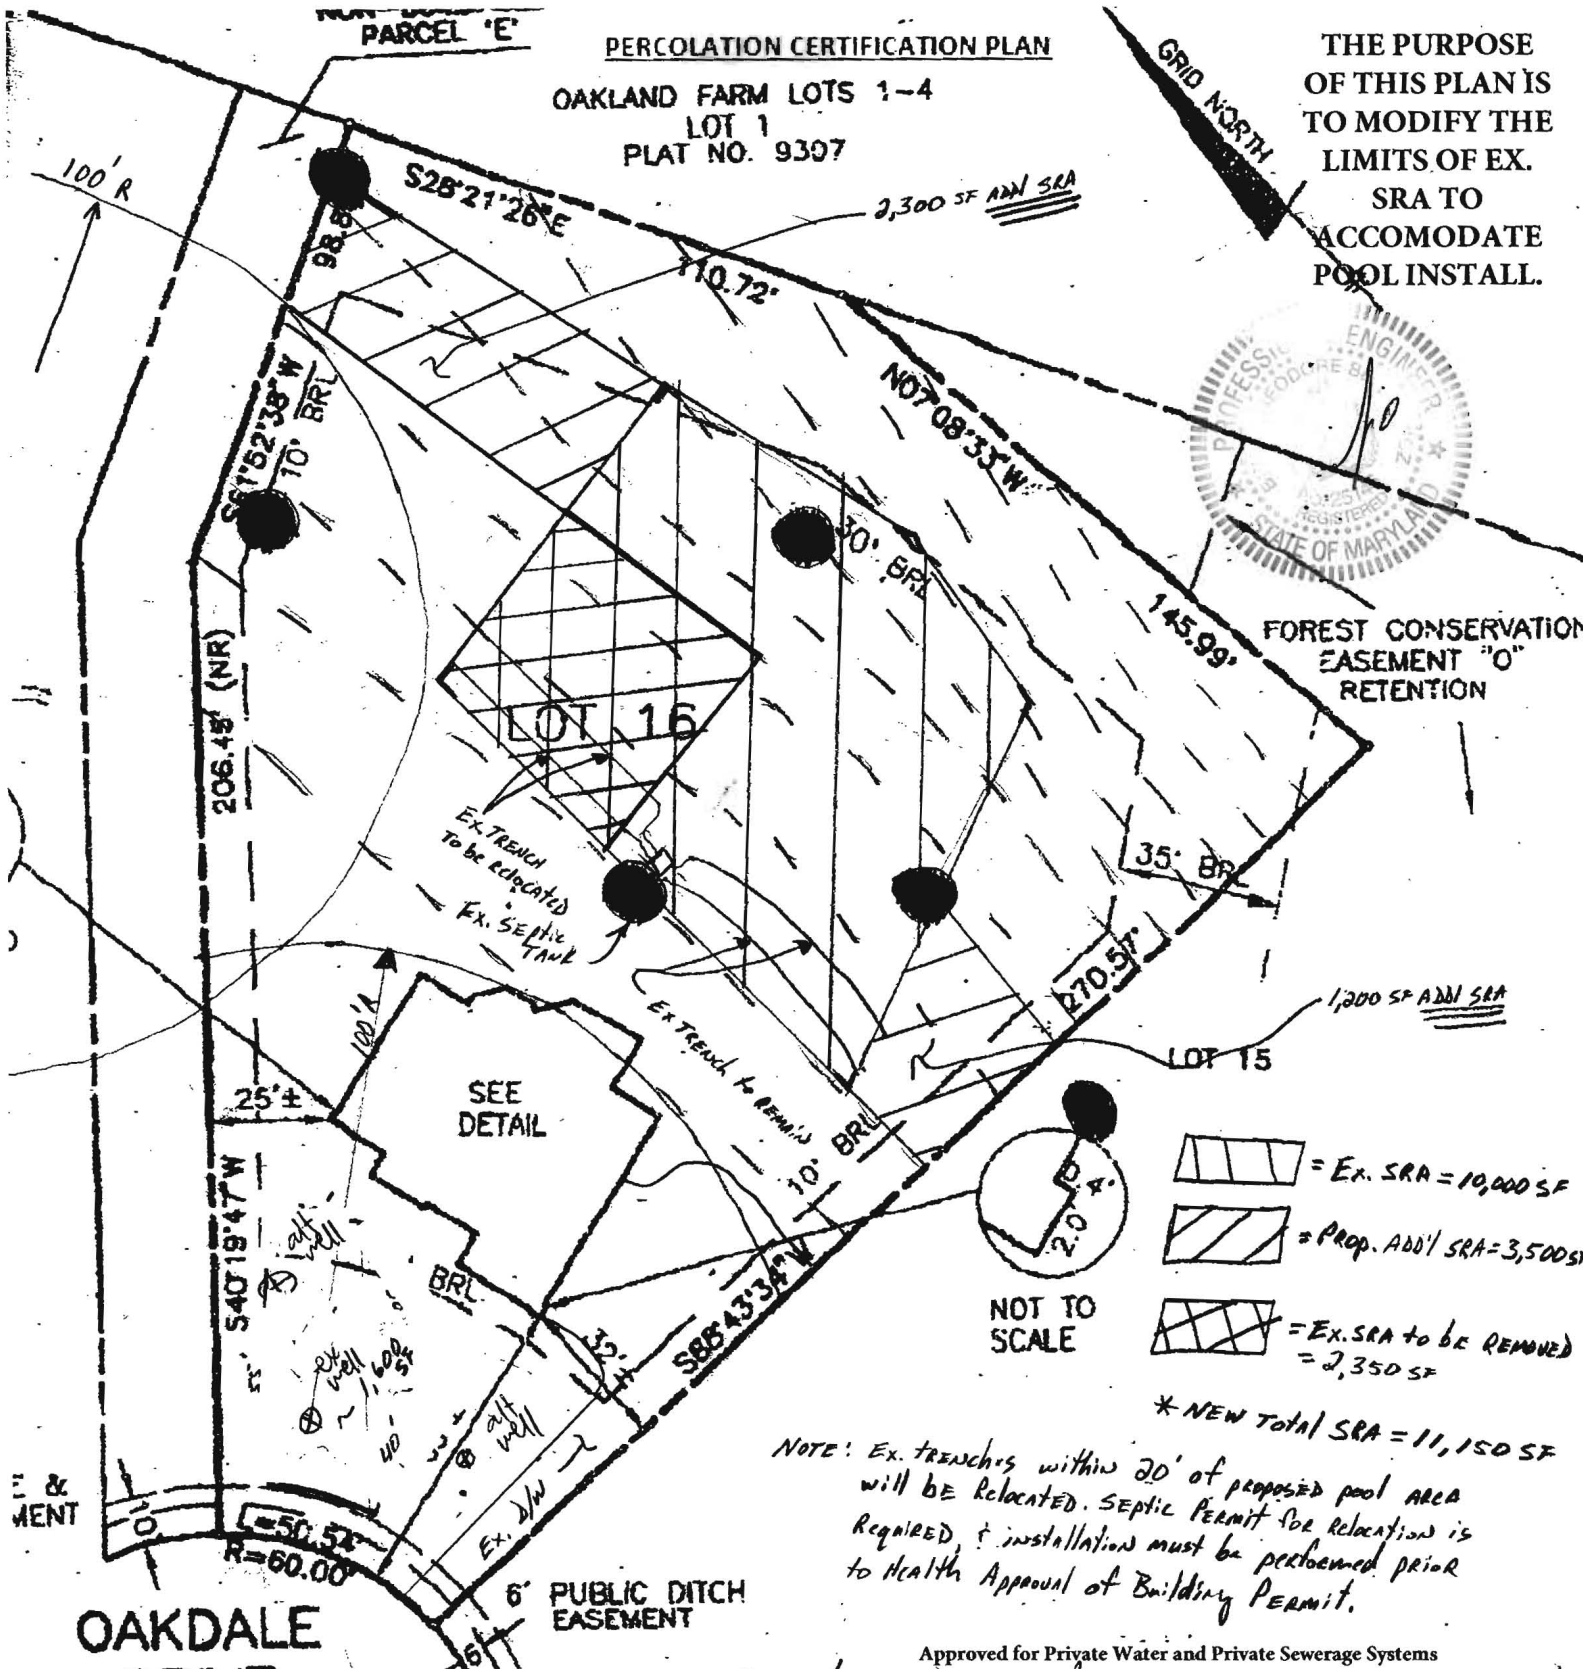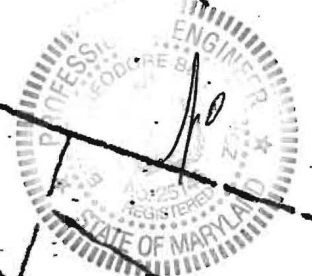

- = Ex. SRA = 10,000 SF
- = Prop. Add'l SRA = 3,500 SF
- = Ex. SRA to be REMOVED = 2,350 SF

* NEW Total SRA = 11,150 SF

NOTE: Ex. TRENCHES within 20' of proposed pool AREA will be Relocated. SEPTIC Permit for Relocation is REQUIRED, & installation must be performed prior to Health Approval of Building Permit.

Approved for Private Water and Private Sewerage Systems

Brian Berkowicz for *Maura Rossman* 10/22/14
Health Officer, Howard County Health Dept. Date *gn*

SCALE 1" = 40'
0 10' 20' 30' 40'

OAKDALE

1766 Oakdale Drive
RECORD PLAT NO. 14088
BRIAN BERKOWICZ (OWNER)

This area designates a private sewerage disposal area of at least 10,000 sq.ft. as required by the Maryland Department of Environment for individual sewerage disposal. Improvements of any nature in this area are restricted. This sewerage disposal area shall become null and void upon connection to a public sewerage system. The County Health Officer shall have authority to grant adjustments to the private sewerage easement. Recordation of a revised sewerage easement shall not be necessary.

The lot shown herein complies with the minimum ownership width and lot area as required by the Maryland Department of Environment.

All wells and septic systems located within 100' of the property boundaries and 200' down gradient of any wells and/or septic have been shown.

Any Changes to a private sewerage easement shall require percolation certification plan.

Pool location to be determined. Pool shall be 20' min from SCA per Ho. Co. Code.