

HOWARD COUNTY
PERMIT APPLICATION

PERMIT NUMBER
00158777

Building Address 14037 S. Monticello Dr.
Cooksville MD 21723
Suite/Apt. #: _____ SDP/M/P/Petition #: _____
Census Tract _____ Subdivision Hartless Manor
Section 1 Area _____ Lot 12
Tax Map 9 Parcel 346 Grid 19
Zoning _____ Map Coordinates _____ Lot size 1.07 AC

Property Owner's Name Perry & Theresa Hook
Address 14037 S. Monticello Dr.
City Cooksville State MD Zip Code 21723
Home Phone 410-489-5975 Work Phone _____
Applicant's Name & Mailing Address, (if other than stated hereon):
Ann Wustner
Phone 443-871-3913 Fax 410-544-5373

Existing Use SFD
Proposed Use Inground pool
Estimated Construction Cost \$ 46,000
Description of Work
Building 20x41 Inground pool
9' deep, 700SF w/ fence to code.

Contractor Company Stevenson Pools
Contact Person Jill Romano
Address 1925 Norfolk Drive
City Opwings State MD Zip Code 20736
License No. State 3
Phone 301-855-6512 Fax 301-855-7068

Occupant or Tenant _____
Contact Name _____
Address _____
City _____ State _____ Zip Code _____
Phone _____ Fax _____

Engineer or Architect Company _____
Contact Person _____
Address _____
City _____ State _____ Zip Code _____
Phone _____ Fax _____

BUILDING DESCRIPTION - COMMERCIAL

BUILDING DESCRIPTION - RESIDENTIAL

~~Building Characteristics~~
Height: _____
No. of stories: _____
Gross area, sq. ft. per floor: _____
Use group: _____
Construction type:
 Reinforced Concrete
 Structural Steel
 Masonry
 Wood Frame
 State Certified Modular

~~Utilities~~
Water Supply: _____
 Public
 Private
Sewage Disposal: _____
 Public
 Private
Electric Yes No
Gas Yes No
Heating System:
Electric Oil
Natural Gas
Propane Gas
Sprinkler system: N/A
 Full
 Partial
 Other Suppression
of Heads _____

~~Building Characteristics~~
SF Dwelling SF Townhouse
Depth _____ Width _____
1st floor: _____
2nd floor: _____
Basement: _____
Finished Basement Unfinished Basement
Crawl space Slab on Grade
No. of Bedrooms _____
Height: _____
Multi-family dwellings:
No. of efficiency units: _____
No. of 1 BR units: _____
No. of 2 BR units: _____
No. of 3 BR units: _____
Other Structure: _____
Dimensions: _____
Footings: _____
Roof Height: _____
 State Certified Modular
 Manufactured Home

~~Utilities~~
Water Supply: _____
 Public
 Private
Sewage Disposal: _____
 Public
 Private
Electric Yes No
Gas Yes No
Heating System:
Electric Oil
Natural Gas
Propane Gas
Sprinkler system: N/A
 NFPA #13D
 NFPA #13R
 Other:

THE UNDERSIGNED HEREBY CERTIFIES AND AGREES AS FOLLOWS: (1) THAT HE/SHE IS AUTHORIZED TO MAKE THIS APPLICATION; (2) THAT THE INFORMATION IS CORRECT; (3) THAT HE/SHE WILL COMPLY WITH ALL REGULATIONS OF HOWARD COUNTY WHICH ARE APPLICABLE THERETO; (4) THAT HE/SHE WILL PERFORM NO WORK ON THE ABOVE REFERENCED PROPERTY NOT SPECIFICALLY DESCRIBED IN THIS APPLICATION; (5) THAT HE/SHE GRANTS COUNTY OFFICIALS THE RIGHT TO ENTER ONTO THIS PROPERTY FOR THE PURPOSE OF INSPECTING THE WORK PERMITTED AND POSTING NOTICES.

Ann Wustner
Applicant's Signature
Kevin Cooper - Agent
Title/Company


ANN M. WUSTNER
Print Name
3/29/06
Date

Checks payable to: **DIRECTOR OF FINANCE OF HOWARD COUNTY**
** PLEASE WRITE NEATLY AND LEGIBLY. **
- FOR OFFICE USE ONLY -

AGENCY	DATE	SIGNATURE APPROVAL
Land Development, DPZ		
State Highways		
Building Official		
Dev. Engineering, DPZ		
Health	<u>3/29/06</u>	<u>[Signature]</u>
Fire Protection		
Is Sediment Control approval required prior to issuance? YES <input type="checkbox"/> NO <input type="checkbox"/>		
CONTINGENCY CONSTRUCTION START: <input type="checkbox"/>		
ONE STOP SHOP: <input type="checkbox"/>		

DPZ SETBACK INFORMATION		PROPERTY ID#:
Front: _____	Filing fee	\$ _____
Rear: _____	Permit fee	\$ _____
Side: _____	Excise tax	\$ _____
Side St.: _____	Add'l per. fee	\$ _____
All minimum setbacks met?	TOTAL FEES	\$ _____
YES <input type="checkbox"/> NO <input type="checkbox"/>	Sub-total paid	\$ _____
Is Entrance Permit required?	Balance due	\$ _____
YES <input type="checkbox"/> NO <input type="checkbox"/>	Check	# _____
Historic District?	Validation	# _____
YES <input type="checkbox"/> NO <input type="checkbox"/>		
Lot Coverage for New Town Zone _____		
SDP/Red-line approval date _____	Accepted by _____	

SCA
1" = 50'

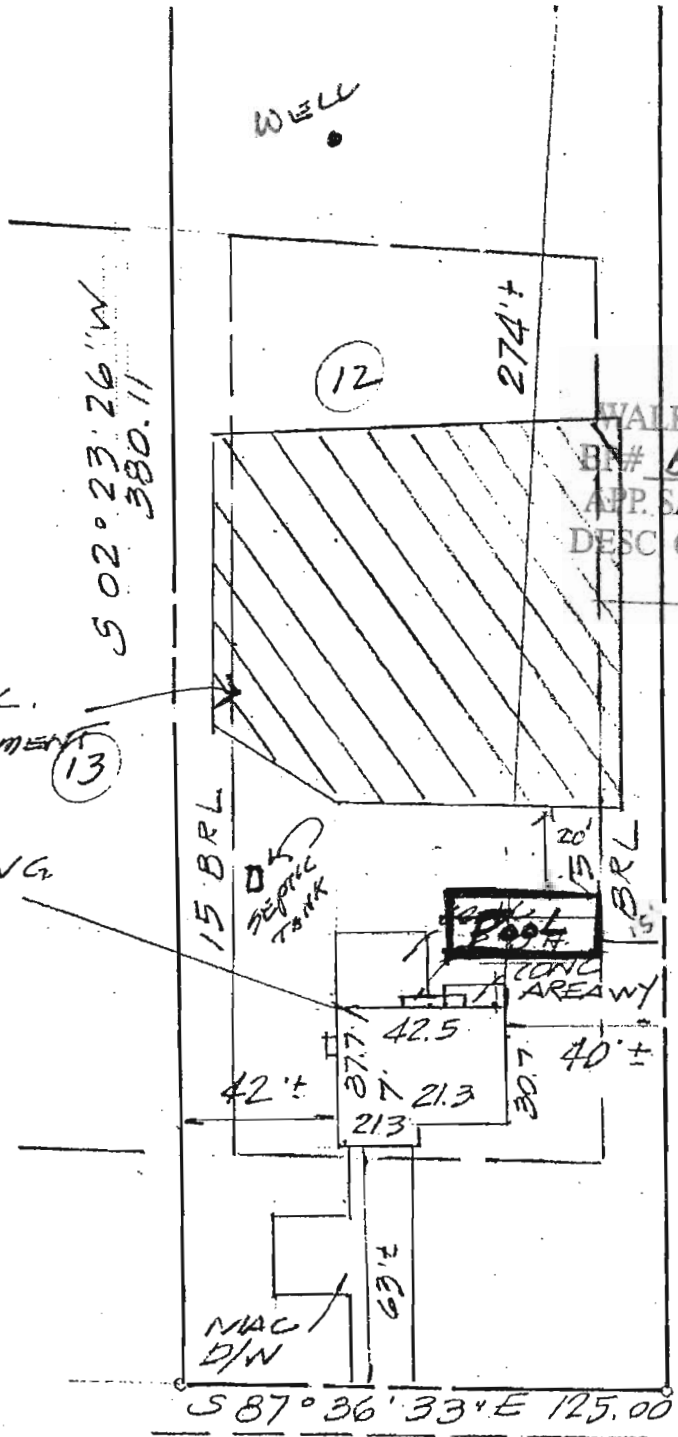

75'
BRL

APPROVED
WALK-THRU BUILDING PERMIT
BY# 600158777 A# 49888-T
APP. SAN SC DATE: 3/29/06
DESC OF WORK:

502023
37222

20x41 in ground pool
w/ fence.



60'
BRL

ED. PAVING
MONTICELLO DRIVE

- .) The plat is of benefit to a consumer only insofar as it is required by a lender or a title insurance company or its agent in connection with contemplated transfer financing or re-financing.
- .) The plat is not to be relied upon for the establishment or location of fences, garages, buildings, or other existing or future improvements.
- .) The plat does not provide for the accurate identification of property boundary lines, but such identification may not be required for the transfer of title or securing financing or refinancing.
- .) I have examined Flood Insurance Rate Map Panel Number 240044 0008B for the subject property and it appears to lie within Zone C per said map.
- .) Dimensions shown to apparent lot line are + 5'.
- .) Date of field work: 12.6.04.

LOT N#12
PH1
HARLESS
MANOR
(12025)
4TH ELDIST.
HOCO, MD

LOCATION DRAWING