

LAYOUT 8/23/07 ^(KW) INSP 4 _____
 INSP 2 8/24/07 ^(KW) INSP 5 _____
 INSP 3 _____ INSP 6 _____

ISSUE DATE: 8/08/07
 APPROVAL DATE: 8/24/07 ^(KW)

P 527288
 A 527262

PERMIT
 TAX ID #
ON-SITE SEWAGE DISPOSAL SYSTEM
HOWARD COUNTY HEALTH DEPARTMENT
BUREAU OF ENVIRONMENTAL HEALTH

Linda - Lee Earle IS PERMITTED TO INSTALL ALTER

ADDRESS: same as below PHONE NUMBER: 443-858-4029

SUBDIVISION: _____ LOT NUMBER: _____

ADDRESS: 6980 Mink Hollow Rd PROPERTY OWNER: Mark Millstein/Linda-Lee Earle

SEPTIC TANK CAPACITY (GALLONS): 2000 OUTLET BAFFLE FILTER REQUIRED

PUMP CHAMBER CAPACITY (GALLONS): N/A COMPARTMENTED TANK REQUIRED

NUMBER OF BEDROOMS: 4

SQUARE FEET PER BEDROOM: N/A


LINEAR FEET OF TRENCH REQUIRED: 138

TRENCHES:	Trench to be 3 feet wide. Inlet 3 feet below original grade. Bottom maximum depth 6 feet below original grade. Effective area begins at 5 feet below original grade. 3 feet of stone below distribution pipe.
LOCATION:	
NOTES:	Layout inspection required prior to system installation. Existing trench to be abandoned. Currently have a 1000 gallon tank. An additional 1000 gallon piggy back tank is acceptable if space is available.

PLANS APPROVED: SF DATE: 8/7/07

- NOTE: PERMIT VOID AFTER 2 YEARS
- NOTE: CONTRACTOR RESPONSIBLE FOR SCHEDULING A PRE-CONSTRUCTION INSPECTION FOR ALL INSTALLATIONS
- NOTE: WATERTIGHT SEPTIC TANKS REQUIRED
- NOTE: ALL PARTS OF SEPTIC SYSTEM SHALL BE 100 FEET FROM ANY WATER WELL
- NOTE: MANHOLE RISERS REQUIRED ON ALL SEPTIC TANKS AND PUMP CHAMBERS UNLESS SPECIFICALLY AUTHORIZED

NEITHER THE HOWARD COUNTY COUNCIL NOR THE HEALTH DEPARTMENT IS RESPONSIBLE FOR THE SUCCESSFUL OPERATION OF ANY SYSTEM PERMITTEE RESPONSIBLE FOR OBTAINING FINAL APPROVAL ON THIS PERMIT CALL 410-313-1771 FOR INSPECTION OF SEPTIC SYSTEM

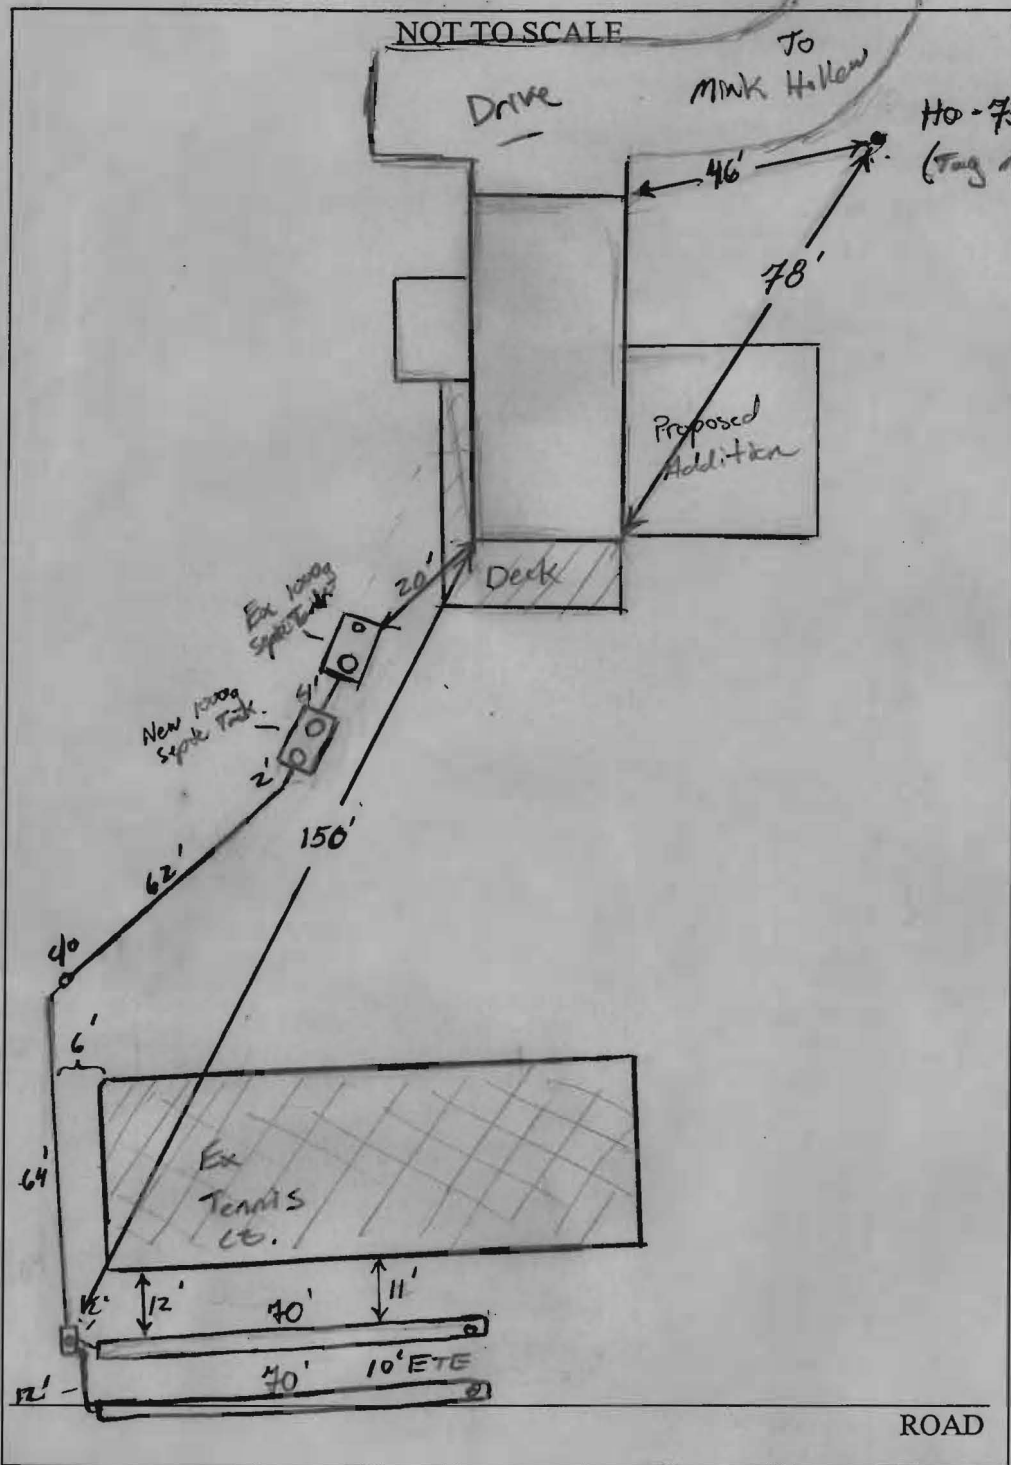

TRENCH/DRAINFIELD DATA		
WIDTH	INLET	BOTTOM
3	3-3.5'	6'
NUMBER OF TRENCHES		2
TOTAL LENGTH		140'
ABSORPTION AREA		420'±SW
DISTRIBUTION BOX LEVEL		Leveled
DISTRIBUTION BOX BAFFLE		Yes
DISTRIBUTION BOX PORT		Yes

SEPTIC TANK DATA	
SEPTIC TANK 1 LEVEL	Tilt to rear
CAPACITY	1000 GAL
SEAM LOC	mid
TANK LID DEPTH	4'
BAFFLES	Rear?
BAFFLE FILTER	—
MANHOLE LOC	Rear
6" PORT LOC	Front
WATERTIGHT TEST	—
SEPTIC TANK 2 LEVEL	Yes
CAPACITY	1000g GAL
SEAM LOC	Top
TANK LID DEPTH	4'
BAFFLES	Yes
BAFFLE FILTER	—
MANHOLE LOC	Foot/Rear
6" PORT LOC	—
WATERTIGHT TEST	—

PRE-CONSTRUCTION 8/23/07
 New 1000g S.T. to be added.
 Need 2 manhole risers front
 and rear of new S.T.

Install 2x 40' trenches on contour downhill of ex house just
 below tennis court. (KW) 8/24/07 System
 complete. D box leveled out w/ levels. Could not get
 triangulation on ends of trenches due to dense trees and
 shrubs blocking view. OK to cover (KW)

FINAL INSPECTOR H. Wall DATE OF APPROVAL 8/24/07