

*Re-test*  
*6/24/65*  
*9:30*  
*Thompson*

# APPLICATION

A 10391

SEWAGE DISPOSAL TESTING

P \_\_\_\_\_

MARYLAND STATE DEPARTMENT OF HEALTH

HOWARD COUNTY

ELLICOTT CITY

DISTRICT 4

Tank: 750401

DATE 6/24/65

Dry Wells - 2 dry wells - each 16 ft sq pit (auger cut 12 ft diameter by and out of area pit filled with gravel). Each dry well 8 ft deep below sidewalk pipes. Sidewalk pipes to be 18" 5" deep below ground.

Place one dry well 8 ft back directly behind left rear corner of house and second dry well about 65 ft behind right rear corner of house as shown when facing out from Mullers Mill Rd.

TO: THE COUNTY HEALTH OFFICER  
ELLICOTT CITY, MARYLAND

I, HEREBY, APPLY FOR THE NECESSARY TESTS IN ORDER TO CONSTRUCT OR RECONSTRUCT A SEWAGE DISPOSAL SYSTEM.

PROPERTY OWNER Carl S. Johnson

ADDRESS Cooksville PHONE HV 9-4769

PROPERTY LOCATION:

SUBDIVISION \_\_\_\_\_ LOT NO. \_\_\_\_\_

ROAD AND DESCRIPTION Miller's Mill Rd. - 1/2 mile from Bushy Park Rd. on right  
(about 2 feet past Cemetery Road).

OCCUPANT \_\_\_\_\_ PHONE \_\_\_\_\_

PERSON TO CONSTRUCT SYSTEM \_\_\_\_\_

ADDRESS \_\_\_\_\_ PHONE \_\_\_\_\_

SIZE OF LOT 1 acre TYPE BLDG. two bedrooms  
NUMBER OF BEDROOMS 2

IF NOT SINGLE RESIDENCE DESCRIBE \_\_\_\_\_

SIGNATURE OF APPLICANT /s/ Carl S. Johnson


APPROVED BY W. Thompson FOR Sec (11/15/65) DATE 6-29-65  
(KIND OF SYSTEM)

REJECTED BY \_\_\_\_\_ FOR \_\_\_\_\_ DATE \_\_\_\_\_  
(KIND OF SYSTEM)

HOLD PENDING FURTHER TESTS \_\_\_\_\_ DATE \_\_\_\_\_

REASONS FOR REJECTION OR HOLDING \_\_\_\_\_

## THIS IS NOT A PERMIT

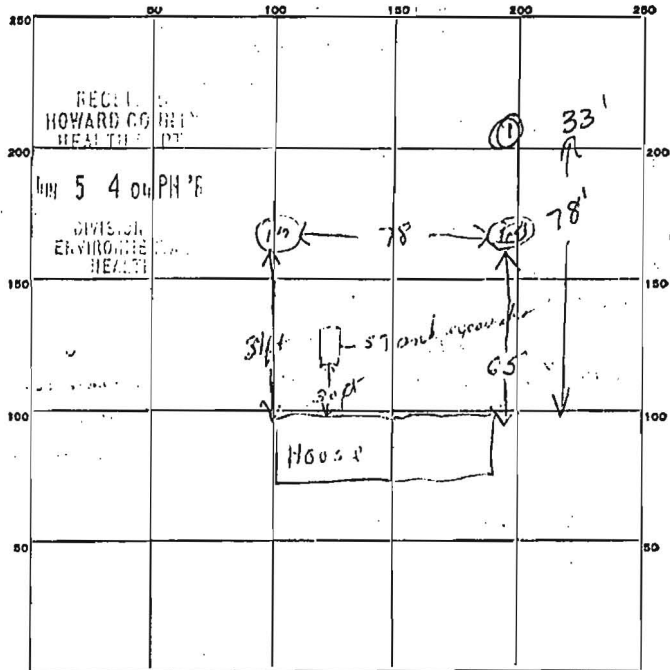

89  
39

INDICATE NORTH - NAME ADJOINING ROADWAY AS BASE LINE.

Melvin Rd

DATE	TEST NO.	DEPTH	PRE-WET		TEST - 1" DROP		TIME
			START	STOP	START	STOP	
6-21-65	1	10 1/2"	9 05	9 15	9 15	9 38	23 min
	2	5 ft	9 06	9 17	9 17	9 45	23 min
	3	9 ft	9 11	9 22	9 22	9 43	21 min
A056 67	1	9	116	123	123	135	12 min
	1A	5	117	slow pres.			
		top 5' clay		bot 4' sandy soil			

SOIL AUGER FINDING

TESTED BY *skum*

REMARKS

*also present 1/24/65 (Carl) Skum*