

LAYOUT \_\_\_\_\_ INSP 4 \_\_\_\_\_

INSP 2 10/16/08 INSP 5 \_\_\_\_\_

INSP 3 \_\_\_\_\_ INSP 6 \_\_\_\_\_

ISSUE DATE: 10/16/2008

APPROVAL DATE: 10/16/2008

# PERMIT MINOR REPAIR

*(passed into  
Post hole)*

P 529595

A 22602

TAX ID # 04-333020

## ON-SITE SEWAGE DISPOSAL SYSTEM HOWARD COUNTY HEALTH DEPARTMENT BUREAU OF ENVIRONMENTAL HEALTH

Charlie Bobcat Services IS PERMITTED TO INSTALL  ALTER

ADDRESS: \_\_\_\_\_ PHONE NUMBER: \_\_\_\_\_

SUBDIVISION: \_\_\_\_\_ LOT NUMBER: \_\_\_\_\_

ADDRESS: 14524 Monticello Dr. PROPERTY OWNER: Sharon Faina

SEPTIC TANK CAPACITY (GALLONS): Existing OUTLET BAFFLE FILTER REQUIRED

PUMP CHAMBER CAPACITY (GALLONS): N/A COMPARTMENTED TANK REQUIRED

NUMBER OF BEDROOMS: N/A

SQUARE FEET PER BEDROOM: N/A

LINEAR FEET OF TRENCH REQUIRED: N/A

TRENCHES:	No new trenches permitted under Minor Repair Permit
LOCATION:	Purpose of this permit is to allow a septic contractor to fix a broken sewer pipe coming out of ex. Dry well to ex. Trench.
NOTES:	Inspection required prior to covering.

PLANS APPROVED: Kevin Wolf DATE: 10/16/2008


- NOTE: PERMIT VOID AFTER 2 YEARS
- NOTE: CONTRACTOR RESPONSIBLE FOR SCHEDULING A PRE-CONSTRUCTION INSPECTION FOR ALL INSTALLATIONS
- NOTE: WATERTIGHT SEPTIC TANKS REQUIRED
- NOTE: ALL PARTS OF SEPTIC SYSTEM SHALL BE 100 FEET FROM ANY WATER WELL
- NOTE: MANHOLE RISERS REQUIRED ON ALL SEPTIC TANKS AND PUMP CHAMBERS UNLESS SPECIFICALLY AUTHORIZED

NEITHER THE HOWARD COUNTY COUNCIL NOR THE HEALTH DEPARTMENT IS RESPONSIBLE FOR THE SUCCESSFUL OPERATION OF ANY SYSTEM PERMITTEE RESPONSIBLE FOR OBTAINING FINAL APPROVAL ON THIS PERMIT CALL 410-313-1771 FOR INSPECTION OF SEPTIC SYSTEM

**SITE INSPECTION SHEET**

OWNER: Sharon Fama PHONE #: \_\_\_\_\_  
 ADDRESS: 14524 Manducello Dr. CONTRACTOR: Charles Bobcat  
 \_\_\_\_\_ WELL TAG #: No Tag  
 SUBDIVISION: \_\_\_\_\_ LOT: \_\_\_\_\_ COUNTY #: 13  
 PROPOSAL: Failing System.

**LOCATION DIAGRAM**

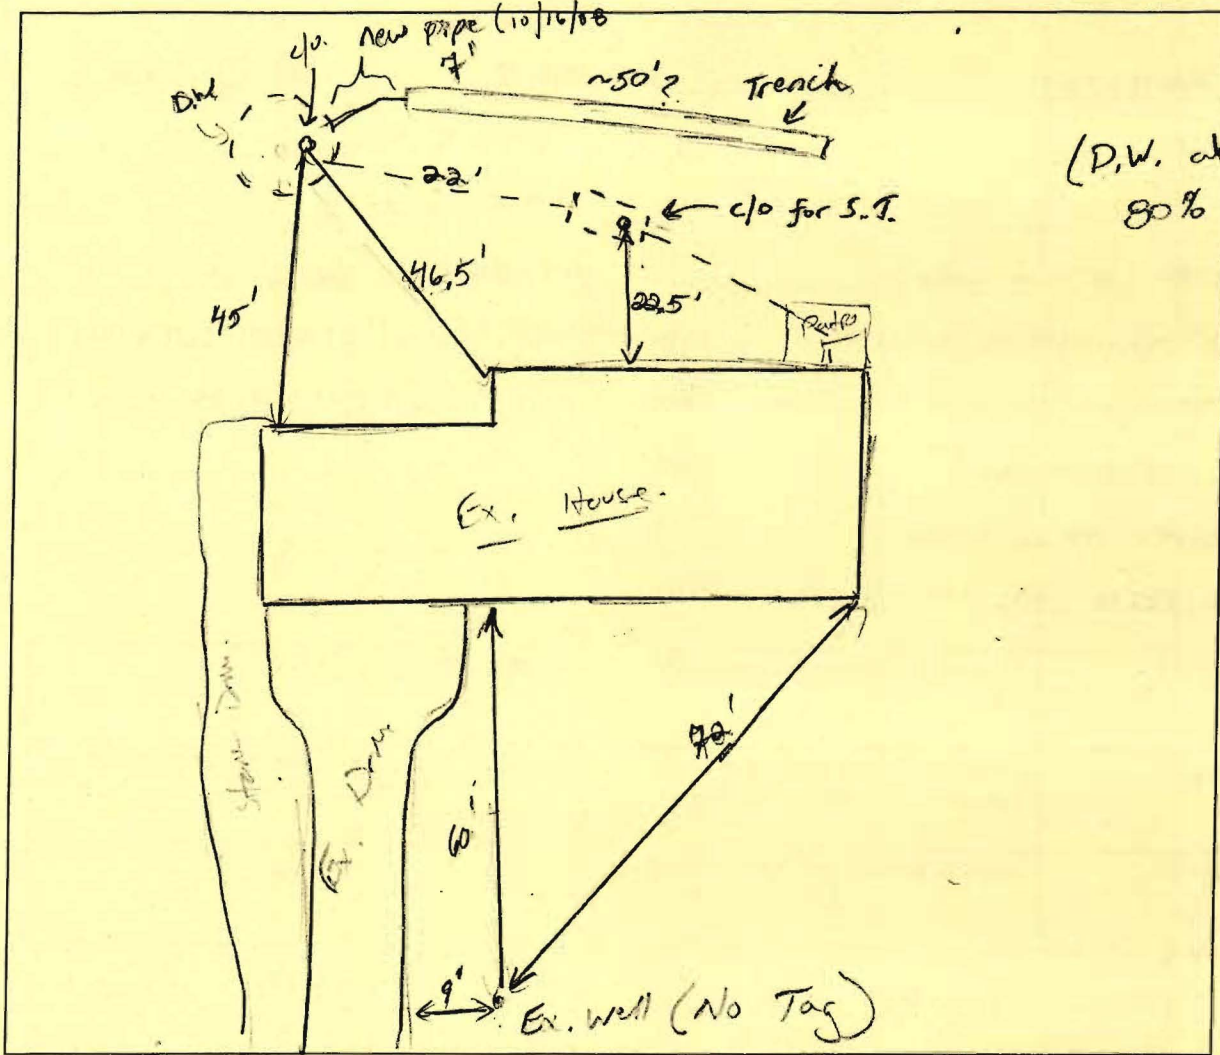

COMMENTS: \_\_\_\_\_  
10/16/08 Contractor Dug up to find that trench coming out of  
D.W. was dry. Line from D.W. to trench clogged. Replaced  
under pressure 3/4" pipe w/ new sch 40 4" pipe  
 DATE: 10/16/08 INSPECTOR: (KW)  
Lowered pipe about an Daynell ~ 2" to increase fall.

SEPTIC SYSTEM REPAIR / UPGRADE / EVALUATION REQUEST

Please fill out this form completely and check off the reason for the request:

Date requested: 10-14-08

*Failing  
System*

Reason for Request

Failing System (includes surface discharge or inadequate treatment zone)

Has the contractor verified through excavation/pumping evaluation, that there are no pipe blockages? \_\_\_\_\_

In support of a building permit. Type of building addition: Residential

\*System relocation for proposed addition for setback compliance \_\_\_\_\_

\*Verification of adequate system capacity per COMAR 26.04.02.02D (4) \_\_\_\_\_

To replace collapsed septic tank or upgrade tank capacity \_\_\_\_\_

To replace collapsed drywell \_\_\_\_\_

\*\*\*\*\*

Septic Contractor: CHARLES BOBCAT SERVICE

Contractor's Address: 13 ENERGETIC ENDAVOR DR  
SYKEVILLE MD 21784

Contractor's Phone #: 410 365 1109

Property Address: 14524 MONTICELLO DR

Property (Subdivision) & Lot # SHAR

Owner's Name: SHARAN FAINA

Is public sewer available/nearby: NO

Names of Any Previous Owners: \_\_\_\_\_

Year House Built: \_\_\_\_\_

# of Existing Bedrooms: \_\_\_\_\_

# of Bedrooms after completion of addition: \_\_\_\_\_

Has this request been discussed previously with a Sanitarian, who? not know

*If public sewer is close, further research will be performed to verify availability and possible hook up to public sewer.*

A Sanitarian will be in contact within three business days depending upon the urgency of the situation to coordinate the scheduling of the repair /upgrade/evaluation. No inspection will be performed without fee collection at the office.

Environmental Sanitarian tentatively assigned \_\_\_\_\_

Howard County Health Department  
Bureau of Environmental Health  
3525-H Ellicott Mills Drive  
Ellicott City, MD 21043

# Memorandum

---

**To:** Carletta McKnight  
**From:** Michael Davis *MD*  
**Date:** 12/22/2008  
**Re:** Refund for 14524 Monticello Drive

---

On October 14, 2008, Charlie's Bobcat Service paid a \$165.00 fee for a percolation testing application preliminary to doing a septic repair. The receipt number was 529595 and a copy of the receipt is attached. Subsequent to paying for the permit, it was determined that the perc was not needed, only a Minor Repair. So a refund was requested. The fee for a minor repair is \$55.00. Please send the refund of \$110.00 (the difference between \$165.00 and \$55.00) to:

Charlie's Bobcat Service  
13 Energetic Drive  
Sykesville, MD 21784

Thank you for your assistance in this matter.