

RECORDED
Liber 714, Folio 338

APPLICATION

A 21499

SEWAGE DISPOSAL TESTING

STATE OF MARYLAND - DEPARTMENT OF HEALTH AND MENTAL HYGIENE

HOWARD COUNTY HEALTH DEPARTMENT
ENVIRONMENTAL HEALTH SERVICES
P. O. BOX 476, ELLICOTT CITY, MARYLAND 21043
TELEPHONE: 465-5000, EXT. 336

DISTRICT 4th

DATE 5/15/75

TO: THE COUNTY HEALTH OFFICER
ELLICOTT CITY, MARYLAND

I, HEREBY, APPLY FOR THE NECESSARY TEST IN ORDER TO CONSTRUCT (OR RECONSTRUCT) A SEWAGE DISPOSAL SYSTEM.

PROPERTY OWNER Thomas G. Oyster

ADDRESS 2419 Reedie Drive, Wheaton, Maryland PHONE 949-2011
933-2454 (Jack Lewis)

PROPERTY LOCATION:

SUBDIVISION (Forsythe Heights) LOT NO. 5B

ROAD AND DESCRIPTION off Monticello Drive

SIZE OF LOT 2.9208 acres TYPE BLDG 3 or 4 bedrooms
NUMBER OF BEDROOMS

IF NOT SINGLE RESIDENCE DESCRIBE _____

THE SYSTEM INSTALLED UNDER THIS APPLICATION IS ACCEPTABLE ONLY UNTIL PUBLIC FACILITIES BECOME AVAILABLE. BLDG. PERMIT SIGNED AND RETURNED 9/15/75

SIGNATURE OF APPLICANT 1st Jack Lewis

APPROVED BY [Signature] FOR Trench + Dry Well DATE 10/29/75
(KIND OF SYSTEM)

REJECTED BY [Signature] FOR Any DATE 6/19/75
(KIND OF SYSTEM)

HOLD PENDING FURTHER TESTS Note. zoning approval location of House DATE

REASONS FOR REJECTION OR HOLDING Rock, clay and water present, a 10,000' area, cannot get gravity flow. House must sit within building restoration line.


Clyde's Chestnut Bessons
923 Antietamwood Dr. 261-7235
Greenbelt, Md. 21054

THIS IS NOT A PERMIT


871-4336

5 B

A 21499

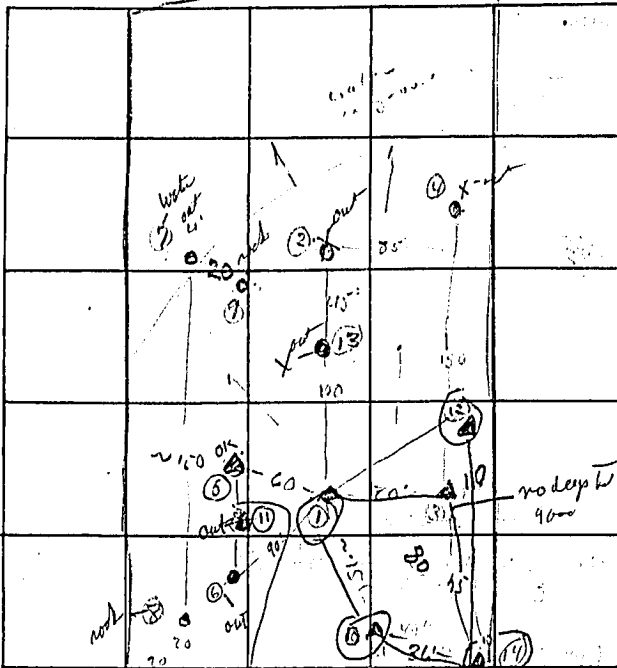

#14542
Monticello Dr.
2.9208 acres

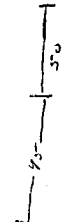

INDICATE NORTH. - NAME ADJOINING ROADWAY AS BASE LINE

Roadway

#3 - 0'
Sandy loam
- 4' clay loam
compact clay loam
- 11' absorbent
- 12' soil.

#4 - 0'
clay
- 9'
clay loam
- 12'

#5 - 0'
loam
- 3'
clay loam
- 1 rock
- 7'
Tissin
Clay loam
- 12'

#10 5' - 25 min.
12' - 7 min.
#11 Rock
#12 4' - 4 min.
12' - 5 min.
#13 Water
#14 4' - 6 min.
4 1/2' - 10 min.
12' - 10 min.

DATE	TEST NO.	DEPTH	PRE-WET START	PRE-WET STOP	TEST - 1" DROP START	TEST - 1" DROP STOP	TIME
8/22/58	1s	4'	10 09	10 15	10 15	10 35	20
"	1d	12'	10 05	10 11	10 11	10 15	4
"	(2s)	6'	10 21	Pull out	no move	no move	X
"	2d	12 1/2'	10 21	10 27	10 30	10 37	X
"	3s	5'	10 46	10 50	10 50	11 02	12
"	(4s)	9'	11 26 11 30	No move	11 27 11 30		X
"	4d	12'	11 06	11 16	11 16	10 37	21
"	1s	7 1/2'	11 55 1 00	12 26 1 30	11 38	2 18	48
"	5s	6'	3 52	3 58	3 55	4 22	21
"	5d	12'	3 30	3 36	3 36	3 43	7

0-4 clay loam
4-6 rocky layer
6-11 light clay loam
12' - moist yellow sandy clay loam

REMARKS: 6 visual hard rocky chert sandstone 4-8' (0.4 clay loam)

TYPE OF SOIL: _____

TESTED BY: D. G. Neill ALSO PRESENT: Lindeman's m.m.