

# APPLICATION

PERCOLATION TESTING

A 46528

P \_\_\_\_\_

HOWARD COUNTY HEALTH DEPARTMENT  
BUREAU OF ENVIRONMENTAL HEALTH  
P.O. BOX 476 ELLICOTT CITY, MARYLAND 21043  
TELEPHONE: 461-9933

DISTRICT 5

DATE 10-25-90

TO: THE COUNTY HEALTH OFFICER  
ELLICOTT CITY, MARYLAND

I, HEREBY, APPLY FOR THE NECESSARY TEST IN ORDER TO CONSTRUCT (OR RECONSTRUCT) A SEWAGE DISPOSAL SYSTEM.

PROPERTY OWNER FRANCIS EHLER Highland Development Corp.

ADDRESS 13782 Brighton Dam Rd PHONE \_\_\_\_\_

PROSPECTIVE BUYER Richard J. Demmitt

ADDRESS Po Box 208 CLARKSVILLE Md 21029 PHONE 531-5539

PROPERTY LOCATION:

SUBDIVISION EHLER The Woods LOT NO. 3

ROAD AND DESCRIPTION Brighton Dam Rd. (13782)

TAX MAP 40 PARCEL # 50

SIZE OF LOT 3 Acres TYPE BLDG. (SINGLE FAMILY DWELLING OR COMMERCIAL)

THE SYSTEM INSTALLED UNDER THIS APPLICATION IS ACCEPTABLE ONLY UNTIL PUBLIC FACILITIES BECOME AVAILABLE. I FULLY UNDERSTAND THE FEE CONNECTED WITH THE FILING OF THIS PERC TEST APPLICATION IS NON-REFUNDABLE UNDER ANY CIRCUMSTANCES. I ALSO AGREE TO COMPLY WITH ALL M.O.S.H.A. REQUIREMENTS IN TESTING THIS LOT.

Richard J. Demmitt  
(SIGNATURE OF APPLICANT)

APPROVED BY B. Hodger FOR TRENCIO DATE 7/17/9

REJECTED BY \_\_\_\_\_ FOR \_\_\_\_\_ DATE \_\_\_\_\_

HOLD PENDING FURTHER TESTS \_\_\_\_\_ DATE \_\_\_\_\_


REASONS FOR REJECTION OR HOLDING 10/29/90 PERC OK HOLD FOR PLAT RH  
7/17/9, RH  
BLDG. PERMIT SIGNED AND RETURNED 7/17/9  
3 Bedroom Serial # 38544

HD-216

# THIS IS NOT A PERMIT

Lot 6  
A 46 528

(B)  
SOIL PROFILE

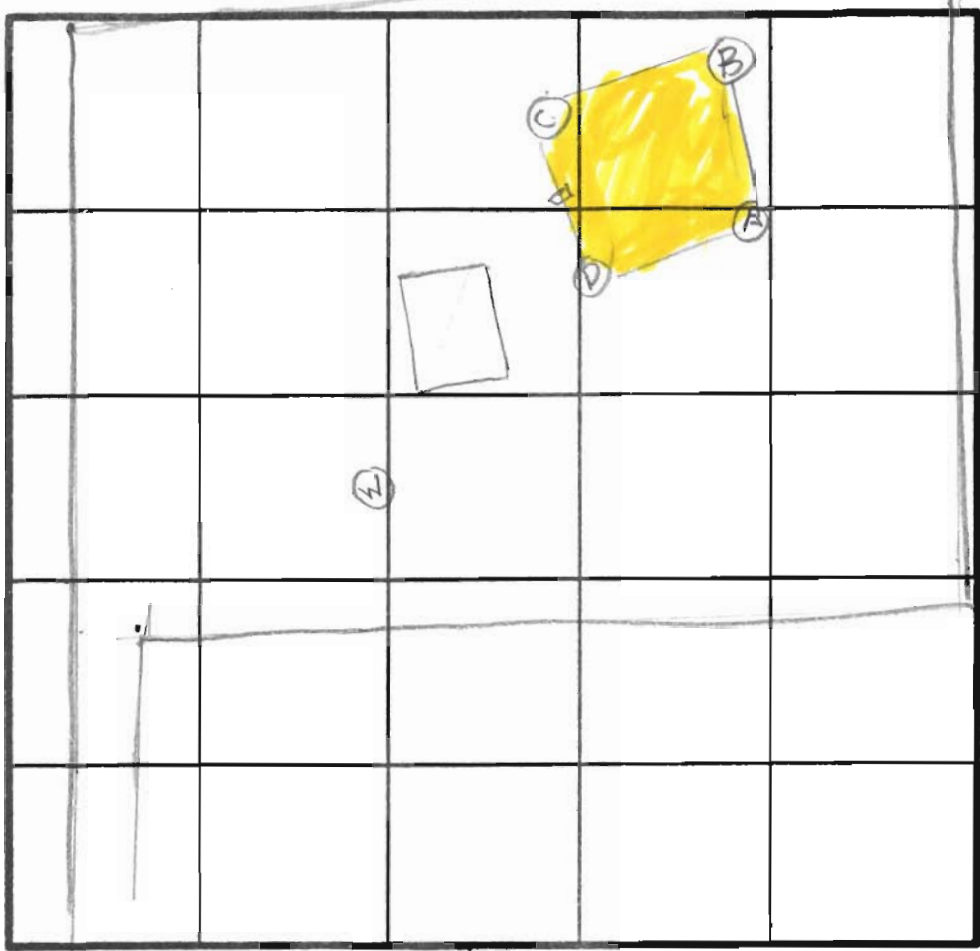

INDICATE NORTH - NAME ADJOINING ROADWAY AS BASE LINE.

~~Lot 2-22~~

INLET 3 FT  
BOTTOM 5 FT

14

(A)




2 FT 7 STONE

DATE	TEST NO.	DEPTH	PRE-WET		TEST - 1' DROP		TIME
			START	STOP	START	STOP	
10/26/90	B <sup>S</sup>	3.5	1255	1257	1257	101	4
	B <sup>V</sup>	14	OK				
	A <sup>S</sup>	3.5	1259	102	102	110	8
	A <sup>V</sup>	13.5	OK				
	C <sup>S</sup>	3	100	108	108	110	2
	S <sup>V</sup>	11.5	OK				
	D <sup>S</sup>	3	113	115	115	117	2
	D <sup>D</sup>	6	113	115	115	117	2
	D <sup>V</sup>	13	OK				

13.5

(C)

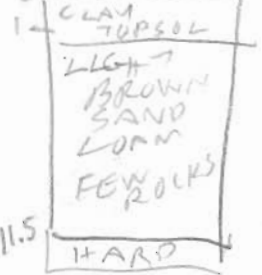

(D)



REMARKS: Holes Dug Per Test Plat #2

TYPE OF SOIL \_\_\_\_\_

TESTED BY: RHODGERS ALSO PRESENT: R DEMITT

13