


NOTE:
The existing wells shown on this plan H0 04-3774 have been field located by Fisher Collins & Carter, Inc. professional land surveyors and are accurately shown.

NO.	REVISION	DATE
10	Rev. hse. 4 qrd. Lot 7, from Clifton Pk. to Monticello	11-4-04
12	Add side conserv. to hse on Lot 9	8-12-08
11	Add well note & label ex. contours per H0 04-3774	8-23-04
9	Rev. hse 4 qrd. Lot 10 to add side conserv.	7-20-04
10	Rev. hse 4 qrd. to Leeburg, Lot 10 / add bay wind Lot 8	7-23-04
8	Lot 9 Delete Cons. Add 8' Arway	7-7-04
7	Rev. Septic Area Lot 6	7-7-04
6	Add well numbers & culvert pipes lots 6-10, add note	6-17-04
5	Rev. hse type lot 6 from Clifton Pk to Hyde Pk	6-17-04
4	Show well loc. on Lot 6	5-3-04
3	Rev. hse 4 qrd. Lot 11 to add 2 car garage	5/6/04
2	Rev. hse & 600 LOT 6 FROM MONTICELLO TO CLIFTON PARK	5/3/04
1	REV. HSE. & 600 LOT 6 FROM MONTICELLO TO CLIFTON PARK	5/3/04

ENGINEER'S CERTIFICATE
I certify that this plan for erosion and sediment control represents a practical and workable plan based on my personal knowledge of the site conditions and that it was prepared in accordance with the requirements of the Howard Soil Conservation District.
Signature of Engineer: *Earl D. Collins* Date: 4/1/04

DEVELOPER'S CERTIFICATE
I/We certify that all development and construction will be done according to this plan, for sediment and erosion control and that any responsible personnel involved in the construction project will have a Certificate of Attendance at a Department of the Environment Approved Training Program for the Control of Sediment and Erosion before beginning the project. I also authorize periodic on-site inspection by the Howard Soil Conservation District.
Signature of Developer: *Tom Garner* Date: 4/5/04

Reviewed for HOWARD SCD and meets Technical Requirements.
John M. Garner 4/7/04
Signature of Howard SCD: *John M. Garner* 4/7/04

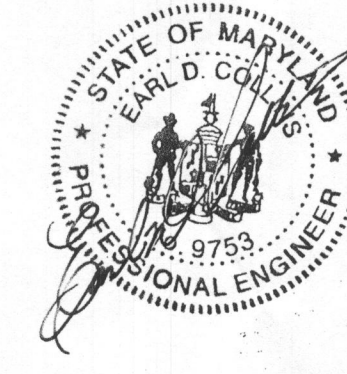

OWNER/DEVELOPER
ELLICOTT CITY LAND HOLDING CO., LLC.
8000 MAIN STREET
ELLICOTT CITY, MARYLAND 21043
410-480-0367

BUILDER
NV-HOMES
6085 MARSHALLEE DRIVE
SUITE 130
ELK RIDGE, MARYLAND 21075
410-379-5656

SITE & SEDIMENT/EROSION CONTROL PLAN
SINGLE FAMILY DETACHED
HALL SHOP MANOR
LOTS 1 THRU 12 & BUILDABLE PRESERVATION PARCEL 'A'
TAX MAP No: 41 PARCEL No: 138 GRID No.: 1
FIFTH ELECTION DISTRICT, HOWARD COUNTY, MARYLAND
SCALE: 1" = 50' DATE: MARCH, 2003
SHEET 2 OF 3

G.P. 04-73