

C1 15948

SEQUENCE NO. (MDE USE ONLY)

STATE OF MARYLAND WELL COMPLETION REPORT

THIS REPORT MUST BE SUBMITTED WITHIN 45 DAYS AFTER WELL IS COMPLETED.

1 2 3 6 (THIS NUMBER IS TO BE PUNCHED IN COLS. 3-6 ON ALL CARDS)

COUNTY NUMBER A 514619

ST/CO USE ONLY DATE RECEIVED MM DD YY

DATE WELL COMPLETED MM DD YY 4 7 08

Depth of Well 22 400 26 (TO NEAREST FOOT)

OK [Signature]

PERMIT NO. FROM "PERMIT TO DRILL WELL" 140-95-1604

OWNER Preserve At Waverly Glen LLC STREET OR RFD Mount DeWalt Dr. TOWN Woodstock SUBDIVISION The Preserve At Waverly Glen SECTION LOT 18

WELL LOG table with columns: DESCRIPTION, FEET (FROM, TO), check if water bearing. Includes entries: Brown Mico (0-30), Gray Stone (30-400), Hit water (320-325).

GROUTING RECORD form with fields: WELL HAS BEEN GROUTED (Y), TYPE OF GROUTING MATERIAL (CM, BC), NO. OF BAGS (9), NO. OF POUNDS (416), GALLONS OF WATER (117), DEPTH OF GROUT SEAL (41).

CASING RECORD form with fields: MAIN CASING TYPE (PL), Nominal diameter (6), Total depth (41).

OTHER CASING (if used) form with fields: diameter, depth.

SCREEN RECORD form with fields: screen type (HO), diameter (56), depth (60).

NUMBER OF UNSUCCESSFUL WELLS: 0

WELL HYDROFRACTURED (Y) CIRCLE APPROPRIATE LETTER (A, E, P)

I HEREBY CERTIFY THAT THIS WELL HAS BEEN CONSTRUCTED IN ACCORDANCE WITH COMAR 26.04.04 "WELL CONSTRUCTION" AND IN CONFORMANCE WITH ALL CONDITIONS STATED IN THE ABOVE CAPTIONED PERMIT...

DRILLERS LIC. NO. 1 M SD 167 DRILLERS SIGNATURE (Must match signature on application) LIC. NO. 1 D

SITE SUPERVISOR (sign. of driller or journeyman responsible for sitework if different from permittee)


DEPTH (nearest ft.) 42 400 CASING HEIGHT (+) above, (-) below LAND SURFACE (nearest foot)

GRAVEL PACK IF WELL DRILLED WAS FLOWING WELL INSERT F IN BOX 68

MDE USE ONLY (NOT TO BE FILLED IN BY DRILLER) T (E.R.O.S.) W Q TELESCOPE CASING LOG INDICATOR OTHER DATA

PUMPING TEST form with fields: HOURS PUMPED (3), PUMPING RATE (20), METHOD USED TO MEASURE PUMPING RATE (Submersible), WATER LEVEL (41), BEFORE PUMPING (17), WHEN PUMPING (113.2).

PUMP INSTALLED form with fields: DRILLER INSTALLED PUMP (NO), TYPE OF PUMP INSTALLED (S), CAPACITY: GALLONS PER MINUTE (31), PUMP HORSE POWER (37), PUMP COLUMN LENGTH (43).

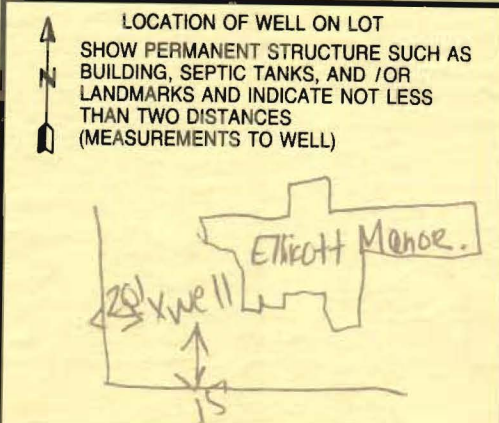

B 1 0817  
1 2 3 6  
SEQUENCE NO. (MDE USE ONLY)


STATE OF MARYLAND  
APPLICATION FOR PERMIT TO DRILL WELL  
5 2 8 8 8 2 please type

STATE PERMIT NUMBER  
110 - 95 - 1604  
70 fill in this form completely 79

Date Received (APA)  
8 MM DD YY 13  
OWNER INFORMATION  
15 Last Name Owner First Name 34  
36 Street or RFD 55  
57 Town 70 State 72 Zip 76  
PRESERVE AT WAVERLY GLEN LLC  
3675 PARK AVE  
ELLICOTT CITY MD, 21043

B 3 LOCATION OF WELL  
8 COUNTY 21  
23 SUBDIVISION 42  
SECTION 44 46 LOT 48 50  
52 NEAREST TOWN 71  
MILES FROM TOWN (enter 0 if in town) 73 M I 76 77 78  
Howard  
The Preserve at Waverly Glen  
18  
WOOD STOCK  
I

DRILLER INFORMATION  
61 Driller's Name 76 License No. 81  
64 Firm Name  
67 Address  
70 Signature 76 Date  
RALPH E WAYNE M SD 117  
RALPH E. WAYNE INC  
17024 Handy Rd Mt Airy MD, 21771  
R E Wayne 4/4/08

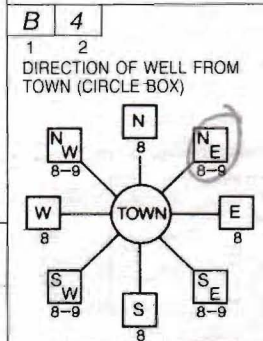

B 4  
1 2 DIRECTION OF WELL FROM TOWN (CIRCLE BOX)  
11 NEAR WHAT ROAD 30  
ON WHICH SIDE OF ROAD (CIRCLE APPROPRIATE BOX)  
34 230 37 DISTANCE FROM ROAD  
ENTER FT OR MI 38 39  
TAX MAP: 10 BLK: 23 PARCEL 304  
Mount Denali Dr  
NORTH  
WEST 32 EAST  
SOUTH


B 2 WELL INFORMATION  
1 2 APPROX. PUMPING RATE (GAL. PER MIN.) 8 12  
AVERAGE DAILY QUANTITY NEEDED (GAL. PER DAY) 14 20  
5  
500

USE FOR WATER (CIRCLE APPROPRIATE BOX)  
22  
 DOMESTIC POTABLE SUPPLY & RESIDENTIAL IRRIGATION  
 FARMING (LIVESTOCK WATERING & AGRICULTURAL IRRIGATION)  
 INDUSTRIAL, COMMERCIAL, DEWATERING  
 PUBLIC WATER SUPPLY WELL  
 TEST, OBSERVATION, MONITORING  
 GEO-THERMAL

NOT TO BE FILLED IN BY DRILLER HEALTH DEPARTMENT APPROVAL  
Howard 1514619  
COUNTY NAME COUNTY NO.  
STATE SIGNATURE INSERT S → 41  
DATE ISSUED 4/4/08 4/4/09  
43 MM DD YY 48 CO SIGNATURE EXP. DATE  
NORTH GRID 50 542 000 55 EAST GRID 57 832 000 63

APPROXIMATE DEPTH OF WELL 24 28 FEET  
APPROXIMATE DIAMETER OF WELL NEAREST INCH  
64  
new well site

SHOW MAJOR FEATURES OF BOX & LOCATE WELL WITH AN X  
SOURCES OF DRILLING WATER  
1. well  
2.  
3.  
WRITE THE BOX NUMBER FROM THE MAP HERE  
E 832  
N 542  
000  
000

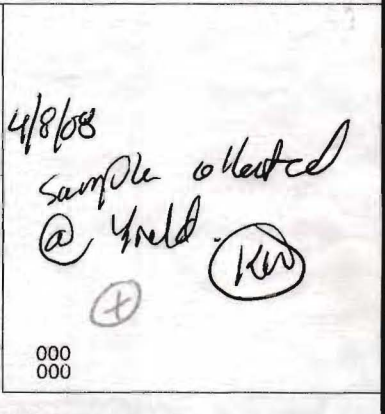

METHOD OF DRILLING (circle one)  
30 BORED (or Augered) JETTED Jetted & DRIVEN  
37 AIR-ROTary AIR-PERcussion ROTARY (Hydraulic Rotary)  
CABLE REVERSE-ROTary DRIVE-POINT  
other

REPLACEMENT OR DEEPEINED WELLS (CIRCLE APPROPRIATE BOX)  
39  
 THIS WELL WILL NOT REPLACE AN EXISTING WELL  
 THIS WELL WILL REPLACE A WELL THAT WILL BE ABANDONED AND SEALED  
 THIS WELL WILL REPLACE A WELL THAT WILL BE USED AS A STANDBY-CONTACT LOCAL APPROVING AUTHORITY FOR POLICY ON STANDBY WELLS  
 THIS WELL WILL DEEPEIN AN EXISTING WELL  
PERMIT NUMBER OF WELL TO BE REPLACED OR DEEPEINED (IF AVAILABLE) 41 52

Not to be filled in by driller (MDE OR COUNTY USE ONLY)  
APPROP. PERMIT NUMBER 110 2003 G 00514  
PERMIT No. 110 - 95 - 1604  
70 71 72 73 74 75 76 77 78 79

SPECIAL CONDITIONS  
NOTE - APPROVING AUTHORITIES SHOULD USE SEPARATE SHEET IF NEEDED - well must be tested for Radium



Date

Signature

LOT 18  
57,987 SF  
1.33 AC

REVISED  
S.D.A.  
100,773 SF

SEPTIC TANK  
EX. GROUND=427.5  
INV. IN=426.50  
INV. OUT=426.20

PUMP CHAMBER  
EX. GROUND=428.00  
INV. IN=425.50  
INV. OUT=425.20

EX. GROUND  
ELEVATION=434.1  
INV. INTO D.B.  
BOX=431.1

ELLICOTT MANOR  
FF: 435.00  
BF: 425.00

SF: 3800 SF  
FF: 4300 SF  
BF: 4200 SF

FIRST FLOOR GRAVITY SERVICE  
BASEMENT EJECTOR PUMP

LOT 17  
51,387 SF  
1.18 AC

PROP. SEPTIC  
11,348 SF

Handwritten notes:  
Need meet  
well site  
OK  
4/16/14

