

C1 4580

SEQUENCE NO. (DENV USE ONLY)

STATE OF MARYLAND WELL COMPLETION REPORT

THIS REPORT MUST BE SUBMITTED WITHIN 45 DAYS AFTER WELL IS COMPLETED.

(THIS NUMBER IS TO BE PUNCHED IN COLS. 3-6 ON ALL CARDS)

COUNTY NUMBER A 46528

ST/CO USE ONLY DATE Received

DATE WELL COMPLETED

Depth of Well

PERMIT NO. FROM "PERMIT TO DRILL WELL"

8 13

15 20

22 26

28 37

OWNER Demmitt Richard first name Brighton Dam Rd second name TOWN Clarksville

STREET OR RFD THE WOODS SUBDIVISION SECTION LOT 3

WELL LOG Not required for driven wells STATE THE KIND OF FORMATIONS PENETRATED, THEIR COLOR, DEPTH, THICKNESS AND IF WATER BEARING

Table with columns: DESCRIPTION, FEET (FROM, TO), Check if water bearing. Includes handwritten entries: SAND stone, GPRY Mica ROCK.

GROUTING RECORD WELL HAS BEEN GROUTED (Circle Appropriate Box) TYPE OF GROUTING MATERIAL

CEMENT CM BENTONITE CLAY BC NO. OF BAGS NO. OF POUNDS GALLONS OF WATER DEPTH OF GROUT SEAL

CASING RECORD casing types insert appropriate code below STEEL CONCRETE PLASTIC OTHER

MAIN CASING TYPE Nominal diameter top (main) casing of main casing Total depth of main casing

OTHER CASING (if used) diameter inch depth (feet) from to

SCREEN RECORD screen type or open hole insert appropriate code below STEEL BRASS BRONZE OPEN HOLE PLASTIC OTHER

Table for SCREEN RECORD with columns for DEPTH (nearest ft.) and rows for EACH CASING.

CIRCLE APPROPRIATE LETTER A A WELL WAS ABANDONED AND SEALED WHEN THIS WELL WAS COMPLETED E ELECTRIC LOG OBTAINED P TEST WELL CONVERTED TO PRODUCTION WELL

I HEREBY CERTIFY THAT THIS WELL HAS BEEN CONSTRUCTED IN ACCORDANCE WITH COMAR 26.04.04 "WELL CONSTRUCTION" AND IN CONFORMANCE WITH ALL CONDITIONS STATED IN THE ABOVE CAPTIONED PERMIT...

DRILLERS IDENT. NO. 238

DRILLERS SIGNATURE (MUST MATCH SIGNATURE ON APPLICATION)

SITE SUPERVISOR (sign. of driller or journeyman responsible for sitework if different from permittee)

SLOT SIZE 1 2 3 DIAMETER OF SCREEN (NEAREST INCH) from to

GRAVEL PACK IF WELL DRILLED WAS FLOWING WELL INSERT F IN BOX 68

OEP USE ONLY (NOT TO BE FILLED IN BY DRILLER) T (E.R.O.S.) W Q TELESCOPE CASING LOG INDICATOR OTHER DATA

C3

PUMPING TEST HOURS PUMPED (nearest hour)

PUMPING RATE (gal. per min. to nearest gal.) METHOD USED TO MEASURE PUMPING RATE Bucket

WATER LEVEL (distance from land surface) BEFORE PUMPING WHEN PUMPING


TYPE OF PUMP USED (for test) A air P piston T turbine C centrifugal R rotary O other (describe below) J jet S submersible

PUMP INSTALLED DRILLER WILL INSTALL PUMP YES NO IF DRILLER INSTALLS PUMP, THIS SECTION MUST BE COMPLETED FOR ALL WELLS EXCEPT HOME USE TYPE OF PUMP INSTALLED PLACE (A,C,J,P,R,S,T,O) IN BOX - SEE ABOVE:

CAPACITY: GALLONS PER MINUTE (to nearest gallon) PUMP HORSE POWER PUMP COLUMN LENGTH (nearest ft.) CASING HEIGHT (circle appropriate box and enter casing height)

LAND SURFACE (nearest foot)

LOCATION OF WELL ON LOT SHOW PERMANENT STRUCTURE SUCH AS BUILDING, SEPTIC TANKS, AND/OR LANDMARKS AND INDICATE NOT LESS THAN TWO DISTANCES (MEASUREMENTS TO WELL)

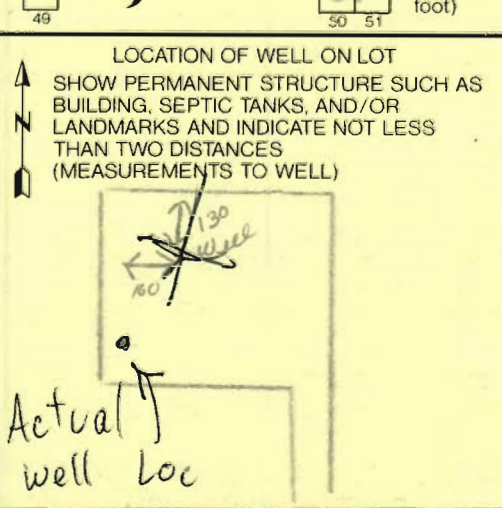

0068

SEQUENCE NO. (DP USE ONLY)

STATE OF MARYLAND APPLICATION FOR PERMIT TO DRILL WELL

STATE PERMIT

NUMBER IS TO BE PUNCHED (OLS. 3-6 ON ALL CARDS)

40-88-1910 fill in this form completely

please print or type

Permit Received (APA)

B 3

LOCATION OF WELL

OWNER INFORMATION: 150891, DEWITT RICHARD, 10 BOX 208, CLARKSVILLE MD 21029


LOCATION OF WELL: HOWARD COUNTY, THE WOODS SUBDIVISION, SECTION 44, LOT 3, CLARKSVILLE, 3 1/2 MILES FROM TOWN

DRILLER INFORMATION

DRILLER INFORMATION: Joseph E. Mague, License No. 238, Firm Name: Joseph E. Mague Well Drilling, Address: 5512 Ridge Rd. Mt. Airy, Md. 21771, Date: 5/6/91

B 4

DIRECTION OF WELL FROM TOWN (CIRCLE BOX)

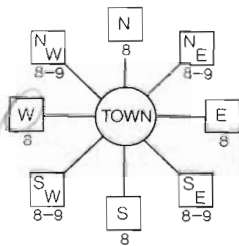

NEAR WHAT ROAD: Brighton Dam Road, ON WHICH SIDE OF ROAD: EAST, DISTANCE FROM ROAD: 800 FT

WELL INFORMATION

APPROX. PUMPING RATE (GAL. PER MIN.): 5, AVERAGE DAILY QUANTITY NEEDED (GAL. PER DAY): 5000

USE FOR WATER (CIRCLE APPROPRIATE BOX)

- HOME (SINGLE OR DOUBLE HOUSEHOLD UNIT ONLY) [X], FARMING, INDUSTRIAL, COMMERCIAL, STATE AND FEDERAL GOV. OTHER, PUBLIC OR PRIVATE WATER COMPANY, APPROPRIATION PERMIT AND STATE HEALTH DEPARTMENT APPROVAL, TEST, OBSERVATION, MONITORING

NOT TO BE FILLED IN BY DRILLER HEALTH DEPARTMENT APPROVAL

HOWARD COUNTY NAME, A46528 COUNTY NO., STATE SIGNATURE: Mark E. Ripkin 12/5/91, DATE ISSUED: 060591, NORTH GRID: 497000, EAST GRID: 0802000

APPROXIMATE DEPTH OF WELL: 249 FEET

APPROXIMATE DIAMETER OF WELL: 6 INCH NEAREST

METHOD OF DRILLING (circle one)

BORED (or Augered) [X], JETTED, Jetted & DRIVEN, AIR-ROTary, AIR-PERcussion, ROTARY (Hydraulic Rotary), CABLE, REVerse-ROTary, DRive-POINT, other

REPLACEMENT OR DEEPEINED WELLS

(CIRCLE APPROPRIATE BOX)

- N THIS WELL WILL NOT REPLACE AN EXISTING WELL [X], Y THIS WELL WILL REPLACE A WELL THAT WILL BE ABANDONED AND SEALED, S THIS WELL WILL REPLACE A WELL THAT WILL BE USED AS A STANDBY, D THIS WELL WILL DEEPEN AN EXISTING WELL

PERMIT NUMBER OF WELL TO BE REPLACED OR DEEPEINED (IF AVAILABLE):

Not to be filled in by driller (OEP USE ONLY)


APPROX. PERMIT NUMBER: GAP

FORCE: M17, PERMIT No.: 40-88-1910

SHOW MAJOR FEATURES OF BOX & LOCATE WELL WITH AN X


SOURCES OF DRILLING WATER


WRITE THE BOX NUMBER FROM THE MAP HERE

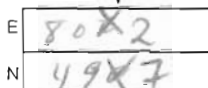

DRAW A SKETCH BELOW SHOWING LOCATION OF WELL IN RELATION TO NEARBY TOWNS AND ROADS AND GIVE DISTANCE FROM WELL TO NEAREST ROAD JUNCTION

N

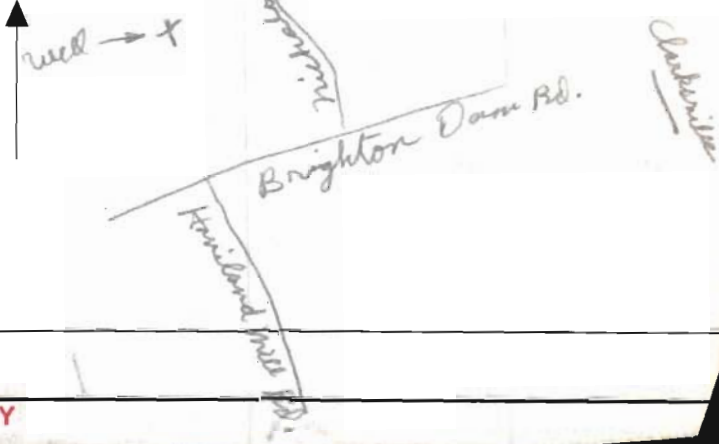

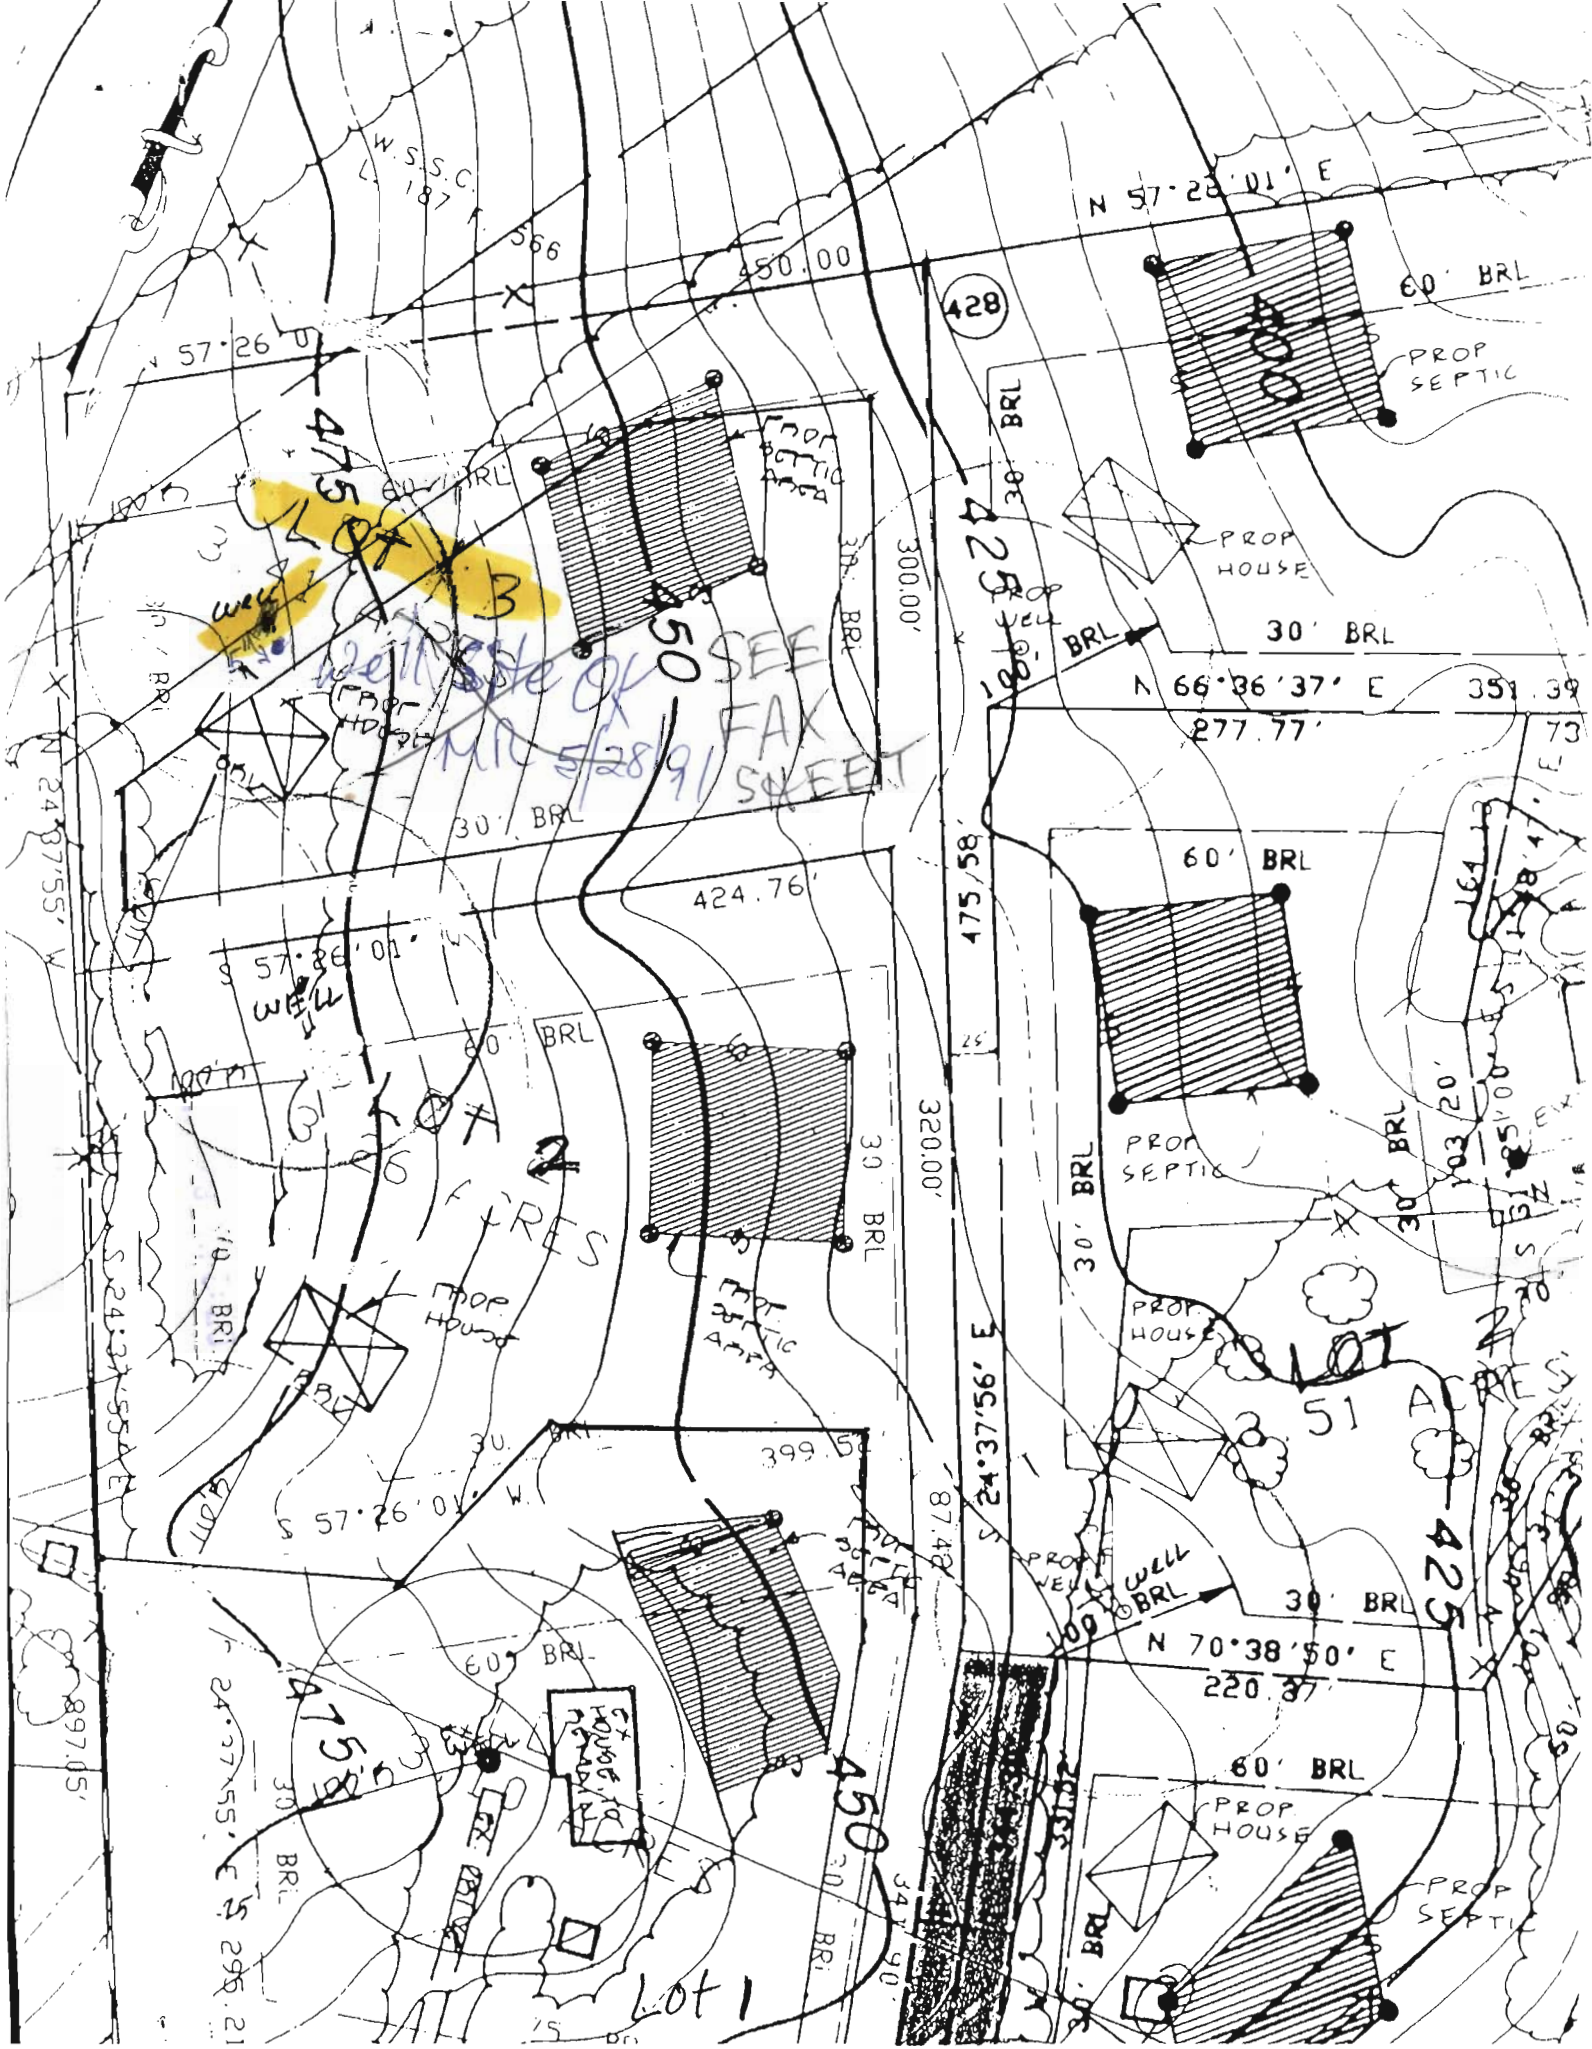

475
WELL

SEE FAX
MIC 5/28/91 SHEET

475
WELL

LOT 1

LOT 51

425

428

N 57°28'01" E

57°26'

450.00

60' BRL

PROP SEPTIC

PROP HOUSE

30' BRL

N 66°36'37" E

351.39

277.77'

424.76'

60' BRL

PROP SEPTIC

PROP HOUSE

LOT 51

PROP HOUSE

PROP SEPTIC

PROP WELL

PROP HOUSE

N 70°38'50" E

220.37'

60' BRL

PROP HOUSE

PROP SEPTIC

897.05'

24°37'55" E

295.21

320.00'

S 24°37'56" E

87.42'

450

30' BRL

34' 90"

30' BRL

30' BRL

30' BRL

425

100' BRL

300.00'

175.58'

25'

320.00'

25'

320.00'

25'

164.13

103.20'

105.00'

103.20'

105.00'

