

12/4/73

app 12-4-73  
18999

# PERMIT

SEWAGE DISPOSAL SYSTEM

A 18601

MARYLAND STATE DEPARTMENT OF HEALTH

HOWARD COUNTY

ELLICOTT CITY

DISTRICT 3

DATE 9/18/73

INDEXED

Louis Hackett

IS PERMITTED TO INSTALL  ALTER

ADDRESS Old Rover Road, Glenelg, Md.

PHONE 489-4847

A SEWAGE DISPOSAL SYSTEM LOCATED AT

SUBDIVISION

ROAD 13754 Old Rover Road

LOT

PROPERTY OWNER

~~same as above~~

Robert D. Foreman  
nr. Pfeifferkorn Road

ADDRESS

SPECIFICATIONS - 3 bedrooms

DRAIN FIELD \_\_\_\_\_ DEPTH \_\_\_\_\_ FEET, BOTTOM AREA \_\_\_\_\_ SQ. FT.

SEEPAGE PITS \_\_\_\_\_ ABSORBENT SIDE-WALL AREA \_\_\_\_\_ SQ. FT.

SEPTIC TANK CAPACITY 1,000 GALLONS

FOR GARBAGE GRINDER, INCREASE DISPOSAL AREA 22% & TANK CAPACITY 50%

OTHER Dry well - 360 sq. ft. absorbent sidewall area to begin below the first 34 ft. of original grade. Max. depth permitted for dry well is 12 ft. below original grade.

Place dry well 142 ft. from front lot line and 25 ft. from right side line as seen when facing lot from Old Rover Road

NOTE: ALL PIPE FROM HOUSE TO DRY WELL MUST BE CAST IRON.

PERMIT VOID AFTER THREE YEARS.

NOTE: INSTALL STAND PIPE ON SEPTIC TANK AND DRY WELL.

PLANS APPROVED BY D. W. Monaghan


DATE 7/20/73

FILL SEPTIC TANK AND DISTRIBUTION BOX WITH WATER BEFORE CALLING FOR AN INSPECTION. COVER NO WORK UNTIL INSPECTED AND APPROVED.

NEITHER THE HOWARD COUNTY COMMISSIONERS NOR THE HEALTH DEPARTMENT IS RESPONSIBLE FOR THE SUCCESSFUL OPERATION OF ANY SYSTEM.

BOG. PERMIT SIGNED  
AND RETURNED 9/11/73  
Serial # 34577  
J. C. G. Mason

A 18601

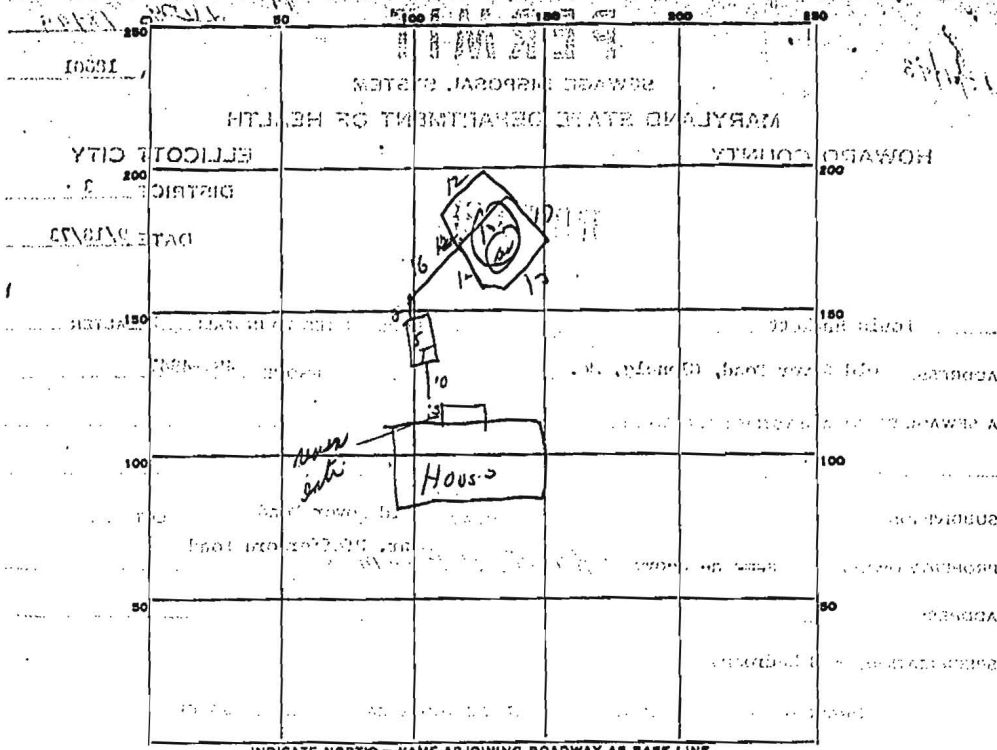

INDICATE NORTH - NAME ADJOINING ROADWAY AS BASE LINE.

*Old Pine Rd*

PERMIT CARD OK

SEPTIC TANK, LEVEL OK CLEANOUTS OK

DISTRIBUTION BOX, LEVEL \_\_\_\_\_

TILE FIELD: DEPTH \_\_\_\_\_ FT. TRENCH: WIDTH \_\_\_\_\_ FT.

GRAVEL DEPTH \_\_\_\_\_ IN. TOTAL LENGTH \_\_\_\_\_ FT.

NUMBER OF TRENCHES \_\_\_\_\_ TOTAL BOTTOM AREA \_\_\_\_\_

SEEPAGE PITS, INSIDE DIAMETER Reamed 50 FT. DEPTH BELOW INLET 7 FT.

ABSORBENT AREA 2550 SQ. FT.

REMARKS: \_\_\_\_\_

\_\_\_\_\_

\_\_\_\_\_

\_\_\_\_\_

DATE SYSTEM APPROVED 12/4/73 INSPECTOR J.W. Monaghan