

# APPLICATION

18601

SEWAGE DISPOSAL TESTING  
STATE OF MARYLAND - DEPARTMENT OF HEALTH AND MENTAL HYGIENE  
HOWARD COUNTY HEALTH DEPARTMENT  
ENVIRONMENTAL HEALTH SERVICES  
P. O. BOX 476, ELLICOTT CITY, MARYLAND 21043  
TELEPHONE: 463-8000, EXT. 356

P. \_\_\_\_\_  
DISTRICT 3rd  
DATE 6/18/73

TO: THE COUNTY HEALTH OFFICER  
ELLICOTT CITY, MARYLAND

I, HEREBY, APPLY FOR THE NECESSARY TEST IN ORDER TO CONSTRUCT (OR RECONSTRUCT) A SEWAGE DISPOSAL SYSTEM.

PROPERTY OWNER Louis S. Hackett

ADDRESS Old Rover Road, Glenelg, Md. PHONE 489-4847

PROPERTY LOCATION:

SUBDIVISION \_\_\_\_\_ LOT NO. Parcel B

ROAD AND DESCRIPTION Old Rover Road

SIZE OF LOT 0.994 acres TYPE BLDG. 3 bedrooms  
NUMBER OF BEDROOMS

IF NOT SINGLE RESIDENCE DESCRIBE \_\_\_\_\_

THE SYSTEM INSTALLED UNDER THIS APPLICATION IS ACCEPTABLE ONLY UNTIL PUBLIC FACILITIES BECOME AVAILABLE.

SIGNATURE OF APPLICANT Louis S. Hackett

APPROVED BY \_\_\_\_\_ FOR \_\_\_\_\_ DATE \_\_\_\_\_  
(KIND OF SYSTEM)


REJECTED BY \_\_\_\_\_ FOR \_\_\_\_\_ DATE \_\_\_\_\_  
(KIND OF SYSTEM)

HOLD PENDING FURTHER TESTS \_\_\_\_\_ DATE \_\_\_\_\_

REASONS FOR REJECTION OR HOLDING \_\_\_\_\_  
\_\_\_\_\_  
\_\_\_\_\_

## THIS IS NOT A PERMIT

# APPLICATION

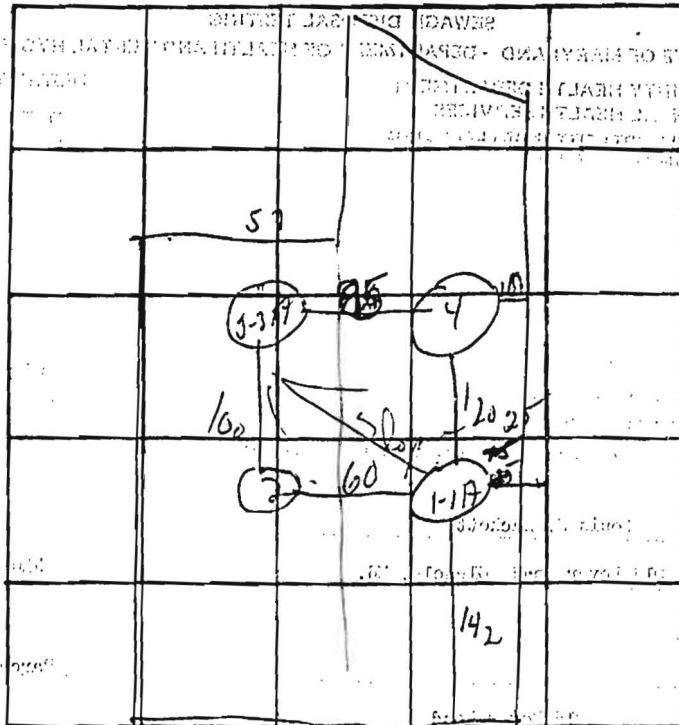

INDICATE NORTH, & NAME ADJOINING ROADWAY AS BASE LINE.


*Old River Rd.*

DATE	TEST NO.	DEPTH	PRE-WET		TEST - 1" DROP		TIME
			START	STOP	START	STOP	
7/18/70	1	12'	10 03	10 05	10 05	10 13	8m
	1A	3'	10 03	10 06	10 06	10 20	1/2
	2	10'	good soil				
	3	15'	10 13	10 15	10 15	10 24	9m
	3A	4'	10 13	10 16	10 16	10 27	11m
	4	12'					

REMARKS 1-1A-high - 3-3A low


TYPE OF SOIL \_\_\_\_\_

ROBERT FOREMAN

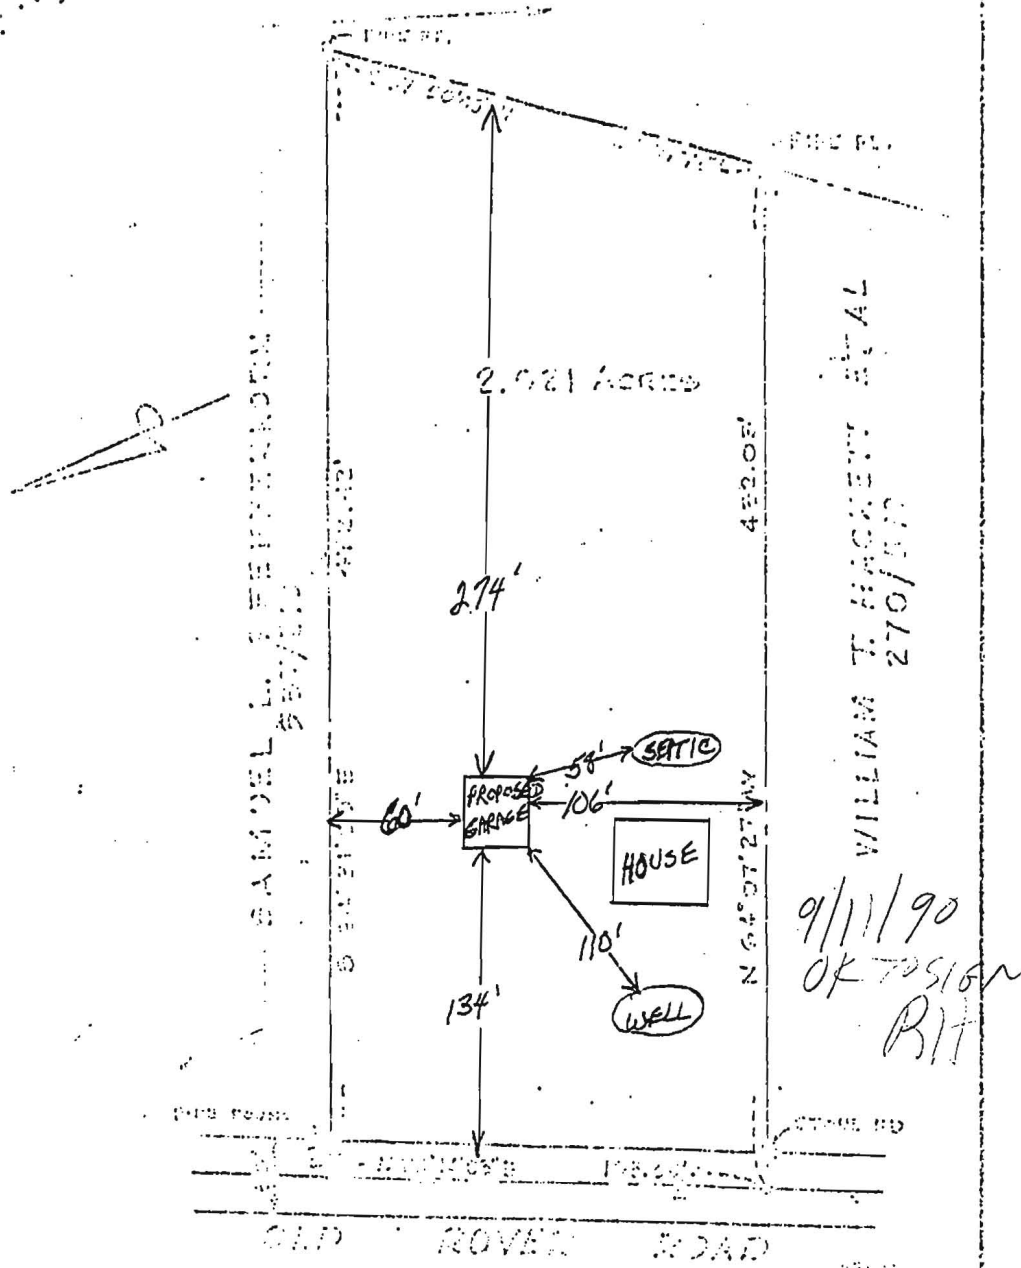

9/11/90  
OK DESIGN  
RIT

The lot shown herein is subject to all  
rights of way, easements, and other interests

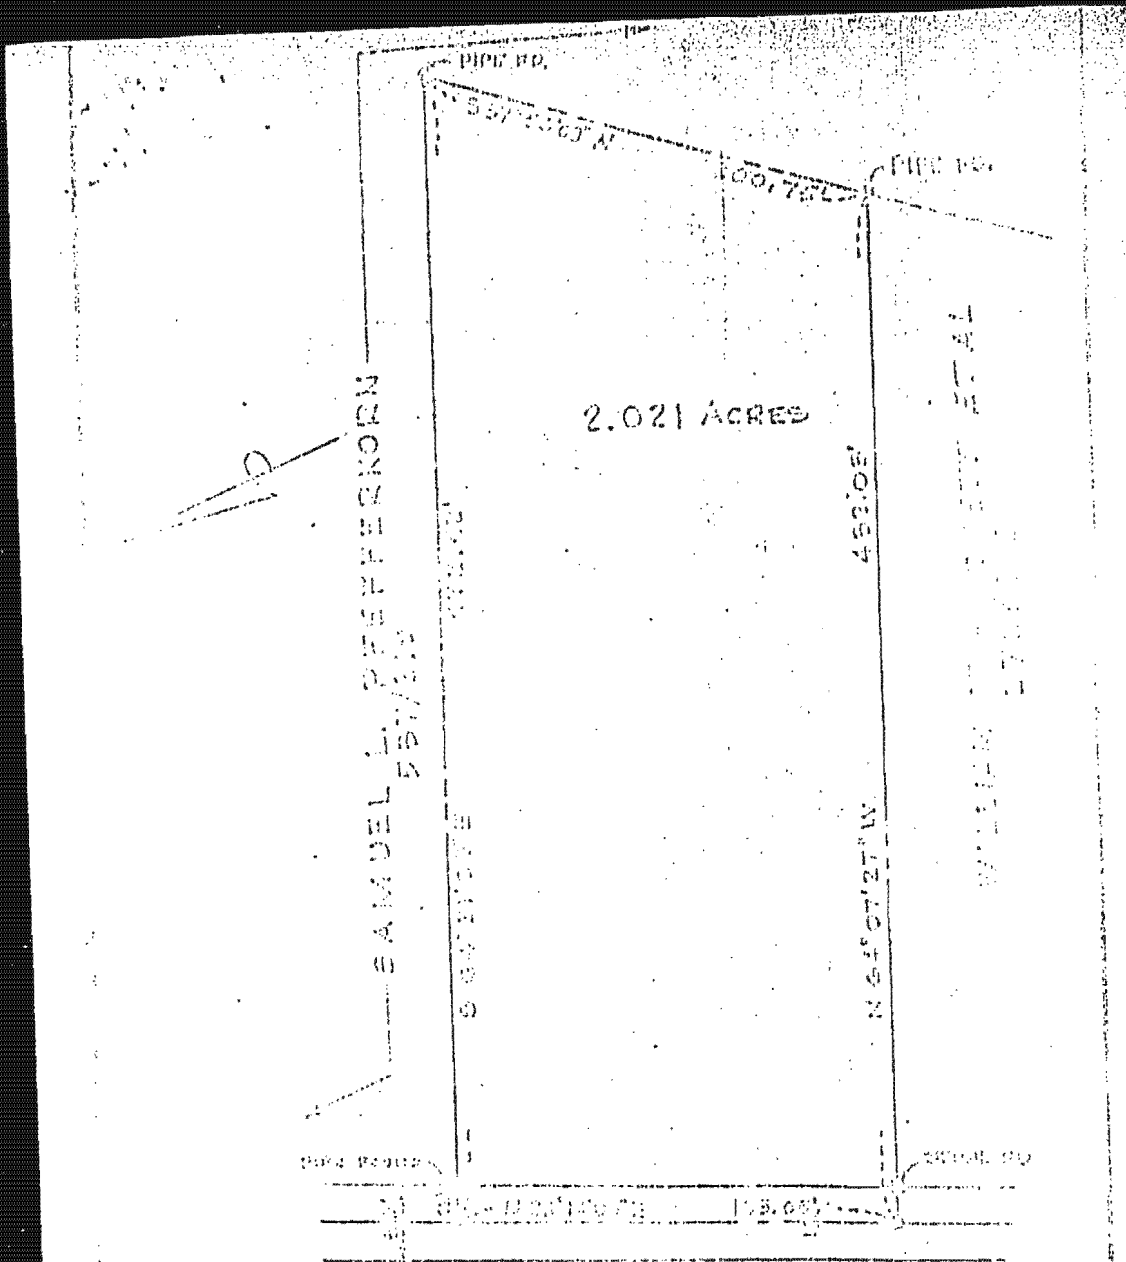

2.021 ACRES

SAMUEL L. PEPPEKORN DRIVE

651'00"

452'00"

N 64° 00' 27" W

PIPE NO.

PIPE NO.

175'00"

OLD ROVER ROAD

The lot shown hereon complies with the minimum cornering width and lot area as required by the Maryland State Department of Health Regulation.

Approved for Private sewage and private water.

*Robert F. Glavin*  
Howard County Health Officer

7-23-73  
Date

