

APPLICATION

19138

SEWAGE DISPOSAL TESTING

P. _____

STATE OF MARYLAND - DEPARTMENT OF HEALTH AND MENTAL HYGIENE

HOWARD COUNTY HEALTH DEPARTMENT
ENVIRONMENTAL HEALTH SERVICES
P. O. BOX 476, ELLICOTT CITY, MARYLAND 21043
TELEPHONE: 468-8000, EXT. 386

DISTRICT 4

DATE Oct. 29, 1973

DIRECTIONS: FROM DAMASCUS, SOUTH ON ROUTE #108, go 2 miles approximately, take left on Mullinix Mill Road, continue approximately 2 1/2 miles, go cross bridge from Montgomery County into Howard County, property is the far corner of first open field on left.

TO: THE COUNTY HEALTH OFFICER
ELLICOTT CITY, MARYLAND

I, HEREBY, APPLY FOR THE NECESSARY TEST IN ORDER TO CONSTRUCT (OR RECONSTRUCT) A SEWAGE DISPOSAL SYSTEM.

PROPERTY OWNER Michael W. and Gale McAlister

ADDRESS 18616 Walkers Choice, Gaithersburg, Md. PHONE 301-869-6344
or 301-926-1074 Mrs. Coffey

PROPERTY LOCATION:

SUBDIVISION Rt. #3, Average-Corner Mullinix Mill Road LOT NO. 1
ROAD AND DESCRIPTION where meets Bookoff Property- plat attached
Mullinix Mill road, Mt. Airy, Maryland

SIZE OF LOT 1.0942 acres, TYPE BLDG. One story rambler
just under 2 acres NUMBER OF BEDROOMS _____

IF NOT SINGLE RESIDENCE DESCRIBE single dwelling, residence

THE SYSTEM INSTALLED UNDER THIS APPLICATION IS ACCEPTABLE ONLY UNTIL PUBLIC FACILITIES BECOME AVAILABLE.

SIGNATURE OF APPLICANT Michael W. McAlister
Michael McAlister

APPROVED BY _____ FOR _____ DATE _____
(KIND OF SYSTEM)


REJECTED BY _____ FOR _____ DATE _____
(KIND OF SYSTEM)

HOLD PENDING FURTHER TESTS _____ DATE _____

REASONS FOR REJECTION OR HOLDING _____

THIS IS NOT A PERMIT

NOV 19 1973

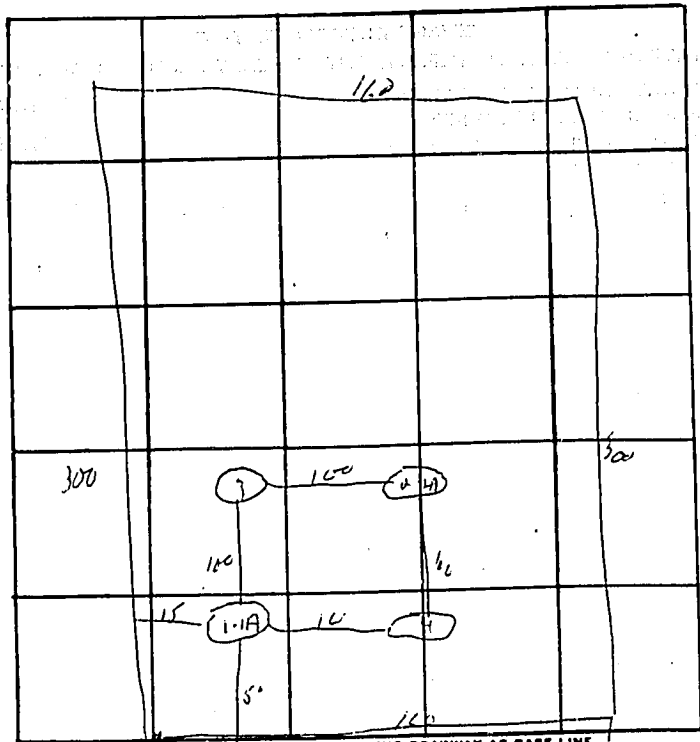

INDICATE NORTH - NAME ADJOINING ROADWAY AS BASE LINE

Mallin's Mill Rd

DATE	TEST NO.	DEPTH	PRE-WET		TEST - 1" DROP		TIME
			START	STOP	START	STOP	
11-1-73	1	12'	10 ⁴⁷	10 ⁴⁶	10 ⁴⁶	11 ⁰⁵	19 min
	1A	4'	10 ⁴⁷	10 ⁵⁵	10 ⁵⁵	11 ²⁰	35 min
	2	13'	11 ²²	11 ³⁵	11 ³⁵	11 ⁵²	30 min
	2A	7'	11 ²⁹	11 ³¹	11 ³²	11 ³⁶	5 min
	3						
	4						

good soil - shell

REMARKS *but soil 5' - 1-1A low - 0.2A high - dist measured to edge of rd*

TYPE OF SOIL _____