


EDGEWOODS WAY

APPROVED
WALK-THRU BUILDING PERMIT

DATE: 2-16-17
Approved as shown

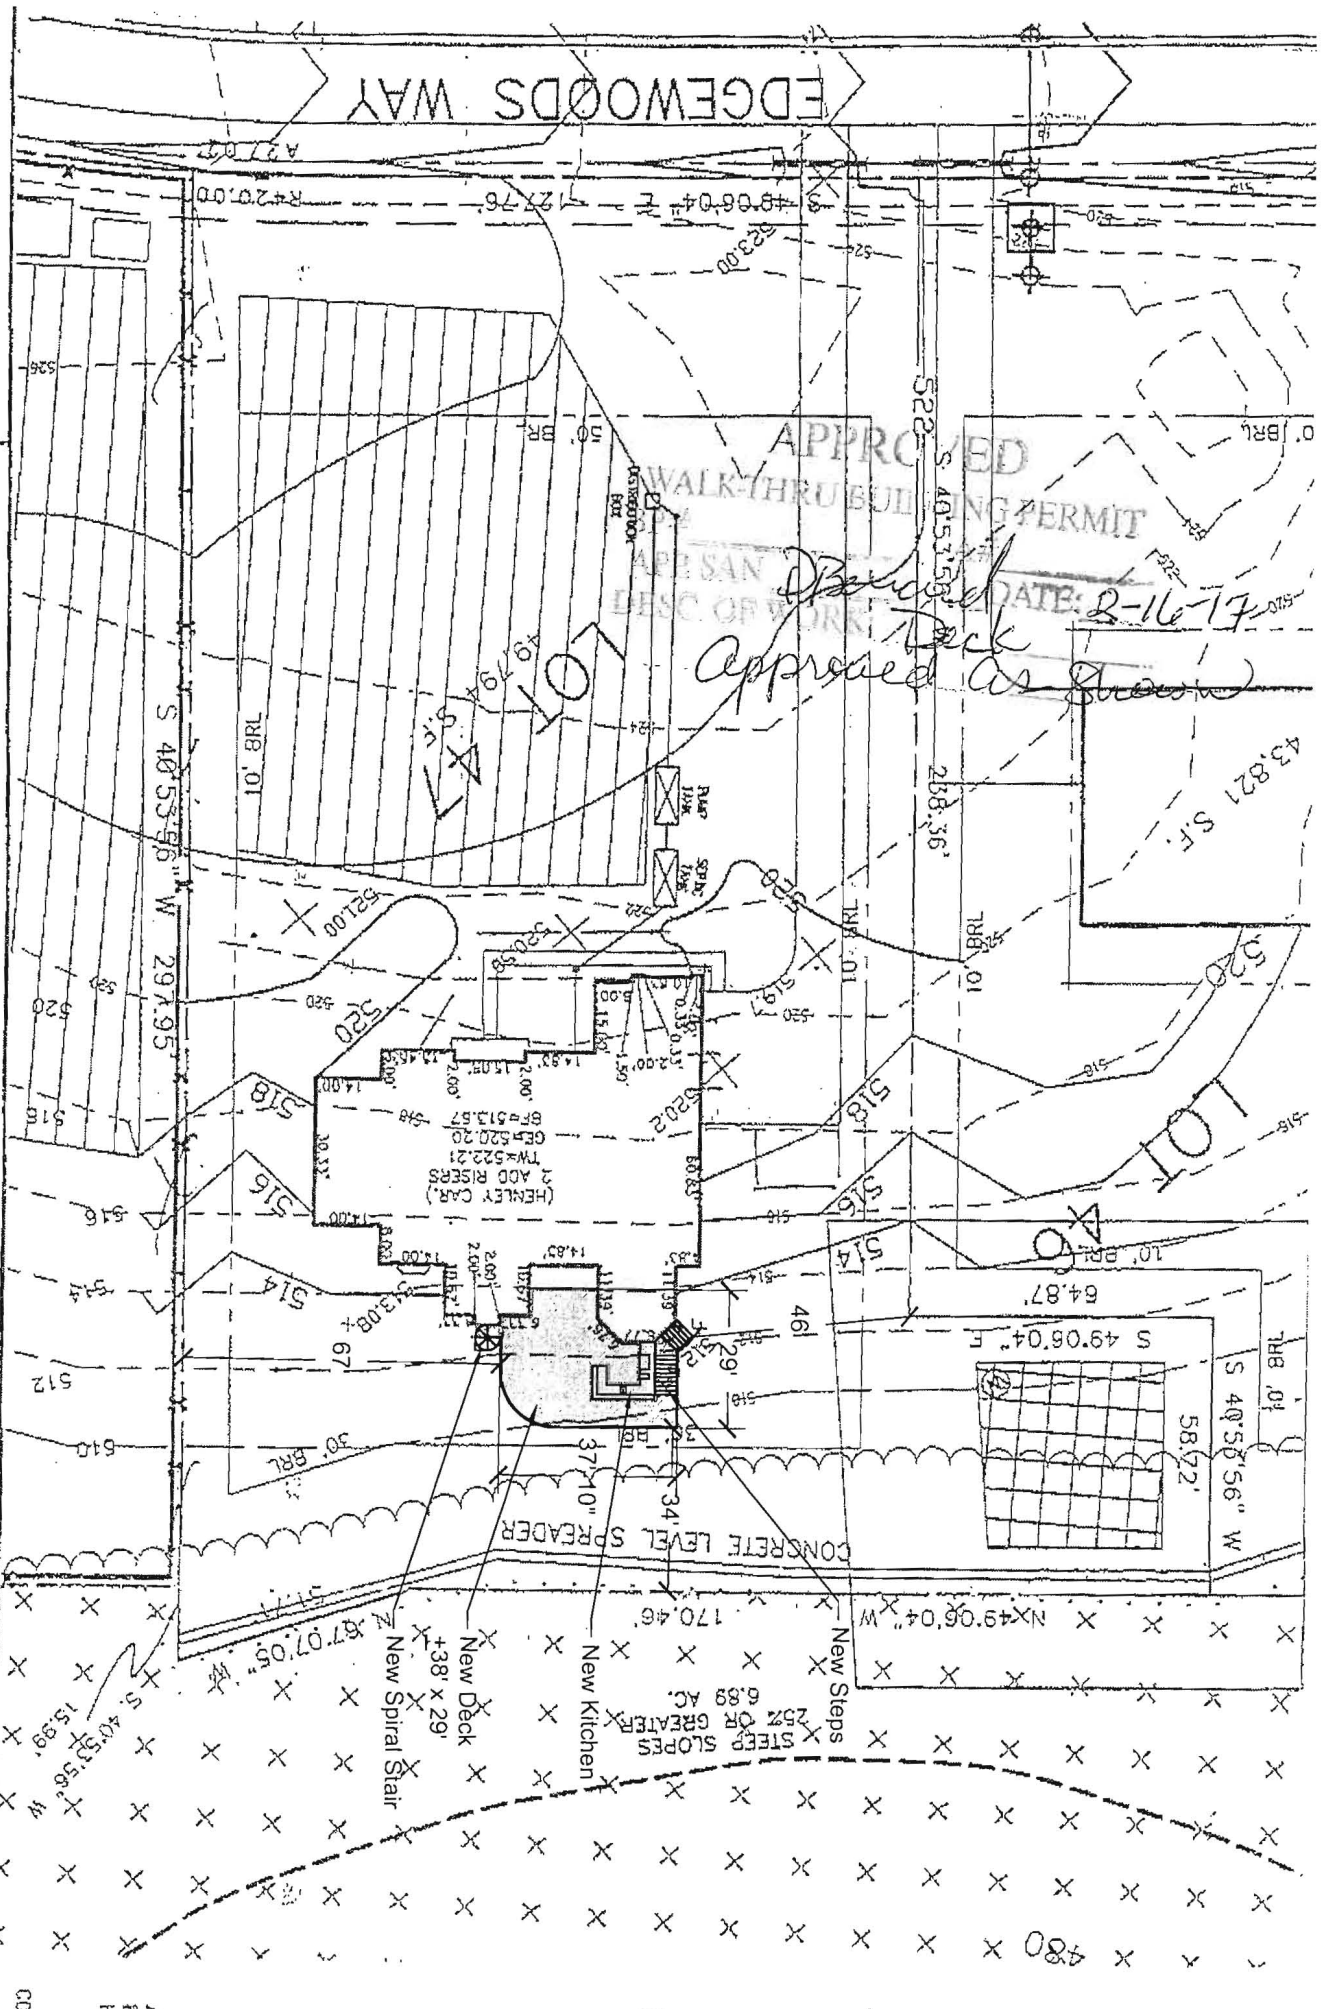

- TYPE: HEILY CAR.
- 023 - EXPANDED PAULY ROOF
 - 039 - CONSERVATORY ELITE ADDITION
 - 010 - ADD 'I' TO HEIGHT OF BASEMENT FOUNDATION WALLS
 - 521 - BEDROOM SUITES ABOVE AN ELITE ADDITION
 - 523 - HALLS SUITE ADDITION
 - 156 - BAY WINDOWS

SCALE: 1" = 40'

PERMIT PLOT PLAN

LOT #47

EDGEWOOD FARM

