

1/6/00
1/6/00 Repair Per

PERMIT

SEWAGE DISPOSAL SYSTEM

DEPARTMENT OF HEALTH AND MENTAL HYGIENE

P 513211

A REPAIR

DISTRICT _____

HOWARD COUNTY HEALTH DEPARTMENT
BUREAU OF ENVIRONMENTAL HEALTH
~~XXXXXXX~~ 410-313-2640

RPS# 381355

DATE 1/5/2000

DATE SYSTEM APPROVED 1/6/00

INDEXED

INSPECTOR S.R.K.

Jack Fyock Septic Service _____ IS PERMITTED TO INSTALL _____ ALTER X

ADDRESS P. O. Box 89, Triadelphia Road, Glenelg, Maryland 21737 PHONE 410-988-9270

SUBDIVISION _____ LOT 5 ROAD 8037 Murphy Road

PROPERTY OWNER _____ Kornich
ADDRESS _____ 8037 Murphy Road
Fulton, Maryland 20759

SEPTIC TANK CAPACITY 1000 GALLONS

NUMBER OF BEDROOMS 3

125 SQUARE FEET PER BEDROOM

LINEAR FEET OF TRENCH REQUIRED 62.5

REPAIR - PURPOSE - SEPTIC SYSTEM FAILED.

Call for inspection when ground is opened so sanitarian can recommend repair.

01/04/2000

Bottom @ 10' below original grade

Inlet @ 4' below original grade

6' of stone below distribution pipe

PLANS APPROVED BY SRK

DATE 1/6/00

COVER NO WORK UNTIL INSPECTED AND APPROVED

NEITHER THE HOWARD COUNTY COUNCIL NOR THE HEALTH DEPARTMENT IS RESPONSIBLE FOR THE SUCCESSFUL OPERATION OF ANY SYSTEM

NOTE: CLEANOUT REQUIRED EVERY 70 FEET OF SEWER LINE AND/OR AT 90° SWEEPS IN LINES FROM HOUSE TO DRAIN FIELDS. 90° ELBOWS NOT ACCEPTABLE.

NOTE: ALL PARTS OF SEPTIC SYSTEMS (I.E. TANK, DISTRIBUTION BOX TRENCHES) TO BE 100 FEET FROM WELL (UNLESS OTHERWISE SPECIFICALLY AUTHORIZED)

NOTE: IF DEEP TRENCH(ES) ARE USED CALL FOR INSPECTION BEFORE AND AFTER PLACING GRAVEL IN TRENCH(ES)

NOTE: NO DRY WELL SHALL EXCEED 15 FOOT IN DIAMETER NO ABSORPTION TRENCH TO EXCEED 100 FEET IN LENGTH

NOTE: ALL PIPE FROM HOUSE TO SEPTIC TANK MUST BE CAST IRON OR SCHEDULE 35/40 PVC OR ABS

PERMIT VOID AFTER TWO YEARS

NOTE: INSTALL STAND PIPE ON SEPTIC TANK AND DRY WELL STAND PIPES MUST BE 6 INCHES IN DIAMETER CAST IRON. CONCRETE OR TERRA COTTA OR PVA OR ABS ACCEPTED. IF TOP OF SEPTIC TANK IS DEEPER THAN 3 FEET. MANHOLE TO GRADE REQUIRED.



NOTE: DISTRIBUTION BOXES MUST HAVE BAFFLES

***INSTALLER IS RESPONSIBLE FOR OBTAINING FINAL APPROVAL ON THIS PERMIT**

513211

50 100 150 200 250

Soil Profile

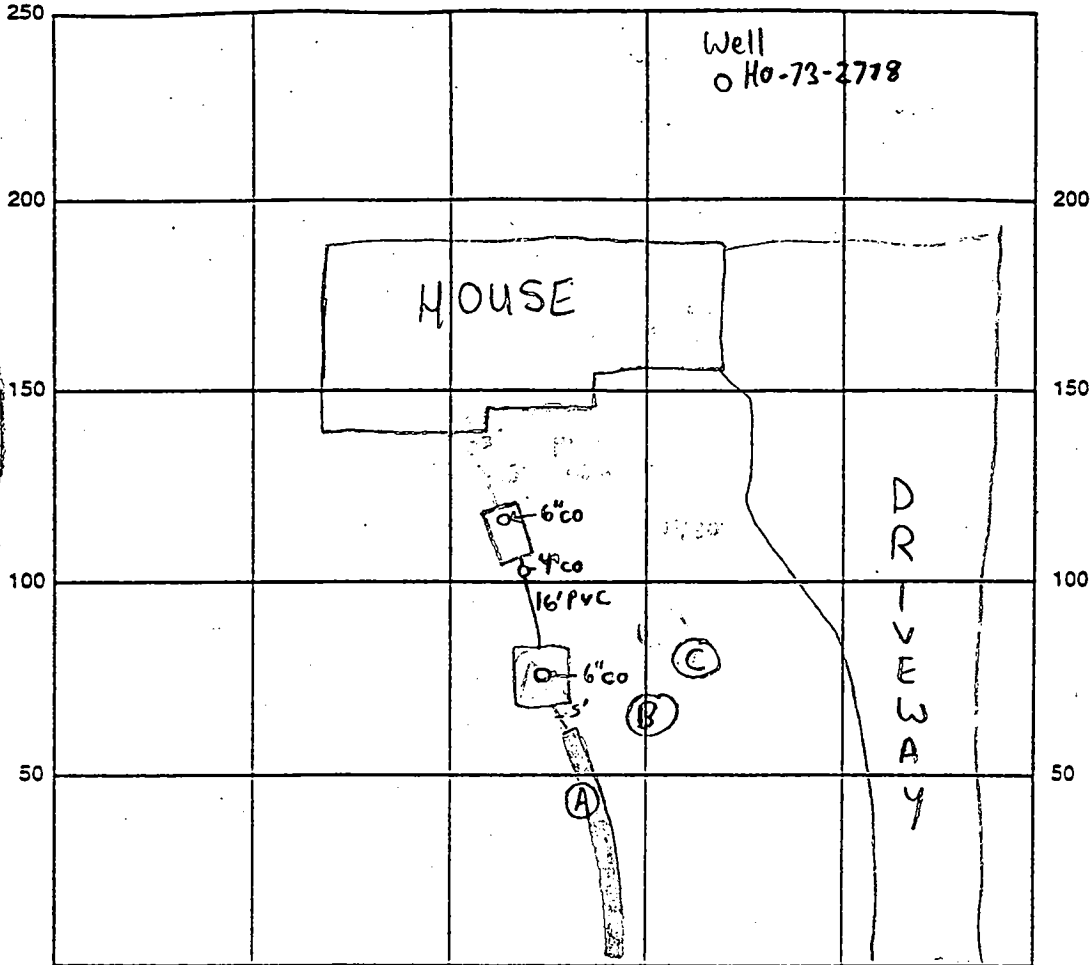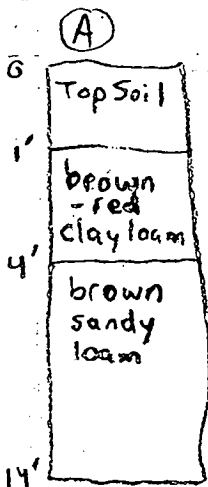

INDICATE NORTH - NAME ADJOINING ROADWAY AS BASE LINE

MURPHY ROAD

SEPTIC TANK LEVEL N/A CLEANOUTS 6" on S.T., 6" on D.W., 4" in line

DISTRIBUTION BOX LEVEL N/A

DRAIN FIELD/TITLE DEPTH 10 FT. TRENCH WIDTH 2 FT. INLET DEPTH 4' FT.

EFFECTIVE GRAVEL DEPTH 6 FT. TOTAL LENGTH 63 FT.

NUMBER OF TRENCHES 1 ONE SIDEWALL/BOTTOM AREA 378 SQ. FT.

DRYWALL INSIDE DIAMETER N/A FT. EFFECTIVE DEPTH BELOW INLET N/A FT.

ABSORBENT AREA N/A SQ. FT.

REMARKS: 1/6/00 - PERC HOLE DUG IN LOCATION (B) & (C) SOME FILL MATERIAL & BURIED DEBRIS FOUND AT 2-3'; PERC HOLE DUG IN LOCATION (A) SOILS GOOD TO INSTALL

OK TO INSTALL TRENCH AS SPECIFIED, PIPE FROM SEPTIC TANK TO DRYWELL REPLACED W/PVC & 4" IN LINE CLEANOUT INSTALLED, OK TO CONTINUE WORK (SRK)

1/6/00 - OK TO COVER ALL WORK (SRK)

DATE SYSTEM APPROVED 1/6/00 INSPECTOR Steven R. King