

# APPLICATION

## FOR PERCOLATION TESTING AND SITE EVALUATION

TEST DATE(S) \_\_\_\_\_ TEST TIME \_\_\_\_\_ APR 5 22008

AGENCY REVIEW: \_\_\_\_\_ DATE 3/4/2005

TAX ID # 04-318501

DO NOT WRITE ABOVE THIS LINE

I HEREBY APPLY FOR THE NECESSARY TESTING/EVALUATION PRIOR TO ISSUANCE OF SEWAGE DISPOSAL SYSTEM PERMIT(S) TO:

CHECK AS NEEDED:

- CONSTRUCT NEW SEPTIC SYSTEM(S)
- REPAIR/ADD TO AN EXISTING SEPTIC SYSTEM
- REPLACE AN EXISTING SEPTIC SYSTEM

CHECK AS NEEDED:

- NEW STRUCTURE(S)
- ADDITION TO AN EXISTING STRUCTURE
- REPLACE AN EXISTING STRUCTURE

CHECK ONE:

- CREATE NEW LOT(S)
- BUILD ON AN EXISTING LOT IN A SUBDIVISION
- BUILD ON AN EXISTING PARCEL OF RECORD

IS THE PROPERTY WITHIN 2500' OF ANY RESERVOIR?

- YES
- NO

THE TYPE OF STRUCTURE IS:

- RESIDENTIAL WITH \_\_\_\_\_ PROPOSED BEDROOMS IN THE COMPLETED STRUCTURE (NOTE *UNKNOWN* IF APPROPRIATE)
- COMMERCIAL (PROVIDE DETAIL OF NUMBERS AND TYPES OF EMPLOYEES/ CUSTOMERS ON ACCOMPANYING PLAN)
- INSTITUTIONAL/GOVERNMENT (PROVIDE DETAIL OF NUMBERS AND TYPES OF EMPLOYEES/USERS ON ACCOMPANYING PLAN)

PROPERTY OWNER(S) C. EDGAR PUGH, JR

DAYTIME PHONE \_\_\_\_\_ CELL \_\_\_\_\_ FAX \_\_\_\_\_

MAILING ADDRESS 2289 MCKENDREE ROAD WEST FRIENDSHIP MO 21794  
STREET CITY/TOWN STATE ZIP

APPLICANT BENCHMARK ENGINEERING, INC.

DAYTIME PHONE 410-465-6105 CELL \_\_\_\_\_ FAX 410-465-6644

MAILING ADDRESS 8480 BALT. NATIONAL PIKE, SUITE 418 ELLICOTT CITY MD 21043  
STREET CITY/TOWN STATE ZIP

APPLICANT'S ROLE: DEVELOPER BUILDER BUYER RELATIVE/FRIEND REALTOR CONSULTANT

PROPERTY LOCATION EXISTING  
SUBDIVISION/PROPERTY NAME MCKENDREE VIEW LOT NO. DWELLING







PROPERTY ADDRESS 2289 MCKENDREE ROAD WEST FRIENDSHIP MD 21794  
STREET TOWN/POST OFFICE

TAX MAP PAGE(S) 41 & 42 GRID 1,6,7 & 12 PARCEL(S) 54 PROPOSED LOT SIZE 3.0 AC

AS APPLICANT, I UNDERSTAND THE FOLLOWING: THE SYSTEM INSTALLED SUBSEQUENT TO THIS APPLICATION IS ACCEPTABLE ONLY UNTIL PUBLIC SEWERAGE IS AVAILABLE. THIS APPLICATION IS COMPLETE WHEN ALL APPLICABLE FEES AND A SUITABLE SITE PLAN HAVE BEEN RECEIVED. I ACCEPT THE RESPONSIBILITY FOR COMPLIANCE WITH ALL M.O.S.H.A. AND "MISS UTILITY" REQUIREMENTS. APPROVAL IS BASED UPON SATISFACTORY REVIEW OF A PERC CERTIFICATION PLAN.

TEST RESULTS WILL BE MAILED TO APPLICANT. Donald Maen  
SIGNATURE OF APPLICANT

HOWARD COUNTY HEALTH DEPARTMENT, BUREAU OF ENVIRONMENTAL HEALTH, WELL AND SEPTIC PROGRAM  
3525-H ELLICOTT MILLS DRIVE, ELLICOTT CITY, MARYLAND 21043-4544 (410) 313-1771 FAX (410) 313-2648  
TDD (410) 313-2323 TOLL FREE 1-877-4MD-DHMH

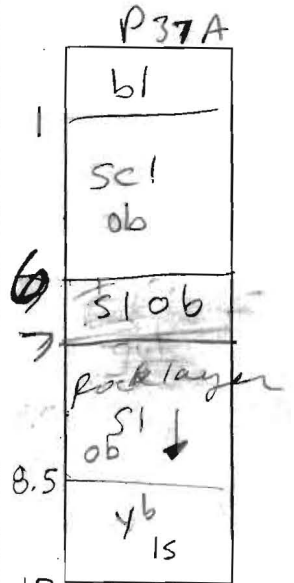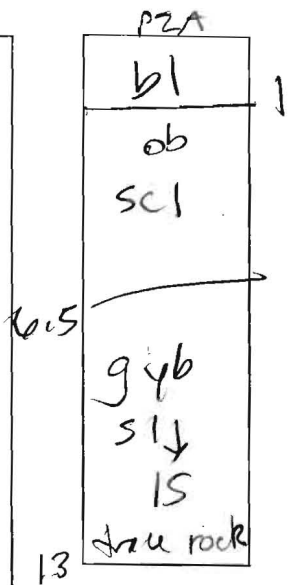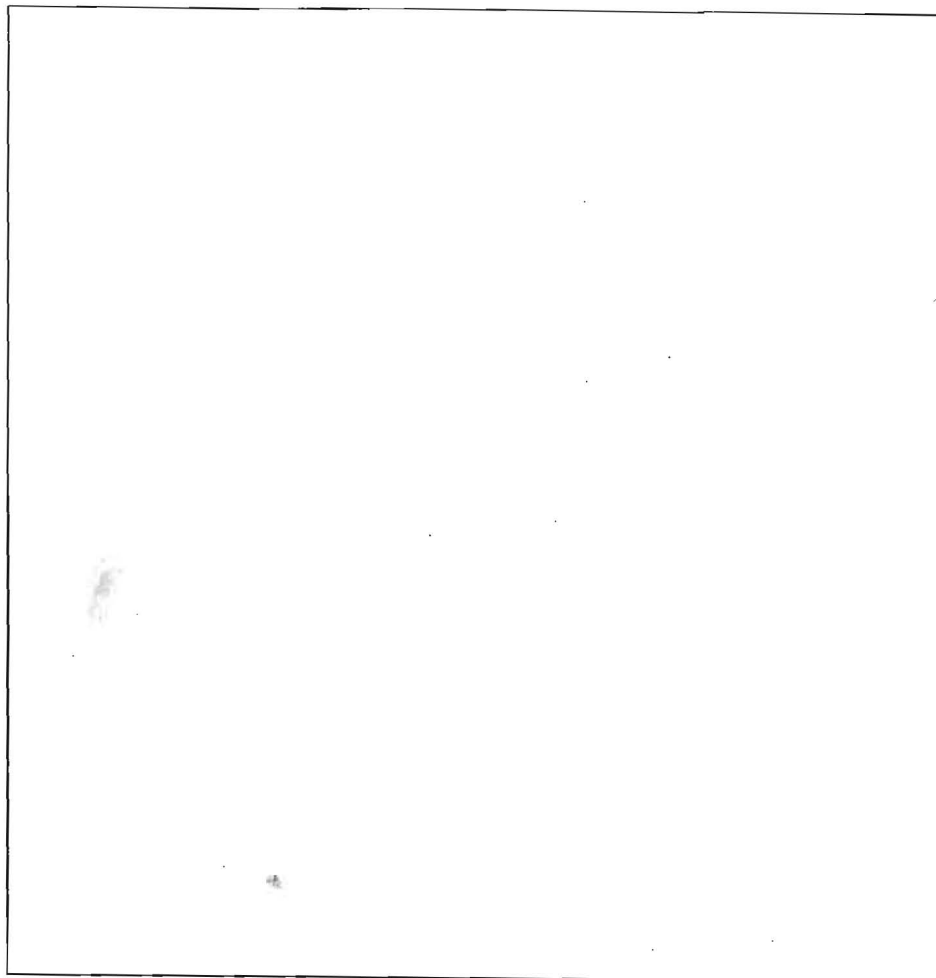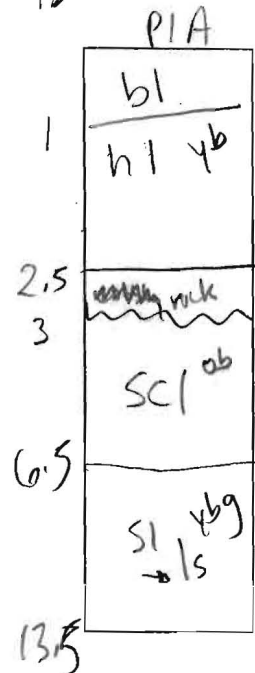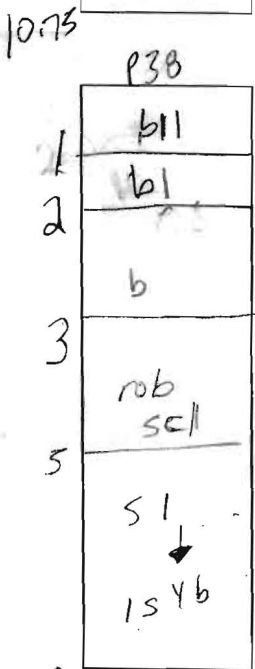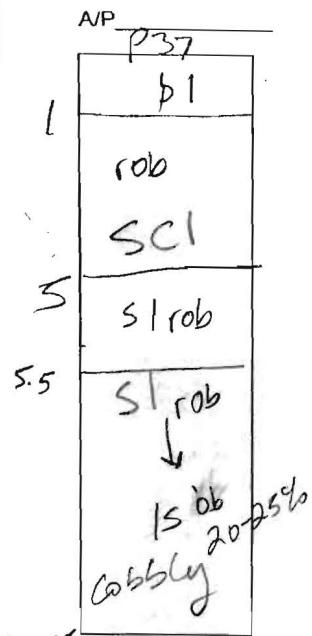

DATE	TEST #	DEPTH	START	BREAK 1" DROP	STOP 2" DROP	TIME OF 2nd INCH	P/F/H
3-30-06	P37	6 10.75	10:20	10:25	10:30	5	P
	P38	13	visual			OK	P
	PIA	8 13.5	11:26	11:30	11:36	6	P
	P2A	6 13	11:42	11:52	12:12	20	P
	P37A	13	visual				P




REMARKS: Holes 37+38 added to check current easement area. PIA+2A moved to right due to electric line along property.

SANITARIAN: KB/SF BACKHOE: Hathelds (Donnie) OTHERS:

TEST HOLES USED IN SDA: \_\_\_\_\_ AVG. PERC TIME: \_\_\_\_\_ SQ. FT/BR: \_\_\_\_\_

TRENCH WIDTH: \_\_\_\_\_ INLET DEPTH: \_\_\_\_\_ MAX. BOT DEPTH: \_\_\_\_\_ EFFECTIVE SW: \_\_\_\_\_

anot dug as shown on map

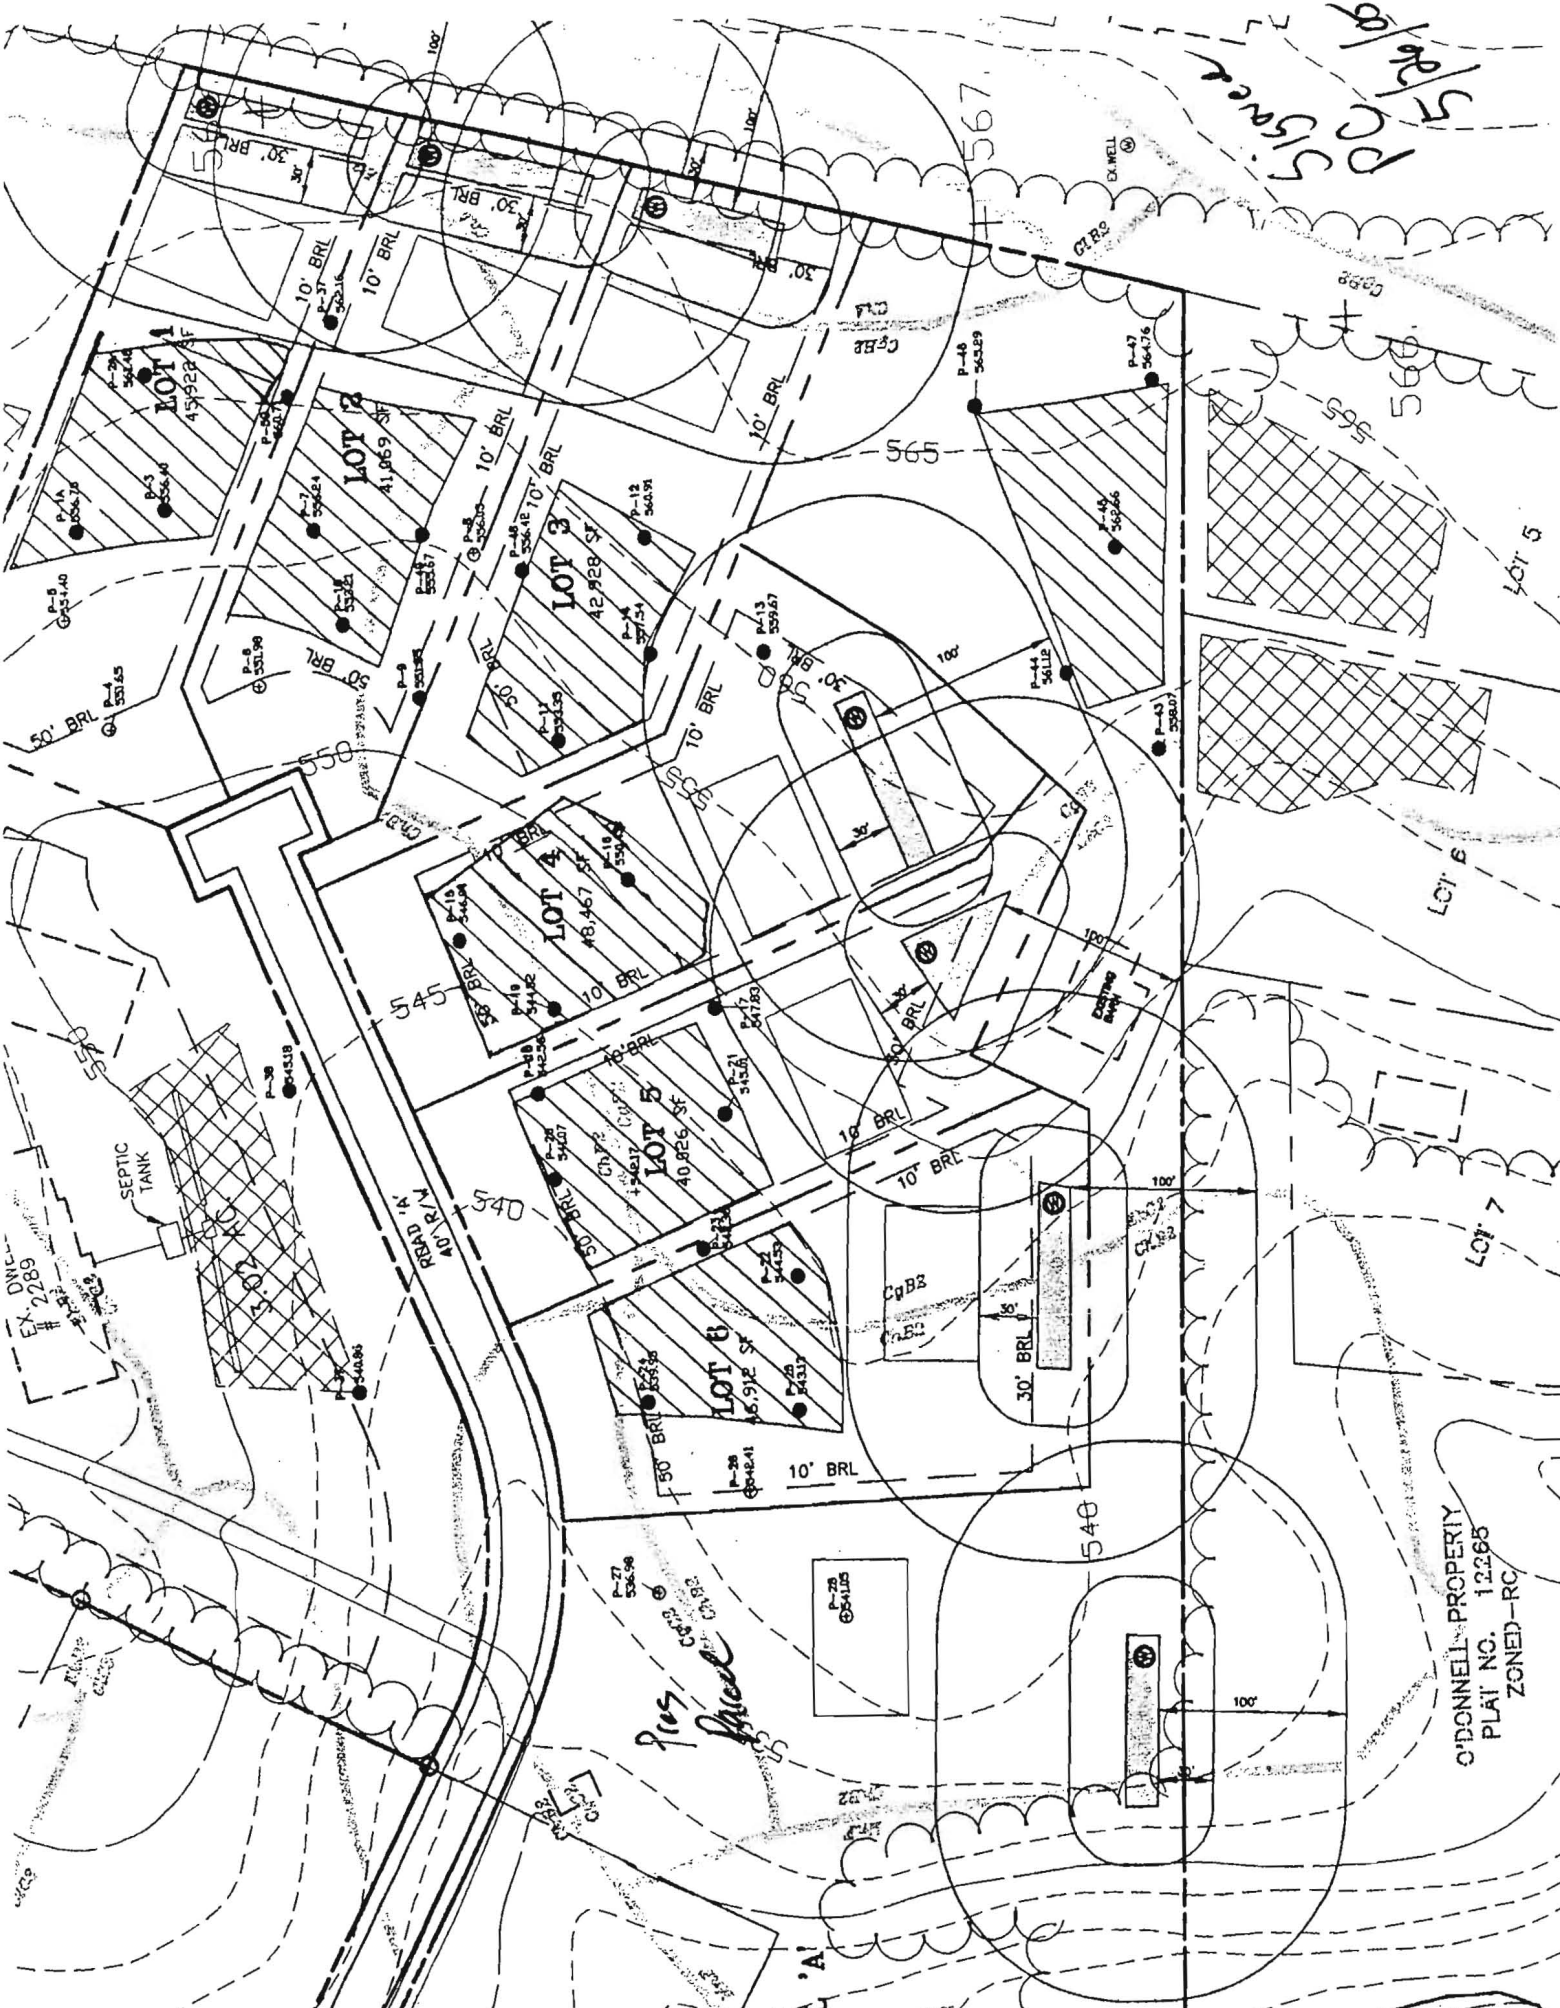

O'DONNELL PROPERTY  
 PLAT NO. 12265  
 ZONED-RC

CHARLES L. OSTERMAN  
438 / 209

ARD M. HOUGH  
PROPERTY  
AT NO. 4168

*Handwritten:* Copy Plat Cert signed 7/10/06  
SHEET 6 of 6


PRIVATELY OWNED  
RESERVATION PARCEL  
2.51 ACRES  
HOWARD COUNTY  
EASEMENT  
DWELLING  
2289

MEADOW TRAIL LANE

O.A. OWNED  
UN-BUILDABLE  
RESERVATION  
PARCEL 'C'  
1.58 ACRES  
HOWARD COUNTY

RETAINED FOREST  
LIMIT 1.0 ACRES

O'DONNELL PROPERTY  
12265

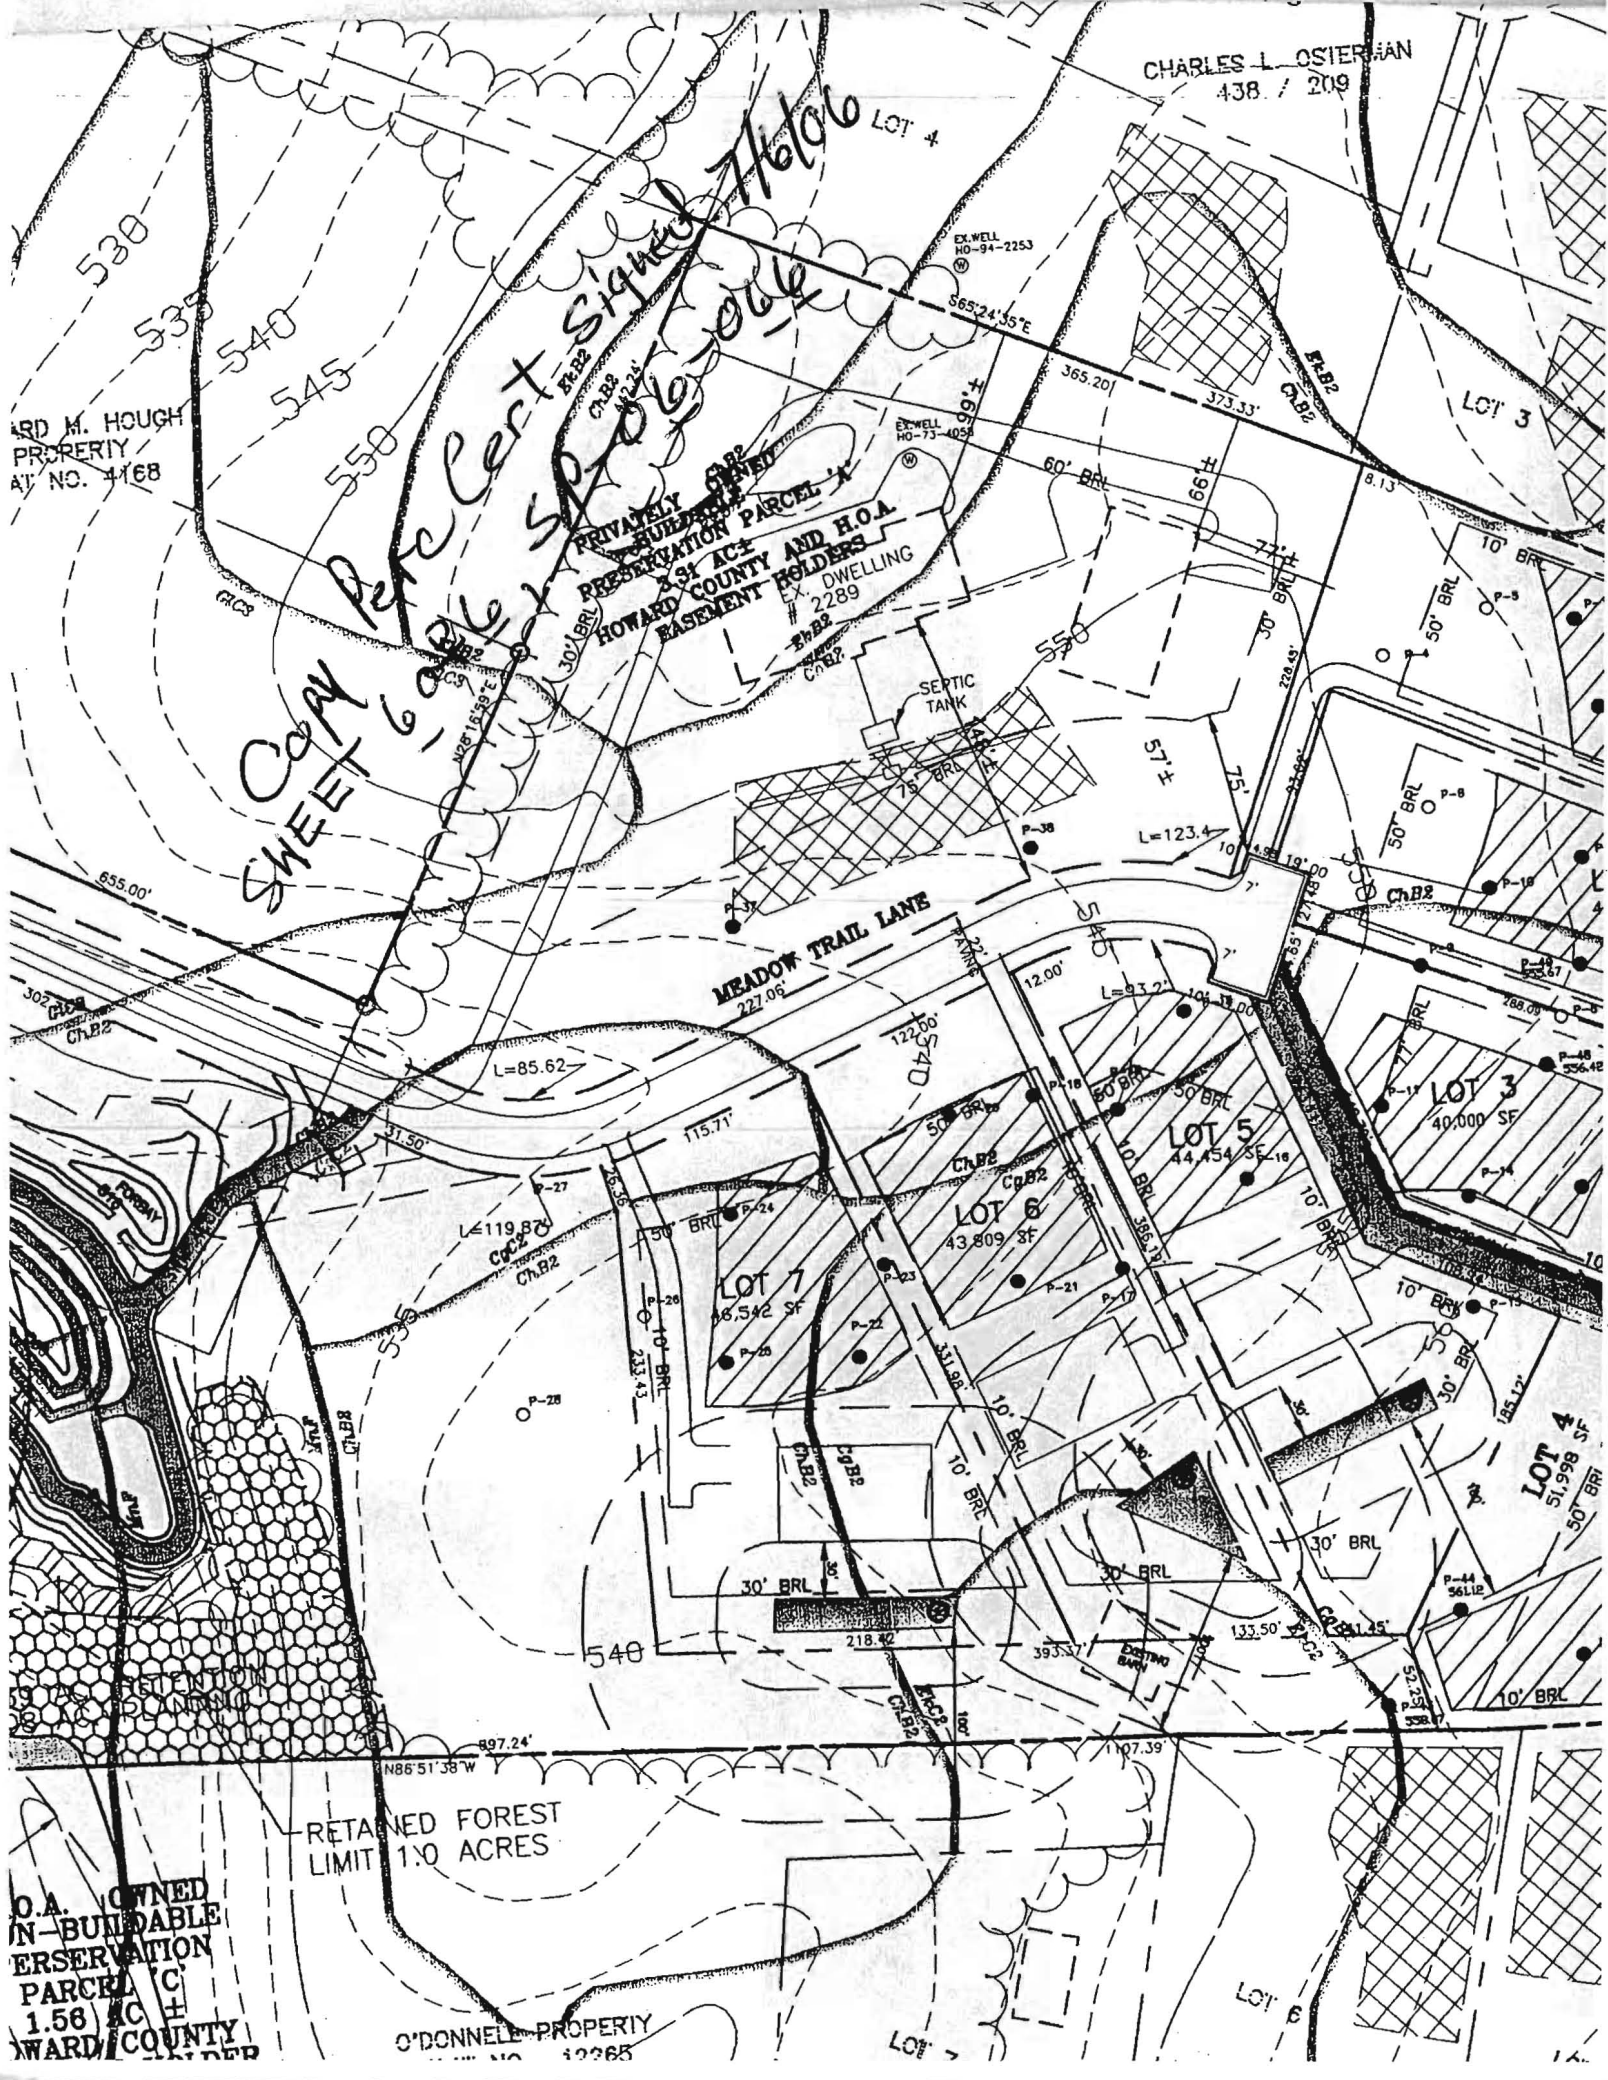

STIRN PROPERTY  
PLAT 8525

CHARLES L. OSTERMAN  
438 / 209

RICHARD M. HUGH  
PROPERTY  
PLAT NO. 4168

*Copy Perc Cert  
signed 5/26/05  
Superceded 4/16/07*

EX. DWELLING  
# 2289

SEPTIC TANK

BUILDABLE  
PRESERVATION PARCEL 'A'

ROMAN RIDGE  
LOT 4  
TAX MAP 15  
PARCEL 201

ROMAN RIDGE  
LOT 5  
TAX MAP 15  
PARCEL 202



545

350

530

535

540

518

521

524

LOT 3  
3.00 AC

LOT 6  
16,912 SF

LOT 5  
40,826 SF

LOT 4  
18,467 SF

LOT 3  
42,928 SF

LOT 2  
41,869 SF

LOT 1  
45,922 SF

Middle Patuxent  
River

WEeping CHERRY D.

E 1,312,850

N 527,950

1,312,850

PRESTEL ROBERT L  
PRESTEL JANE MARIE  
PARCEL 652  
LOT 1  
L. 5004 F. 136  
ZONED: RC-DEO

EX. WELL  
HO-94-2253  
EKB2  
'C' SOL

ChB2  
'B' SOL

EKB2  
'C' SOL

McKENDREE OVERLOOK  
PLAT NO. 14058

*McKendree View*  
*Copy*  
*Per Cert signed 4/16/07*

ChB2  
'B' SOL

EKB2  
'C' SOL

BUILDABLE  
PRESERVATION PARCEL 'A'  
PRIVATELY OWNED  
HOMEOWNERS ASSOCIATION EASEMENT HOLDER  
HOWARD COUNTY EASEMENT HOLDER

ChB2  
'B' SOL

G1C3  
'B' SOL

MEADOW TRAIL LANE  
PUBLIC ACCESS PLACE  
40' RIGHT-OF-WAY

ChB2  
'B' SOL

CgC2  
'B' SOL

ChB2  
'B' SOL

LOT 6  
CgB2  
'B' SOL


CgC2  
'B' SOL


NON-BUILDABLE  
PRESERVATION PARCEL 'C'  
HOMEOWNERS ASSOCIATION  
HOWARD COUNTY EASEMENT HOLDER

ChB2  
'B' SOL


BUILDABLE  
PRESERVATION PARCEL 'B'  
PRIVATELY OWNED  
HOMEOWNERS ASSOCIATION EASEMENT HOLDER  
HOWARD COUNTY EASEMENT HOLDER

ChB2  
'B' SOL

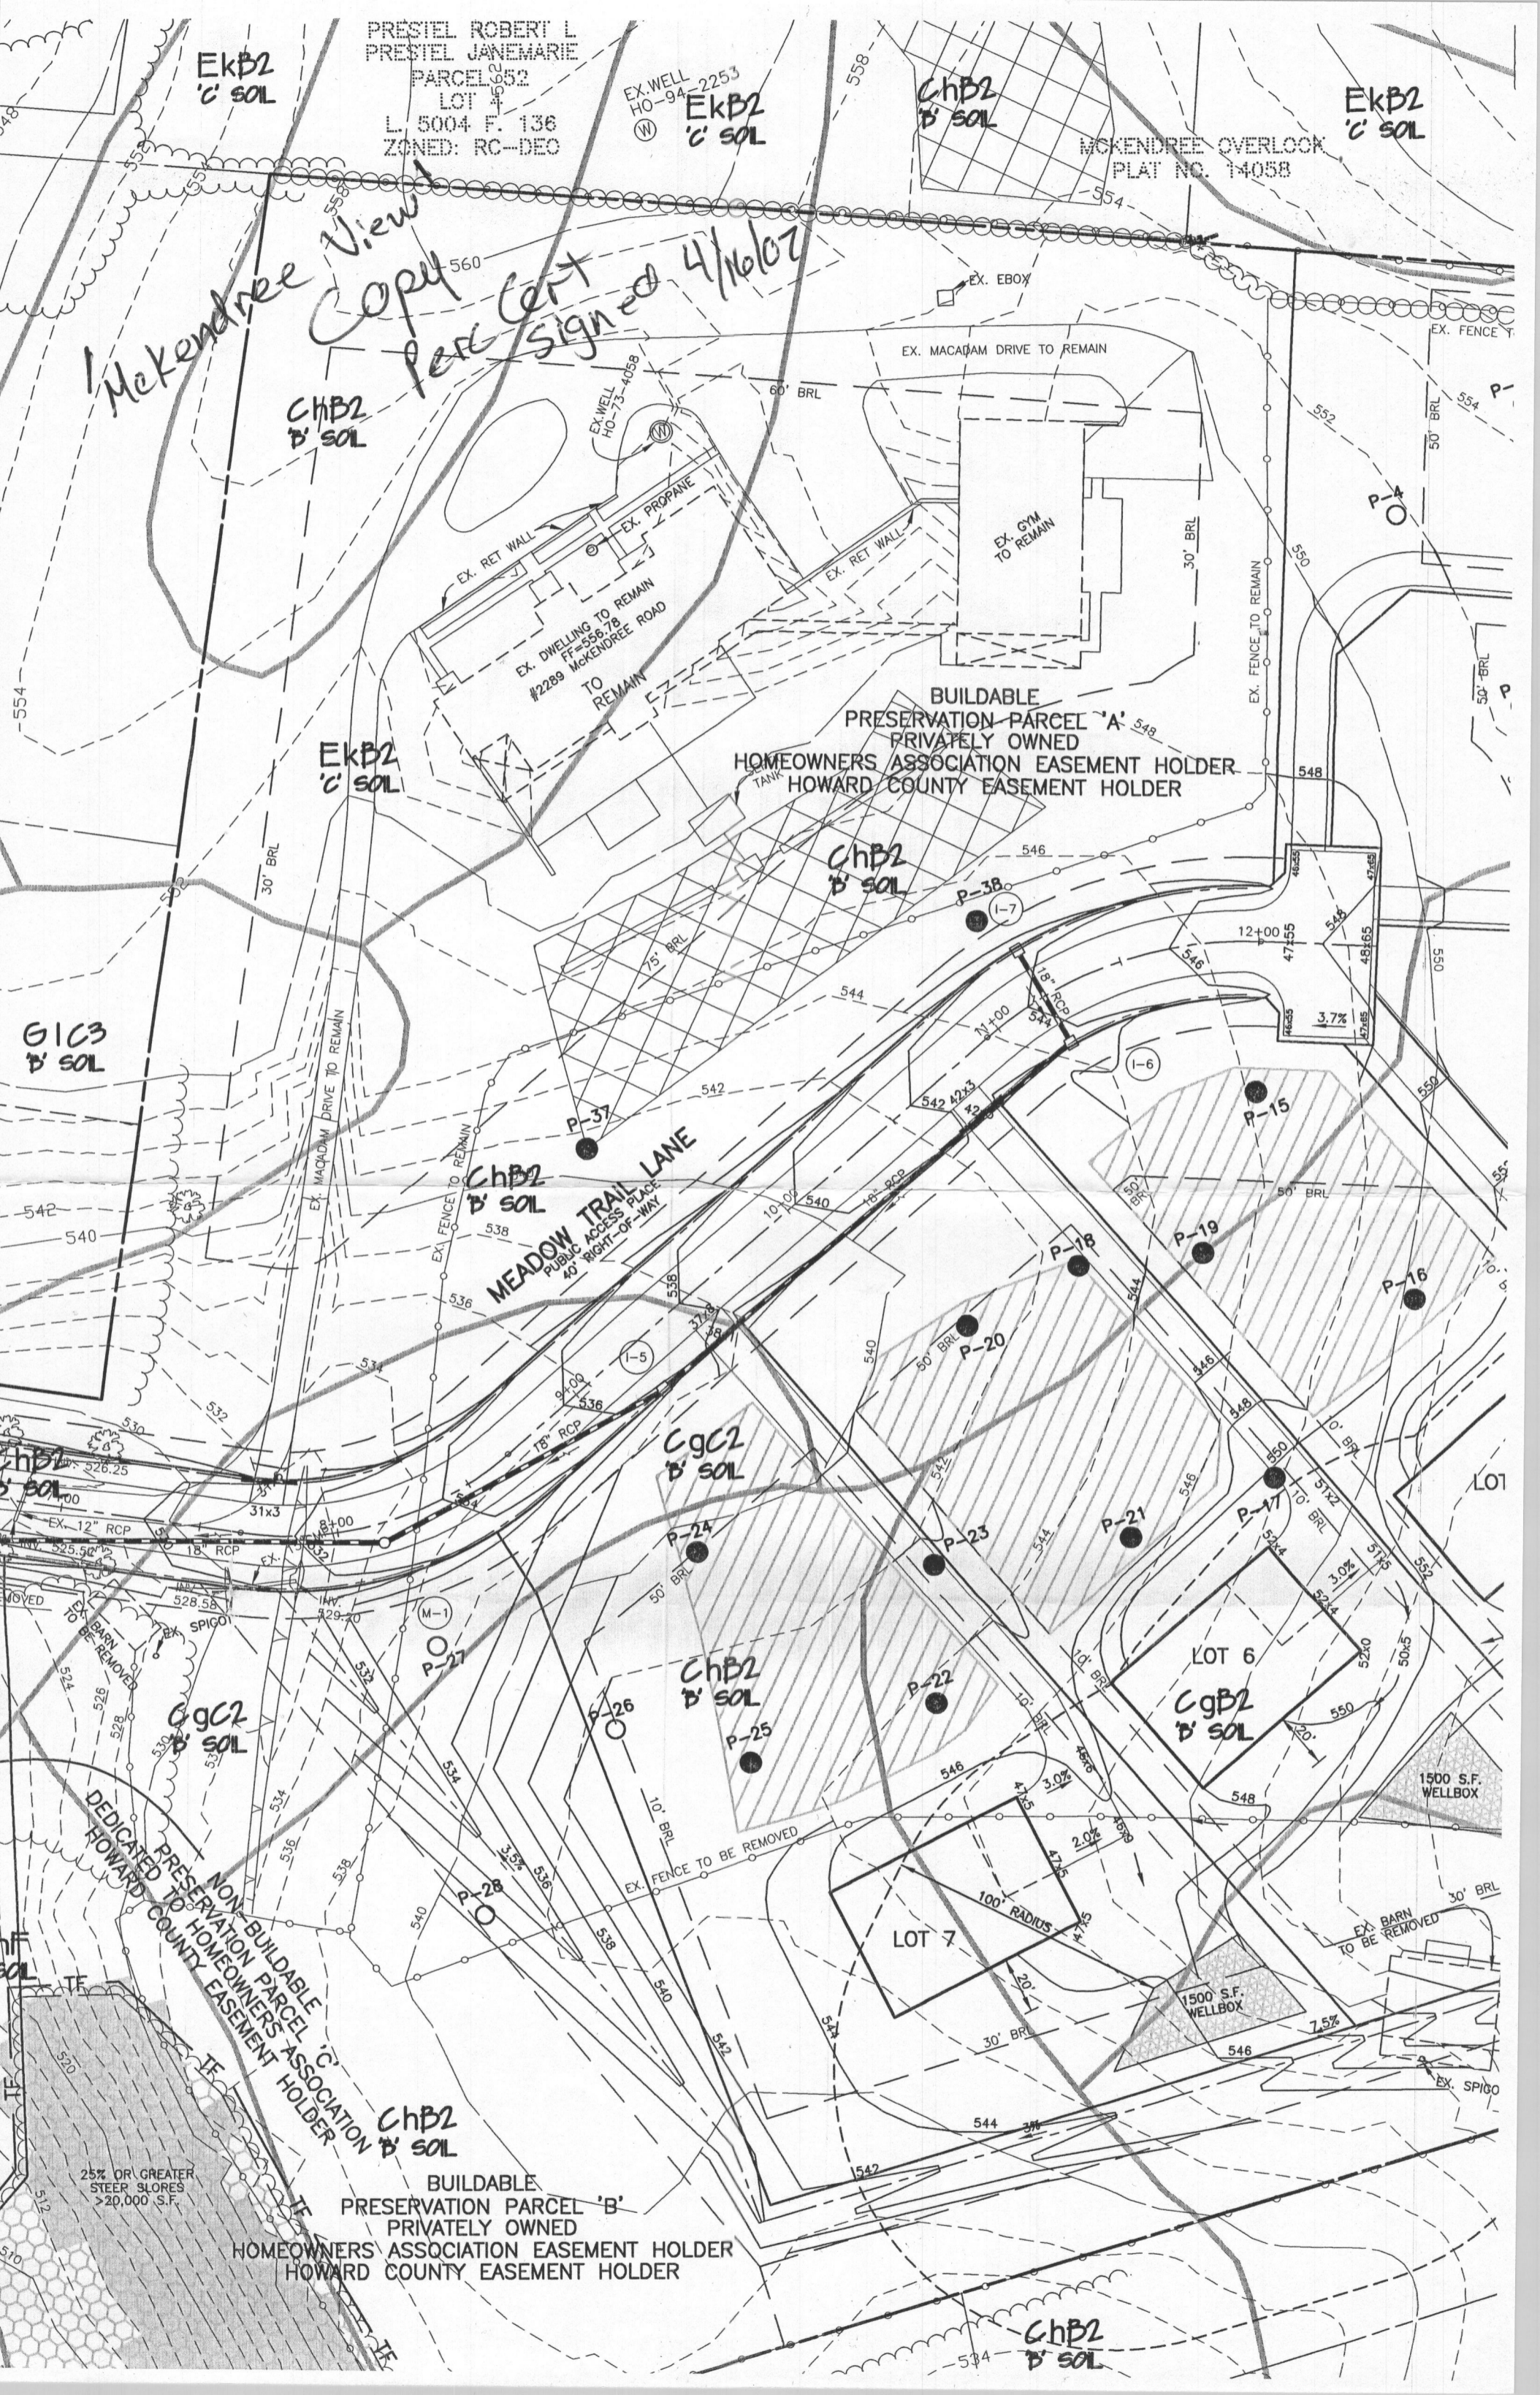

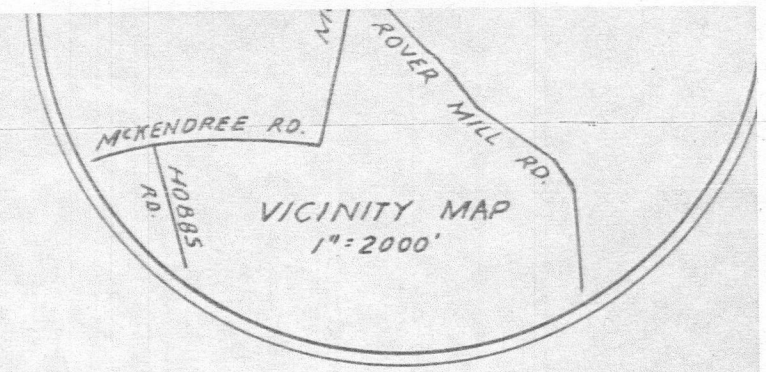

RICHARD M. HOUGH  
PROPERTY  
PLAT C.M.P. NO. 4168

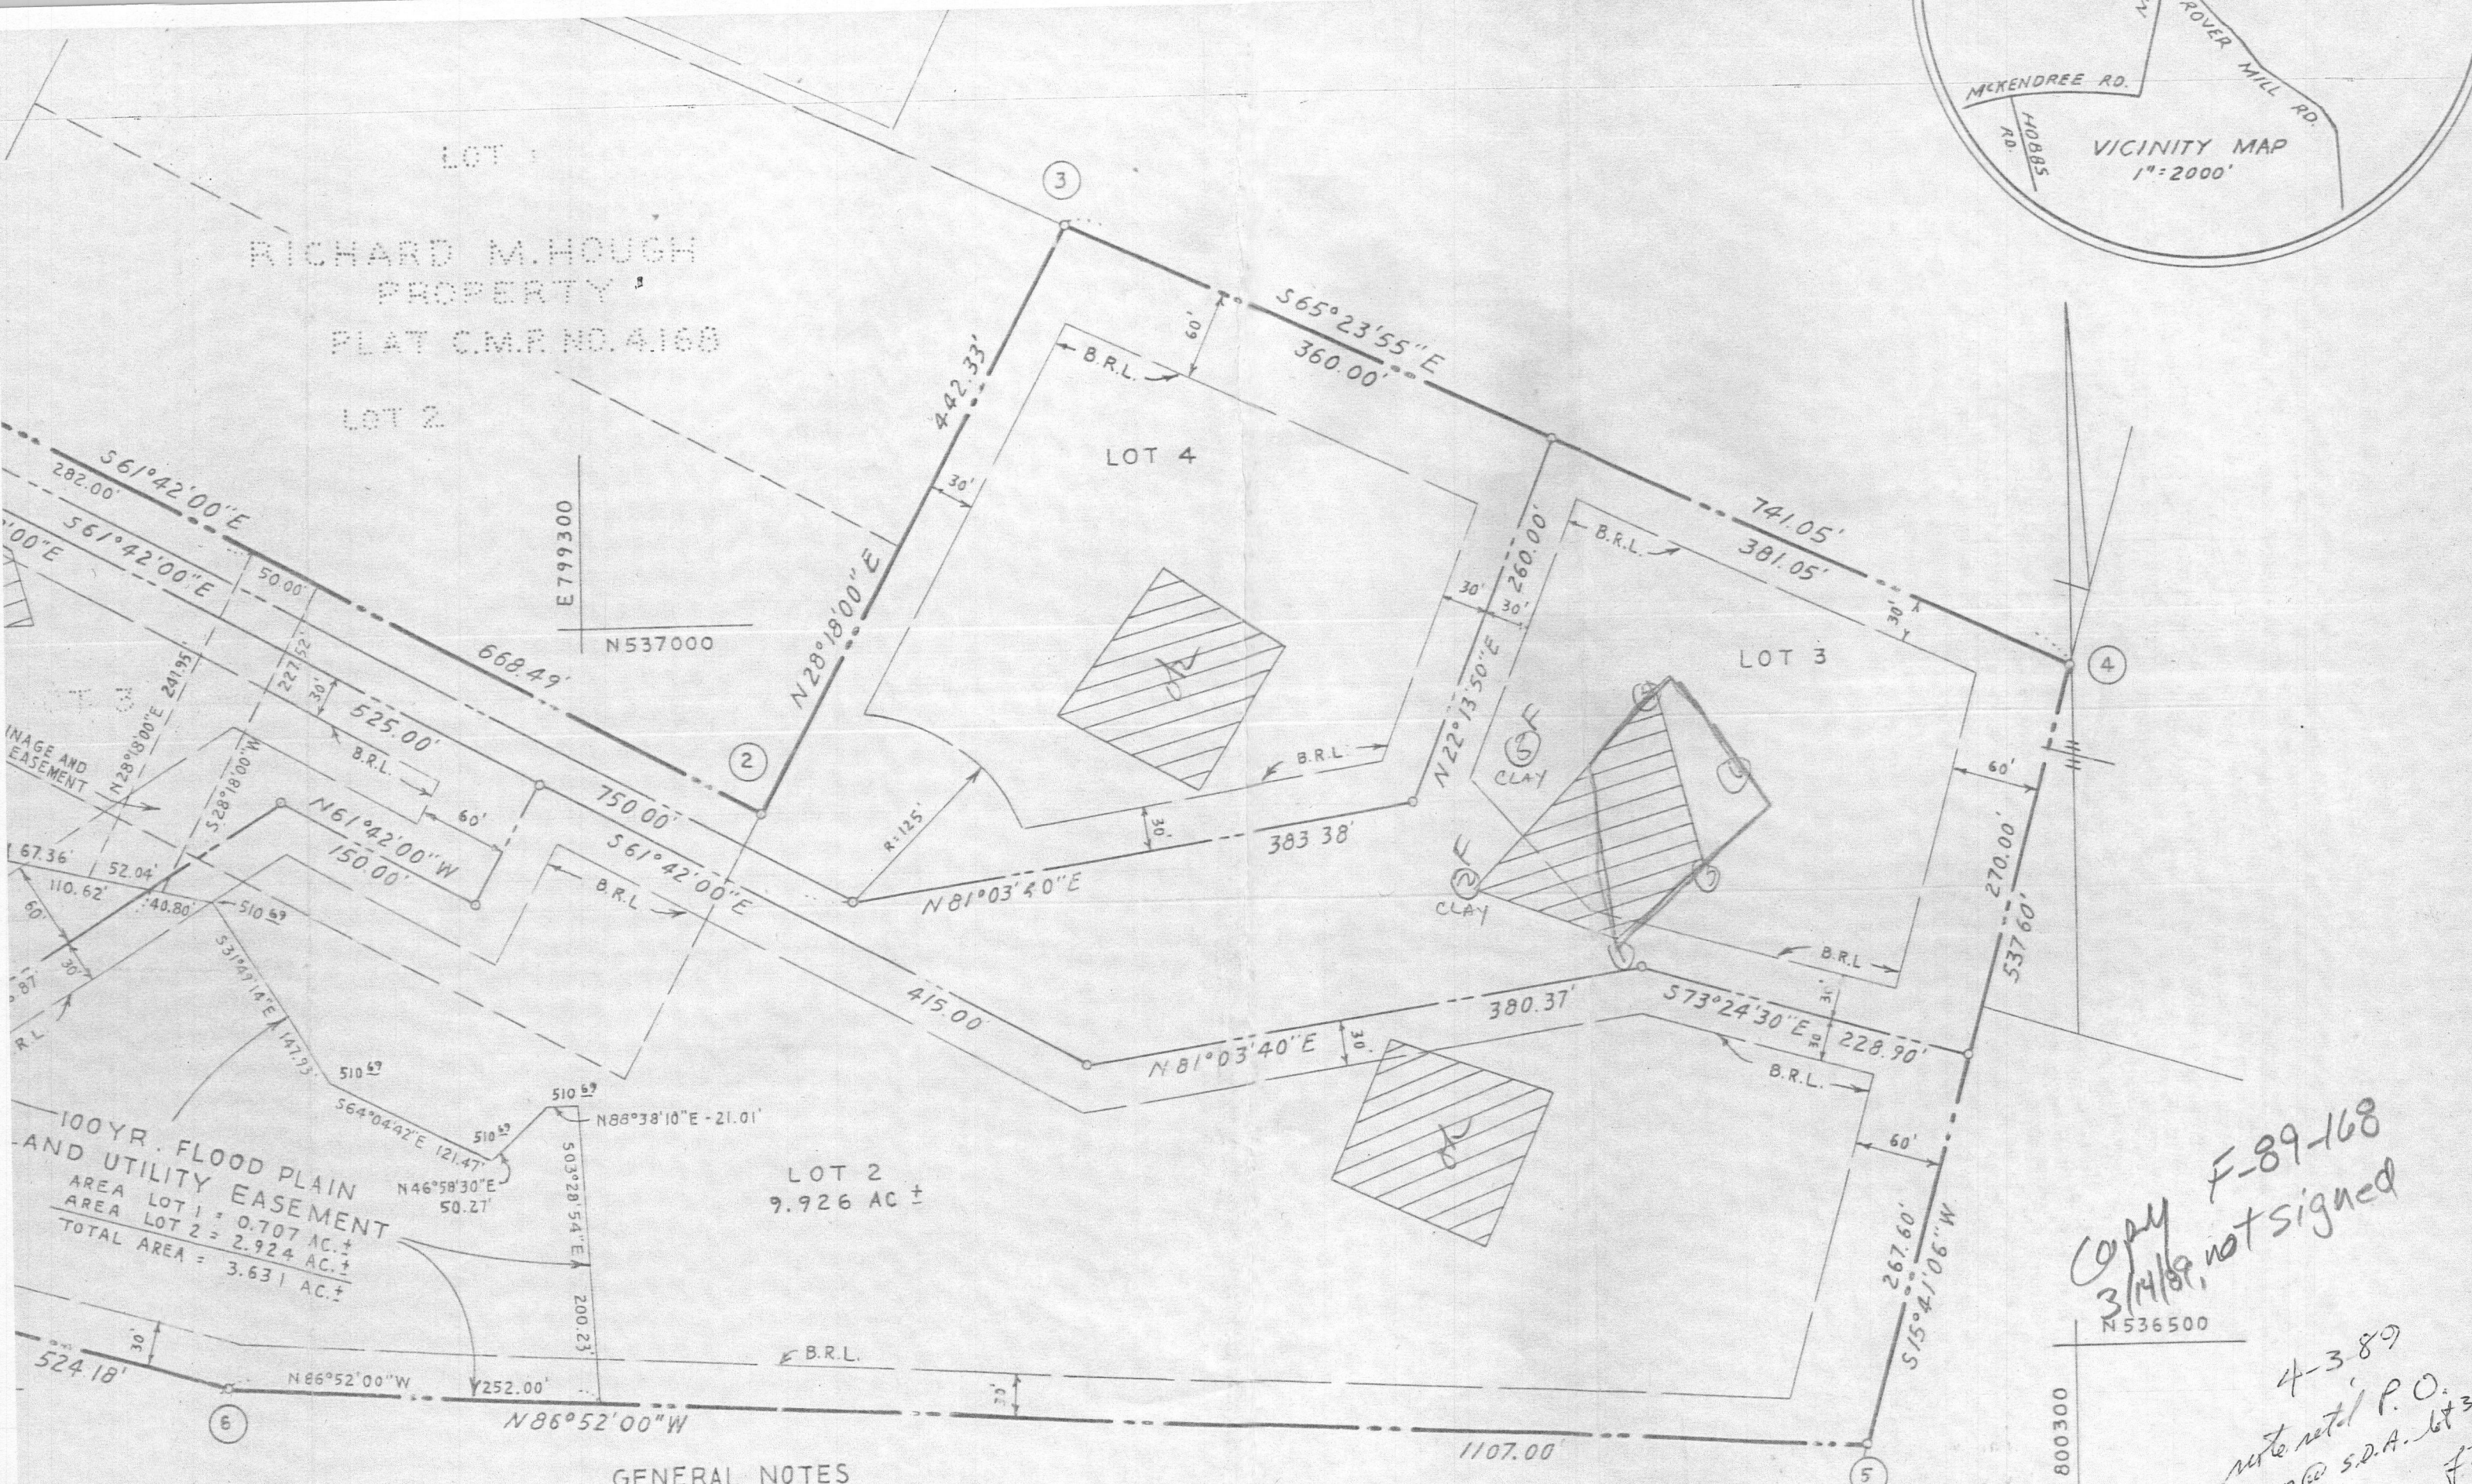

100YR. FLOOD PLAIN  
AND UTILITY EASEMENT  
AREA LOT 1 = 0.707 AC. ±  
AREA LOT 2 = 2.924 AC. ±  
TOTAL AREA = 3.631 AC. ±

LOT 2  
9.926 AC ±

*COPY F-89-168  
3/14/89, not signed  
N536500*

*4-3-89  
note re: P.O.  
app @ S.D.A. lot 3  
FF.*

GENERAL NOTES

1. SUBJECT PROPERTY ZONED R PER 8-2-85 COMPREHENSIVE ZONING PLAN.
2. THE LOTS SHOWN HEREON COMPLY WITH THE MINIMUM OWNERSHIP WIDTH AND LOT AREA AS REQUIRED BY THE MARYLAND STATE DEPARTMENT OF HEALTH AND MENTAL HYGIENE.

5. THIS AREA DESIGNATES A PRIVATE SEWAGE EASEMENT OF APPROXIMATELY 10,000 SQ. FT. AS REQUIRED BY THE MARYLAND STATE DEPARTMENT OF HEALTH AND MENTAL HYGIENE FOR INDIVIDUAL SEWAGE DISPOSAL. IMPROVEMENTS OF ANY NATURE IN THIS AREA ARE RESTRICTED UNTIL PUBLIC SEWAGE IS AVAILABLE AND