

APPLICATION

HOWARD COUNTY PERMIT APPLICATION

SERIAL NUMBER 31060

DEPARTMENT OF INSPECTIONS, LICENSES & PERMITS 3430 COURT HOUSE DRIVE, ELICOTT CITY, MARYLAND 21043

PROPERTY ADDRESS (HOUSE NO., STREET, TOWN OR AREA)

8519

GRADING/SEDIMENT CONTROL YES NO

DESCRIPTION OF WORK AUTHORIZED

CONSTRUCT BASEMENT & PLACE MEDIUM WARE ONE STORY, 3 BR.

LOT NO. PARCEL NO. SEC. AREA BLOCK NO. LIBER FOLIO

SUB DIVISION ZONE ZONE MAP ELEC. DIST. CENSUS TR.

OWNER'S NAME AND ADDRESS PHONE NO.

DONALD AVIT 8519 MURPHY RD

RECIPIENT'S NAME AND ADDRESS PHONE NO.

AGENCY OR ENGINEER'S NAME AND ADDRESS PHONE NO.

CONTRACTOR'S NAME AND ADDRESS PHONE NO.

EXISTING USE PROPOSED USE

EST. CONSTRUCTION COST LICENSE NUMBER PERMIT FEE

W/S CODE FOR OFFICE USE ONLY

DISTANCE IN FEET FROM R/W LINE TO FRONT BUILDING LINE

SIDE YARD (DISTANCE IN FEET FROM SIDE BLDG. LINE TO SIDE PROPERTY LINE)

DISTANCE IN FEET FROM SIDE STREET R/W LINE

TO SIDE BUILDING LINE

DISTANCE IN FEET, REAR YD. REQUIRING SET

BACK CONDITIONS (IF ANY) (CORNER LOT ONLY)

Checks payable to DIRECTOR OF FINANCE OF HOWARD COUNTY

Table with columns: SIZE OF BLDG., FRONT, DEPTH, HEIGHT. Value: 50 X 35

Table with columns: TYPE OF BLDG., AREA, VOLUME, ROOF. Values: B. ROOMS 3, ROOMS 3, BATHS 2, FIREPLACES 1

Table with columns: FOOTINGS, FOUNDATION, S. WALLS

Table with columns: WATER/WELL, SEWER/SEPTIC, GAS, ELECTRICITY, TYPE OF HEAT, AC

I have carefully examined and read this application and know the same is true and correct, and that in doing this work, all provisions of Howard County Ordinances and the State Laws of Maryland will be complied with...

SIGNATURE TITLE DATE

Table for APPROVAL with columns: FUNCTION, DATE, SIGNATURE APPROVAL. Rows include ZONING/PLANNING, SHA, SEDIMENT/GRADING, BUILDING OFFICIAL, WATER & SEWER, HEALTH DEPT., FIRE PROTECTION, STORM WATER MGM.


Distribution of Copies: White - Building Official, Green - Planning & Zoning, Yellow - Engineering, Pink - Health Dept., Gold - S.H.A.

LP-69 Revised

IMPORTANT: PLEASE SHOW ZIP CODES AND AREA CODES WHEREVER REQUIRED.

cc: Ms. Avis Corbin, Chief Department of Licenses and Permits Foremost Industries File

Handwritten signature and date: 2/9/90

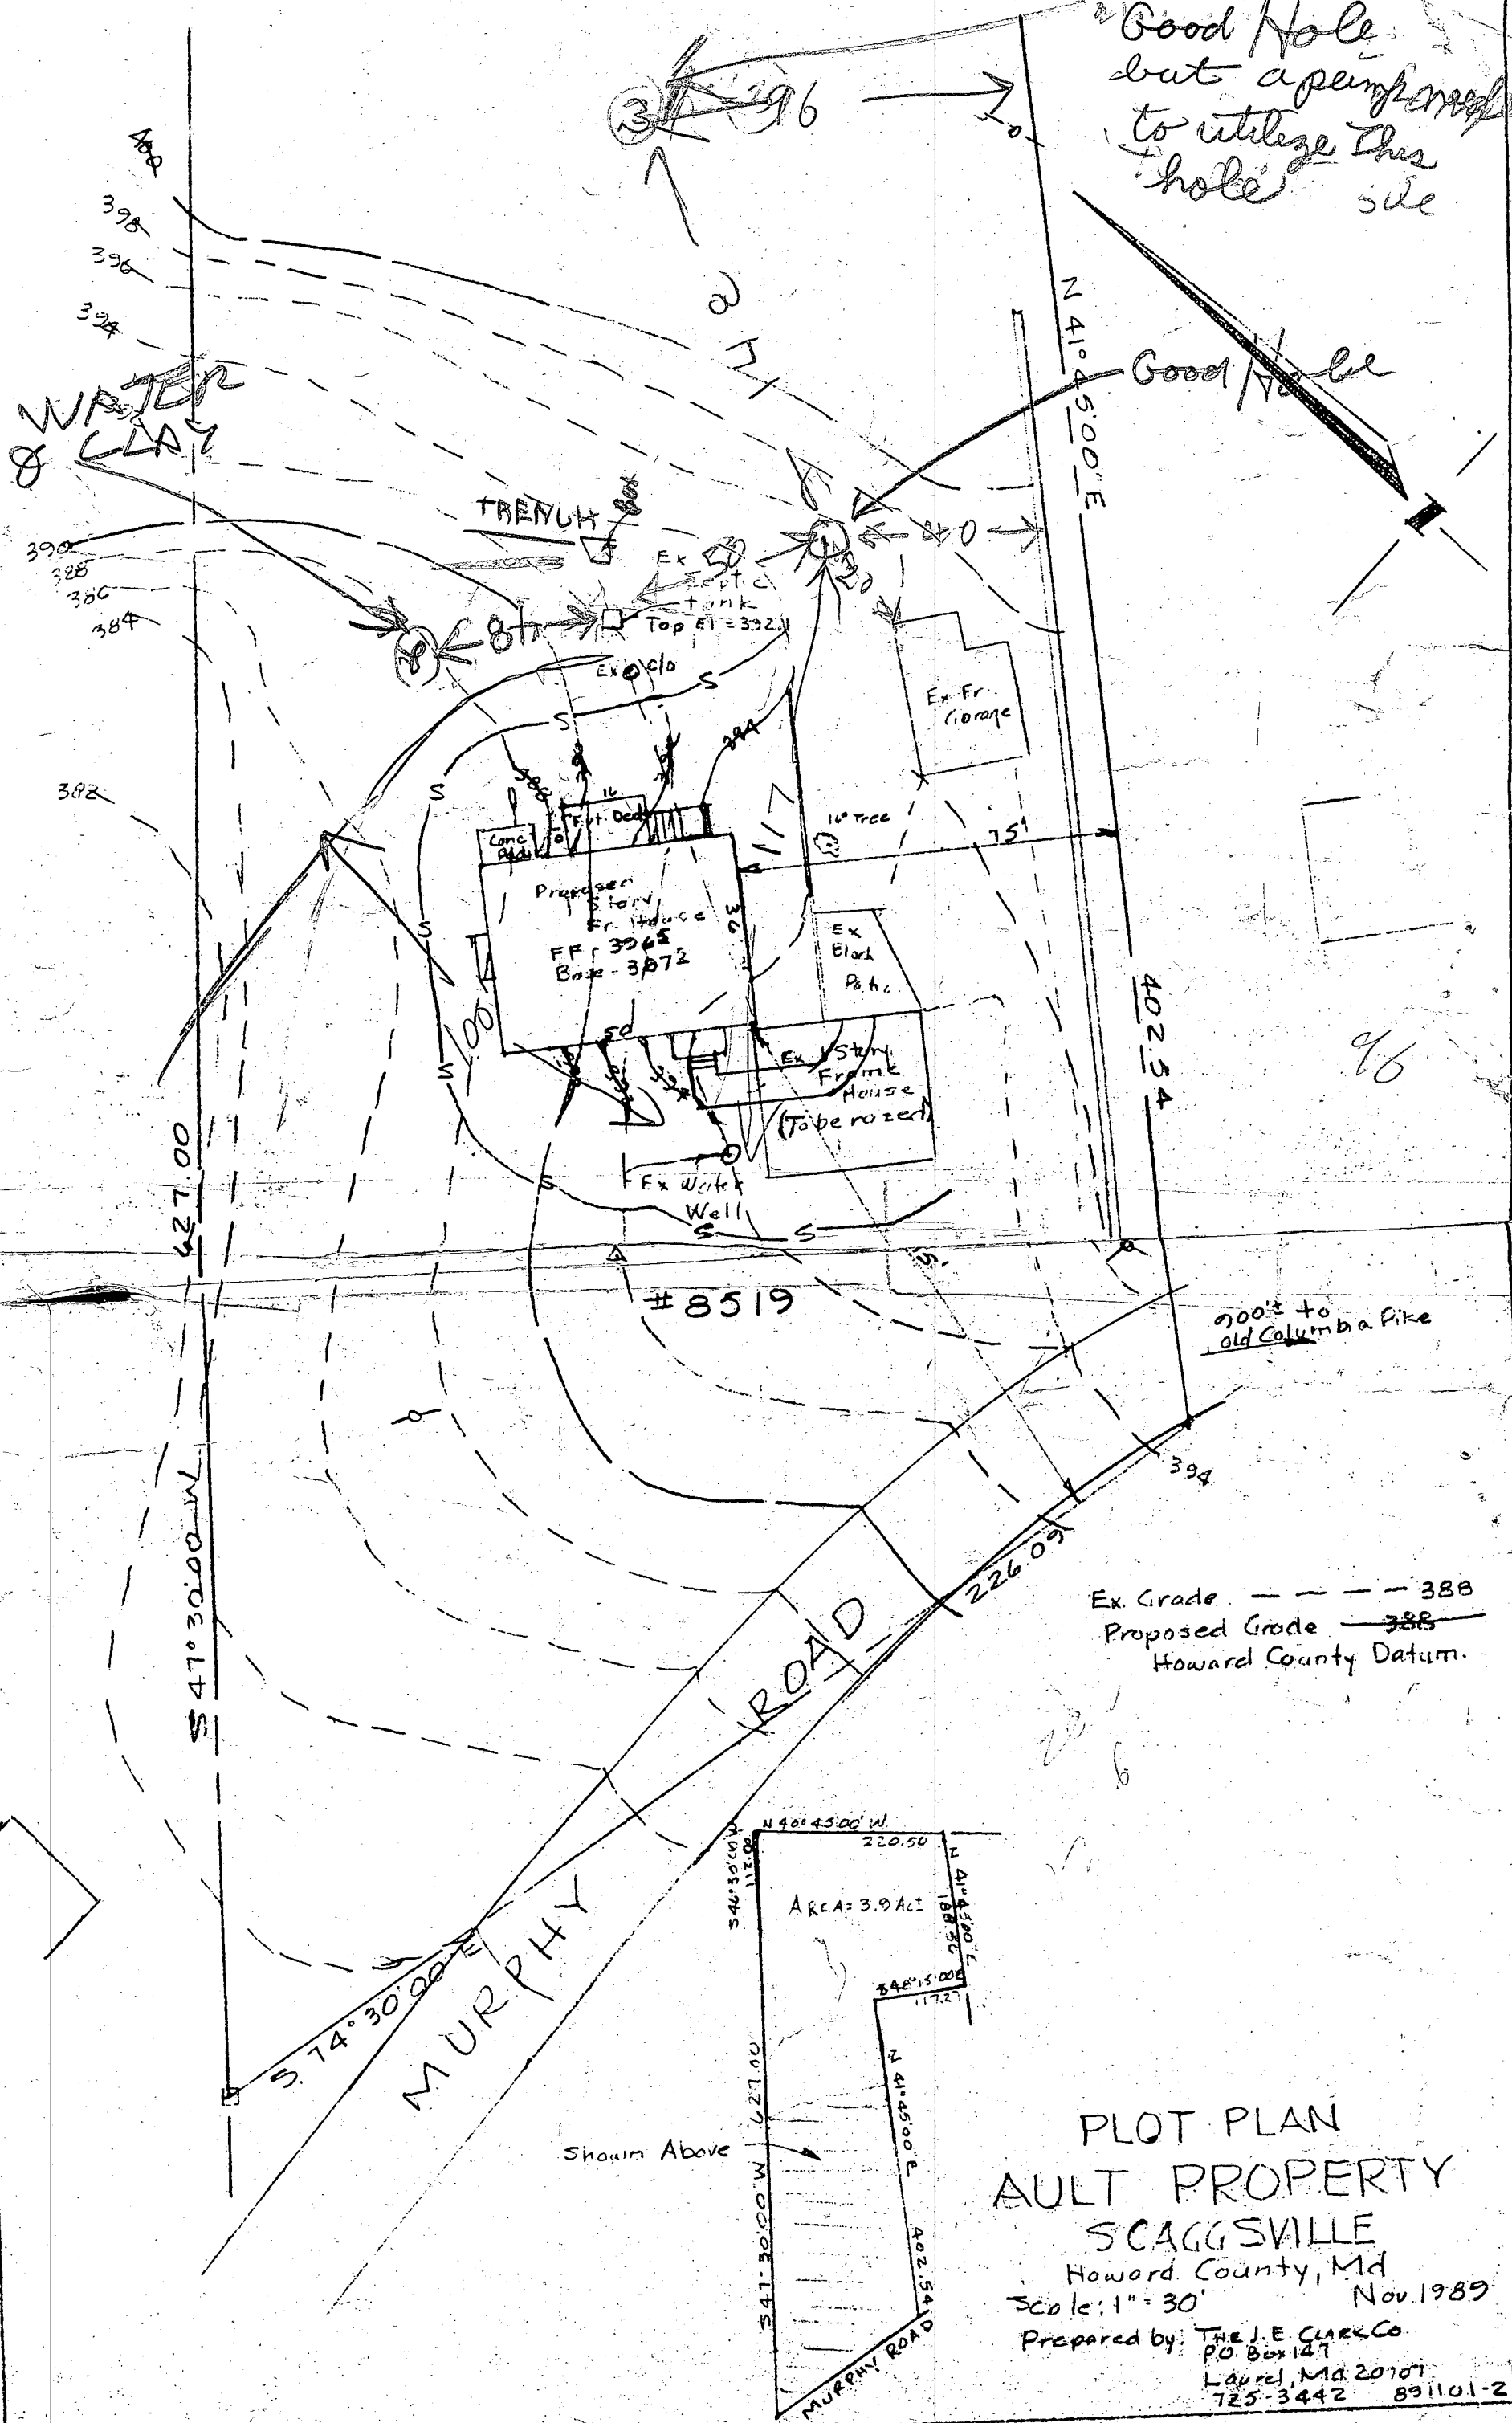

Good Hole
but a pump needed
to utilize this
hole side

Good Hole

WATER & CLAY

TRENCH

Ex. Septic Tank
Top El = 392.1

Proposed Story Fr. House
FF = 3265
Base = 3272

Ex. Black P.H.

Ex. Stone Frame House
(To be razed)

#8519

700'± to
old Columbia Pike

Ex. Grade - - - - - 388
Proposed Grade ——— 388
Howard County Datum.

PLOT PLAN
AULT PROPERTY
SCAGGSVILLE
Howard County, Md
Scale: 1" = 30'
Nov. 1989

Prepared by: THE J.E. CLARK CO.
P.O. Box 147
Laydel, Md. 20707
725-3442 891101-2



HOWARD COUNTY HEALTH DEPARTMENT

Joyce M. Boyd, M.D., County Health Officer

January 30, 1990

Reply to:

Mr. Donald Ault
8519 Murphy Road
Laurel, Maryland 20707

RE: Building Permit Application
Serial Number: 31060
Proposed Replacement Dwelling
8519 Murphy Road

Dear Mr. Ault:

This is to advise that this office cannot complete the review of the above referenced building permit application at this time.

In order to approve this application, we would need to be satisfied that adequate well and septic conditions exist.

Please contact this office to provide any information you may have regarding the location and the condition of the well and septic system. Unless additional information can be provided, a percolation repair inspection (permit fee \$10.00), would be required to determine the condition of the existing system and to determine that adequate soil conditions exist for future repair of the system.

If you have any questions regarding this matter, or wish to arrange for the repair inspection, please contact this office at 461-9933.

Very truly yours,

Craig Williams, Director
Water and Sewerage Program

CW:JR

cc: Ms. Avis Corbin, Chief
Department of Licenses and Permits
Foremost Industries
File

REPAIR AND ESTABLISH
OK TO PROCEED -
2/9/90 CW