


NOTE: THIS LOCATION IS FOR SETTLEMENT PURPOSES ONLY AND WAS PREPARED WITHOUT THE BENEFIT OF A CURRENT TITLE REPORT. PROPERTY IS SUBJECT TO ANY AND ALL EASEMENTS, RIGHTS-OF-WAY, COVENANTS AND RESTRICTIONS, ETC. OF RECORD. THIS IS NOT A BOUNDARY SURVEY AND IS NOT TO BE USED FOR DETERMINING PROPERTY LINES.

LOCATION OF HOUSE
 "ADAMS REACH"
 SEC. 2, LOT 21
 5525 ADAMS RIDGE ROAD
 HOWARD COUNTY,
 MARYLAND

FLOOD PLAIN CERTIFICATION

I Herby Certify that, to the best of my knowledge, information and belief, the property shown hereon lies within Zone C (area of minimal flooding) as shown on the F.E.M.A. Flood Insurance Rate Map, Community Panel No. 240044 0032 B, revised December 4, 1986..

7/1/96
 proposed deck as shown should not impact existing well or septic system.
 DWG & SEE

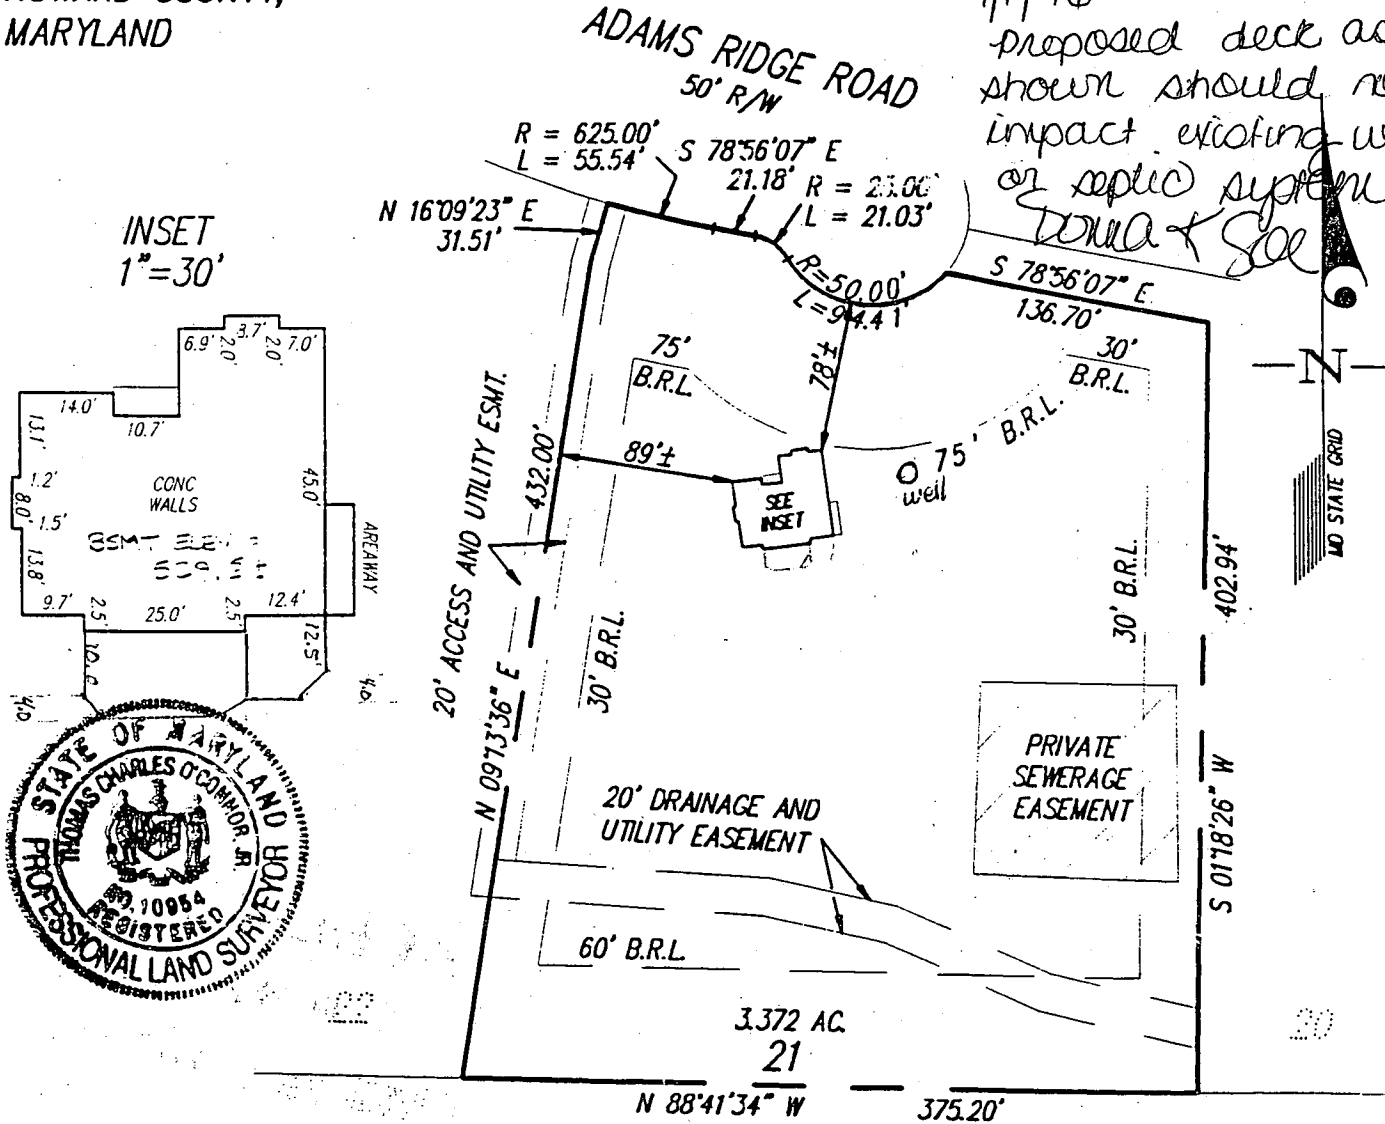

SURVEYOR'S CERTIFICATE

I hereby certify that to the best of my knowledge, information and belief, the positions of all visible existing improvements on the above described property have been established by accepted field practices and that unless otherwise shown, there are no encroachments.

TC 7.12.94

For Gutschick, Little and Weber, P.A.
 Thomas C. O'Connor, Jr., Professional Land Surveyor, No. 10954



GUTSCHICK, LITTLE & WEBER, P.A.

CIVIL ENGINEERS, SURVEYORS, PLANNERS, LANDSCAPE ARCHITECTS
 3909 NATIONAL DRIVE - SUITE 250 - BURTONSVILLE OFFICE PARK
 BURTONSVILLE, MARYLAND 20886
 TEL: (301) 421-4024 MD. VA.: (301) 989-2524 BALT.: (301) 880-1820 FAX: (301) 421-4186

REFERENCE :	PLAT No. 10575	RECORD:
SURVEY DATES: WALL CK. 7-07-94 FINAL:		
MIN. YARDS: FRONT: 75' SIDE: 30' REAR: 60'		G.L.W. FILE No.
DRAWN BY: DES/CAD	DATE: 7-11-94	94052
CHECKED BY: <i>TC</i>	SCALE: 1"=100'	