

ISSUE DATE:

4/6/2001

PERMIT INDEXED

P 515 030-B

APPROVAL DATE:

6/25/01

A 49888-X

ON-SITE SEWAGE DISPOSAL SYSTEM HOWARD COUNTY HEALTH DEPARTMENT BUREAU OF ENVIRONMENTAL HEALTH

04-357442

Jack Fyock Septic Systems

IS PERMITTED TO INSTALL ALTER

ADDRESS: P. O. Box 89, Glenelg, MD 21737 PHONE NUMBER: (410) 988-9270

SUBDIVISION: Harless Manor LOT NUMBER: 11

ADDRESS: 14041 Monticello Drive PROPERTY OWNER: Cornerstone Homes

SEPTIC TANK CAPACITY (GALLONS): 1250 (TOP SEAM)

PUMP CHAMBER CAPACITY (GALLONS): 1250 "

NUMBER OF BEDROOMS: 4

SQUARE FEET PER BEDROOM: 180

LINEAR FEET OF TRENCH REQUIRED: 240

TRENCHES:	Trench to be 2.0 feet wide. Inlet 3.0 feet below original grade. Bottom maximum depth 6.0 feet below original grade. Effective area begins at 3.0 feet below original grade. 3.0 feet of stone below distribution pipe.
LOCATION:	Begin trenches 150 feet down the right lot line and 10 feet off that same lot line as seen when facing the lot from Monticello Drive. Run trenches on contour toward the rear lot line.
NOTES:	

PLANS APPROVED: Amy Mc Millen OK SRU 3/9/01 DATE: 3-7-01

NOTE: PERMIT VOID AFTER 2 YEARS

NOTE: CONTRACTOR RESPONSIBLE FOR SCHEDULING A PRE-CONSTRUCTION INSPECTION FOR ALL INSTALLATIONS

NOTE: WATERTIGHT SEPTIC TANKS REQUIRED

NOTE: ALL PARTS OF SEPTIC SYSTEM SHALL BE 100 FEET FROM ANY WATER WELL

NOTE: MANHOLE RISERS REQUIRED ON ALL SEPTIC TANKS AND PUMP CHAMBERS

**NEITHER THE HOWARD COUNTY COUNCIL NOR THE HEALTH DEPARTMENT IS
RESPONSIBLE FOR THE SUCCESSFUL OPERATION OF ANY SYSTEM**


**PERMITTEE RESPONSIBLE FOR OBTAINING FINAL APPROVAL ON THIS PERMIT
CALL 410-313-2640 FOR INSPECTION OF SEPTIC SYSTEM**

**BUILDING PERMIT SIGNED
AND RETURNED**

1-1603 800141278-DECK

515030-B

NOT TO SCALE

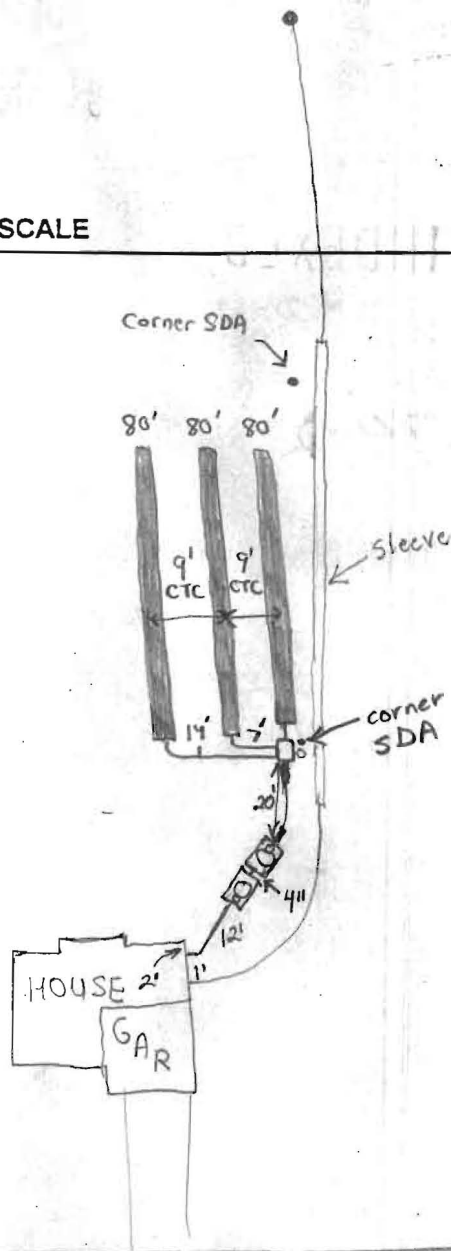

TRENCH DATA

TRENCH WIDTH 2'
 TRENCH INLET DEPTH 3'
 TRENCH BOTTOM DEPTH 6'
 DEPTH OF STONE 3'
 NUMBER OF TRENCHES 3
 TOTAL TRENCH LENGTH 240'
 ABSORBENT AREA 720 ft²
 DISTRIBUTION BOX LEVEL
 BAFFLE IN DISTRIBUTION BOX NA

SEPTIC TANK DATA

SEPTIC TANK 1250 TS GALLONS
 MANHOLE RISER Yes
 6 INCH INSPECTION PORT Yes

PUMP CHAMBER DATA

PUMP CHAMBER GALLONS 1250 TS
 MANHOLE RISER Yes + 6" cleanout
 ALARM _____
 PUMP PERFORMANCE TEST _____

PRE-CONSTRUCTION INSPECTION: 5/10/01 - OK TO INSTALL D-BOX AS SHOWN ON PLAN & RUN TRENCHES AS SHOWN ON PLAN - (SRK)

INSPECTION COMMENTS: 5/22/01 - OK TO COVER TRENCHES & CONTINUE WORK (SRK) 5/23/01
O.K. to cover system. Final approval after satisfactory pump and alarm test. (BB) Pump Test (Hi/Low Floats) + Alarm work OK. P/P 6/25/01

BUILDING PERMIT SIGNED
 AND RETURNED

INSPECTOR Donald W. [Signature] DATE SYSTEM APPROVED 6/25/01

