

LAYOUT _____ INSP 4 _____
INSP 2 _____ INSP 5 _____
INSP 3 _____ INSP 6 _____

ISSUE DATE: _____

PERMIT

P 22234

APPROVAL DATE: 11/7/75

A 520001-A

**ON-SITE SEWAGE DISPOSAL SYSTEM
HOWARD COUNTY HEALTH DEPARTMENT
BUREAU OF ENVIRONMENTAL HEALTH**

04-324765

IS PERMITTED TO INSTALL ALTER

ADDRESS: _____ PHONE NUMBER: _____

SUBDIVISION: FORSYTHE ESTATES LOT NUMBER: 9-D

ADDRESS: 14600 MONTICELLO DRIVE PROPERTY OWNER: THOMAS G OYSTER

SEPTIC TANK CAPACITY (GALLONS): _____ OUTLET BAFFLE FILTER REQUIRED

PUMP CHAMBER CAPACITY (GALLONS): _____ COMPARTMENTED TANK REQUIRED

NUMBER OF BEDROOMS: _____

SQUARE FEET PER BEDROOM: _____

LINEAR FEET OF TRENCH REQUIRED: _____

TRENCHES:	Trench to be _____ feet wide. Inlet _____ feet below original grade. Bottom maximum depth _____ feet below original grade. Effective area begins at _____ feet below original grade. _____ feet of stone below distribution pipe.
LOCATION:	BUILDING PERMIT SIGNED AND RETURNED
NOTES:	11/6/2003 B00144981 PORCH

PLANS APPROVED: _____ DATE: _____

- NOTE: PERMIT VOID AFTER 2 YEARS
- NOTE: CONTRACTOR RESPONSIBLE FOR SCHEDULING A PRE-CONSTRUCTION INSPECTION FOR ALL INSTALLATIONS
- NOTE: WATERTIGHT SEPTIC TANKS REQUIRED
- NOTE: ALL PARTS OF SEPTIC SYSTEM SHALL BE 100 FEET FROM ANY WATER WELL
- NOTE: MANHOLE RISERS REQUIRED ON ALL SEPTIC TANKS AND PUMP CHAMBERS UNLESS SPECIFICALLY AUTHORIZED

**NEITHER THE HOWARD COUNTY COUNCIL NOR THE HEALTH DEPARTMENT IS
RESPONSIBLE FOR THE SUCCESSFUL OPERATION OF ANY SYSTEM
PERMITTEE RESPONSIBLE FOR OBTAINING FINAL APPROVAL ON THIS PERMIT
CALL 410-313-2640 FOR INSPECTION OF SEPTIC SYSTEM**

4520001-A

11/7/75
before 12 noon
if possible

Hold for call 11/7/75 P.O. O.C. 25

PERMIT

P 22234
A 21802

SEWAGE DISPOSAL SYSTEM

MARYLAND STATE DEPARTMENT OF HEALTH

HOWARD COUNTY

ELLICOTT CITY

DISTRICT 4

INDEXED

DATE 10/3/75

Edward Pickett IS PERMITTED TO INSTALL ALTER

ADDRESS Watawville Road, Nr. Aisy, Md. PHONE 828-0543

A SEWAGE DISPOSAL SYSTEM LOCATED AT _____

SUBDIVISION (ESTATE) (Forsythe Estates) ROAD 14600 off Monticello Drive LOT 9 D

PROPERTY OWNER Charles T. Brown

ADDRESS _____

SPECIFICATIONS - 3 bedrooms

DRAIN FIELD _____ DEPTH _____ FEET, BOTTOM AREA _____ SQ. FT.

SEEPAGE PITS _____ ABSORBENT SIDE-WALL AREA _____ SQ. FT.

SEPTIC TANK CAPACITY 1,000 GALLONS

FOR GARBAGE GRINDER, INCREASE DISPOSAL AREA 25% & TANK CAPACITY 50%.

OTHER Dry well to have 100 sq. ft. absorbent sidewall area and located 125 ft. from lot to right-of-way, 75 ft. from 192 ft. lot line, inlet 4 ft. below grade, maximum depth of dry well 9 ft. below original grade. Trench - 3 ft. earth buffer between dry well and trench. Trench to run towards 125 ft. lot line. Inlet 4 ft. below grade, maximum depth 9 ft. with 5 ft. stone, 50 ^{ft.} long. Call for inspection of trench before installing any gravel in trench.

PLANS APPROVED BY D. J. O'Neill DATE 6/16/75

NOTE: ALL PIPE FROM HOUSE TO DISPOSAL AREA MUST BE CAST IRON.


FILL SEPTIC TANK AND DISTRIBUTION BOX WITH WATER BEFORE CALLING FOR AN INSPECTION. COVER NO WORK UNTIL INSPECTED AND APPROVED.
PERMIT VOID AFTER THREE YEARS.

NEITHER THE HOWARD COUNTY COMMISSIONERS NOR THE HEALTH DEPARTMENT IS RESPONSIBLE FOR THE SUCCESSFUL OPERATION OF ANY SYSTEM.

NOTE: INSTALL STAND PIPE ON SEPTIC TANK AND DRY WELL. STAND PIPES MUST BE 6" IN DIA., CAST IRON, CONCRETE OR TERRA COTTA ACCEPTED.

A 21502

A21502

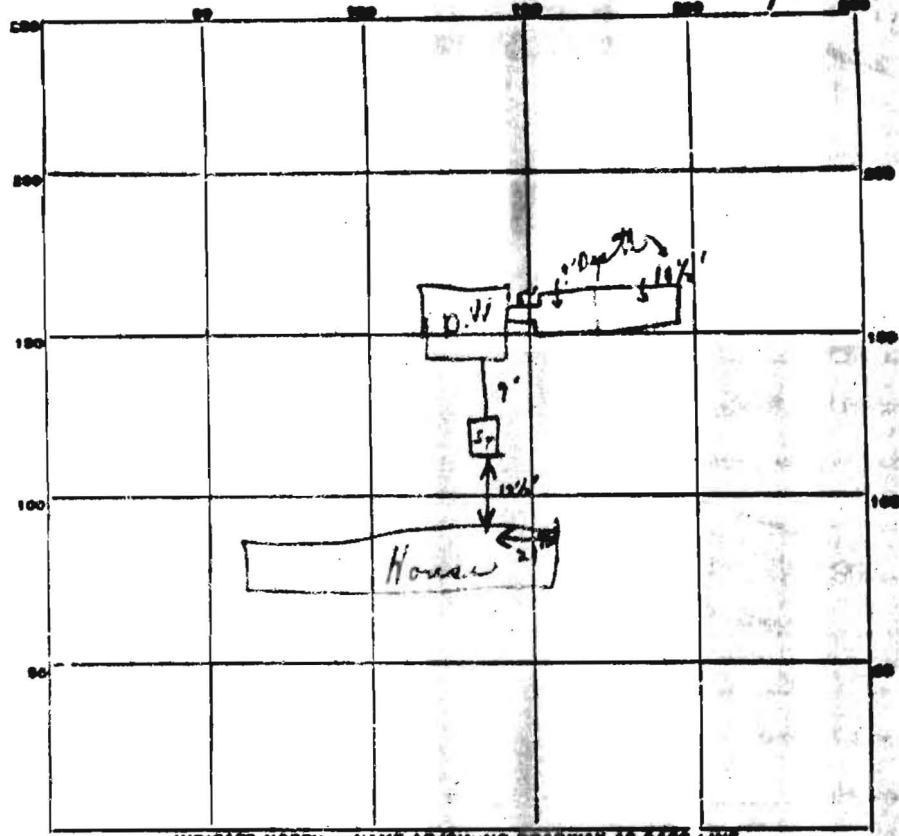

INDICATE NORTH - NAME ADJOINING ROADWAY AS CASE LINE.

add
3' study
6/10/75

PERMIT CARD Year RCD S.T. 1 D.W. 1

SEPTIC TANK, LEVEL ok CLEANOUTS No / No

DISTRIBUTION BOX, LEVEL ←

TILE FIELD, DEPTH _____ FT. TRENCH WIDTH 2 1/2 FT.

GRAVEL DEPTH 2' TOTAL LENGTH 52 FT.

NUMBER OF TRENCHES 1 TOTAL SEPTIC AREA 364

SEEPAGE PITS, INSIDE DIAMETER 40 FT. DEPTH BELOW INLET 0' FT.

ABSORBENT AREA 240 SQ. FT.

REMARKS 11/4/75 Dry well not finished - no gravel all
was counted + look up from house to dry well
Trench d for gravel. C.B.D.

DATE SYSTEM APPROVED _____ INSPECTOR W/01/75